


HOUSE DETAIL



N.T.S.

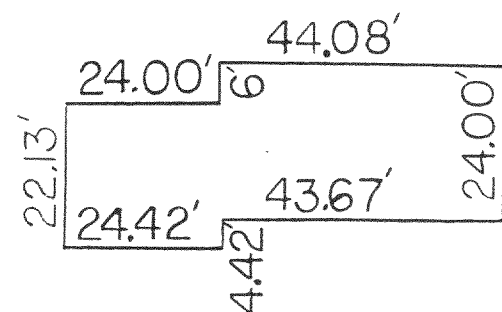

SOIL TYPE
PsB(PLANO SILT LOAM)

ADDRESS
N5602 BOWERS RD.
ELKHORN, WI 53121

PARCEL #
KA46700001

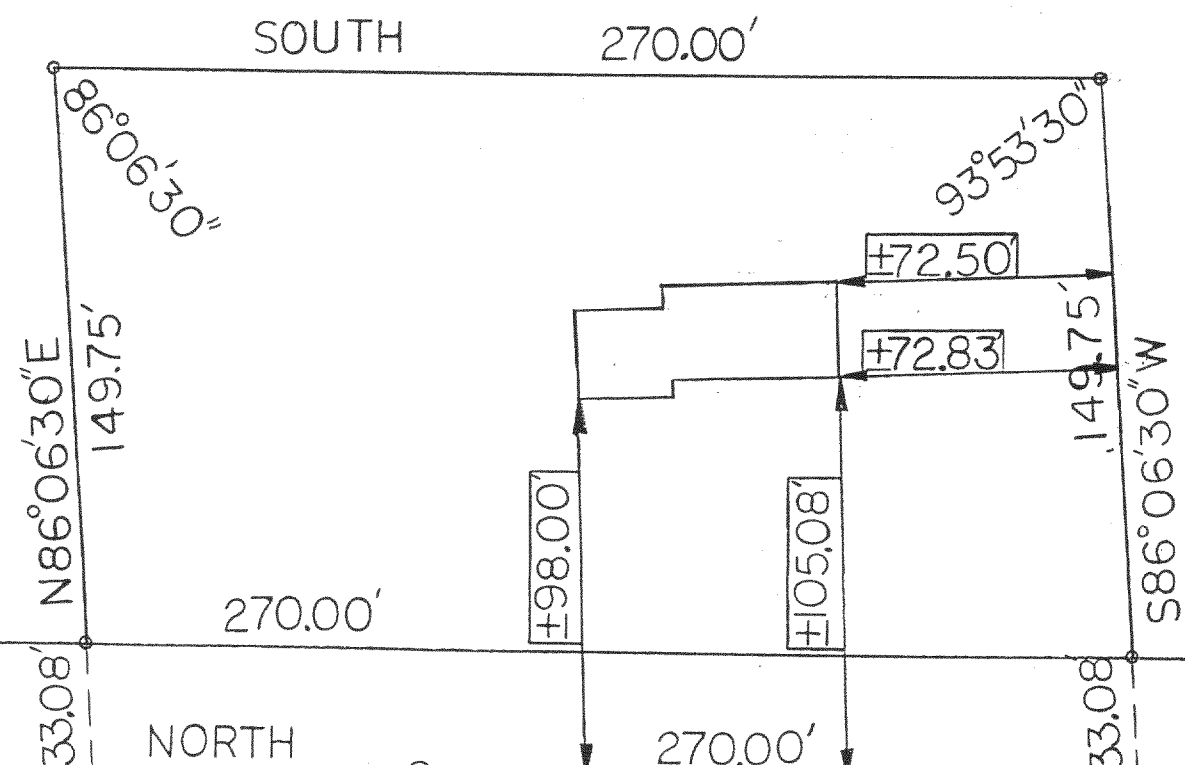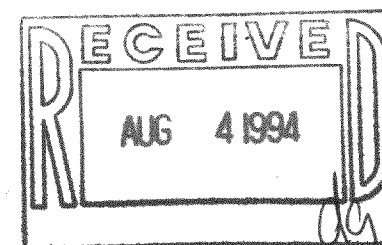

BOWERS

ROAD (PUBLIC ROAD 66.00' WIDE)

NORTH 1185.37'
PLACE OF BEGINNING


(PUBLIC ROAD 66.00' WIDE)

S.T.H. "11"

LEGEND:

- LOT CORNER
- CONC. MONUMENT; BRASS TOP (W/ CROSS)
- NAIL SET IN ASPHALT PVMT.

WEST 1/4
CORNER SECTION
25.T.3N., R.17E

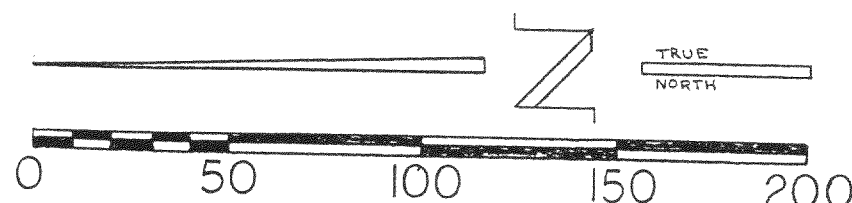

317-324