



PLAT OF SURVEY

Lot 1 of Certified Survey Map Number 2755, as recorded in Volume 14 on Pages 129, 130, and 131 of Certified Survey Maps, being a part of the Southeast 1/4 of the Southwest 1/4 of Section 28, Township 3 North, Range 17 East of the Fourth Principal Meridian in the Town of Lafayette, County of Walworth and State of Wisconsin.

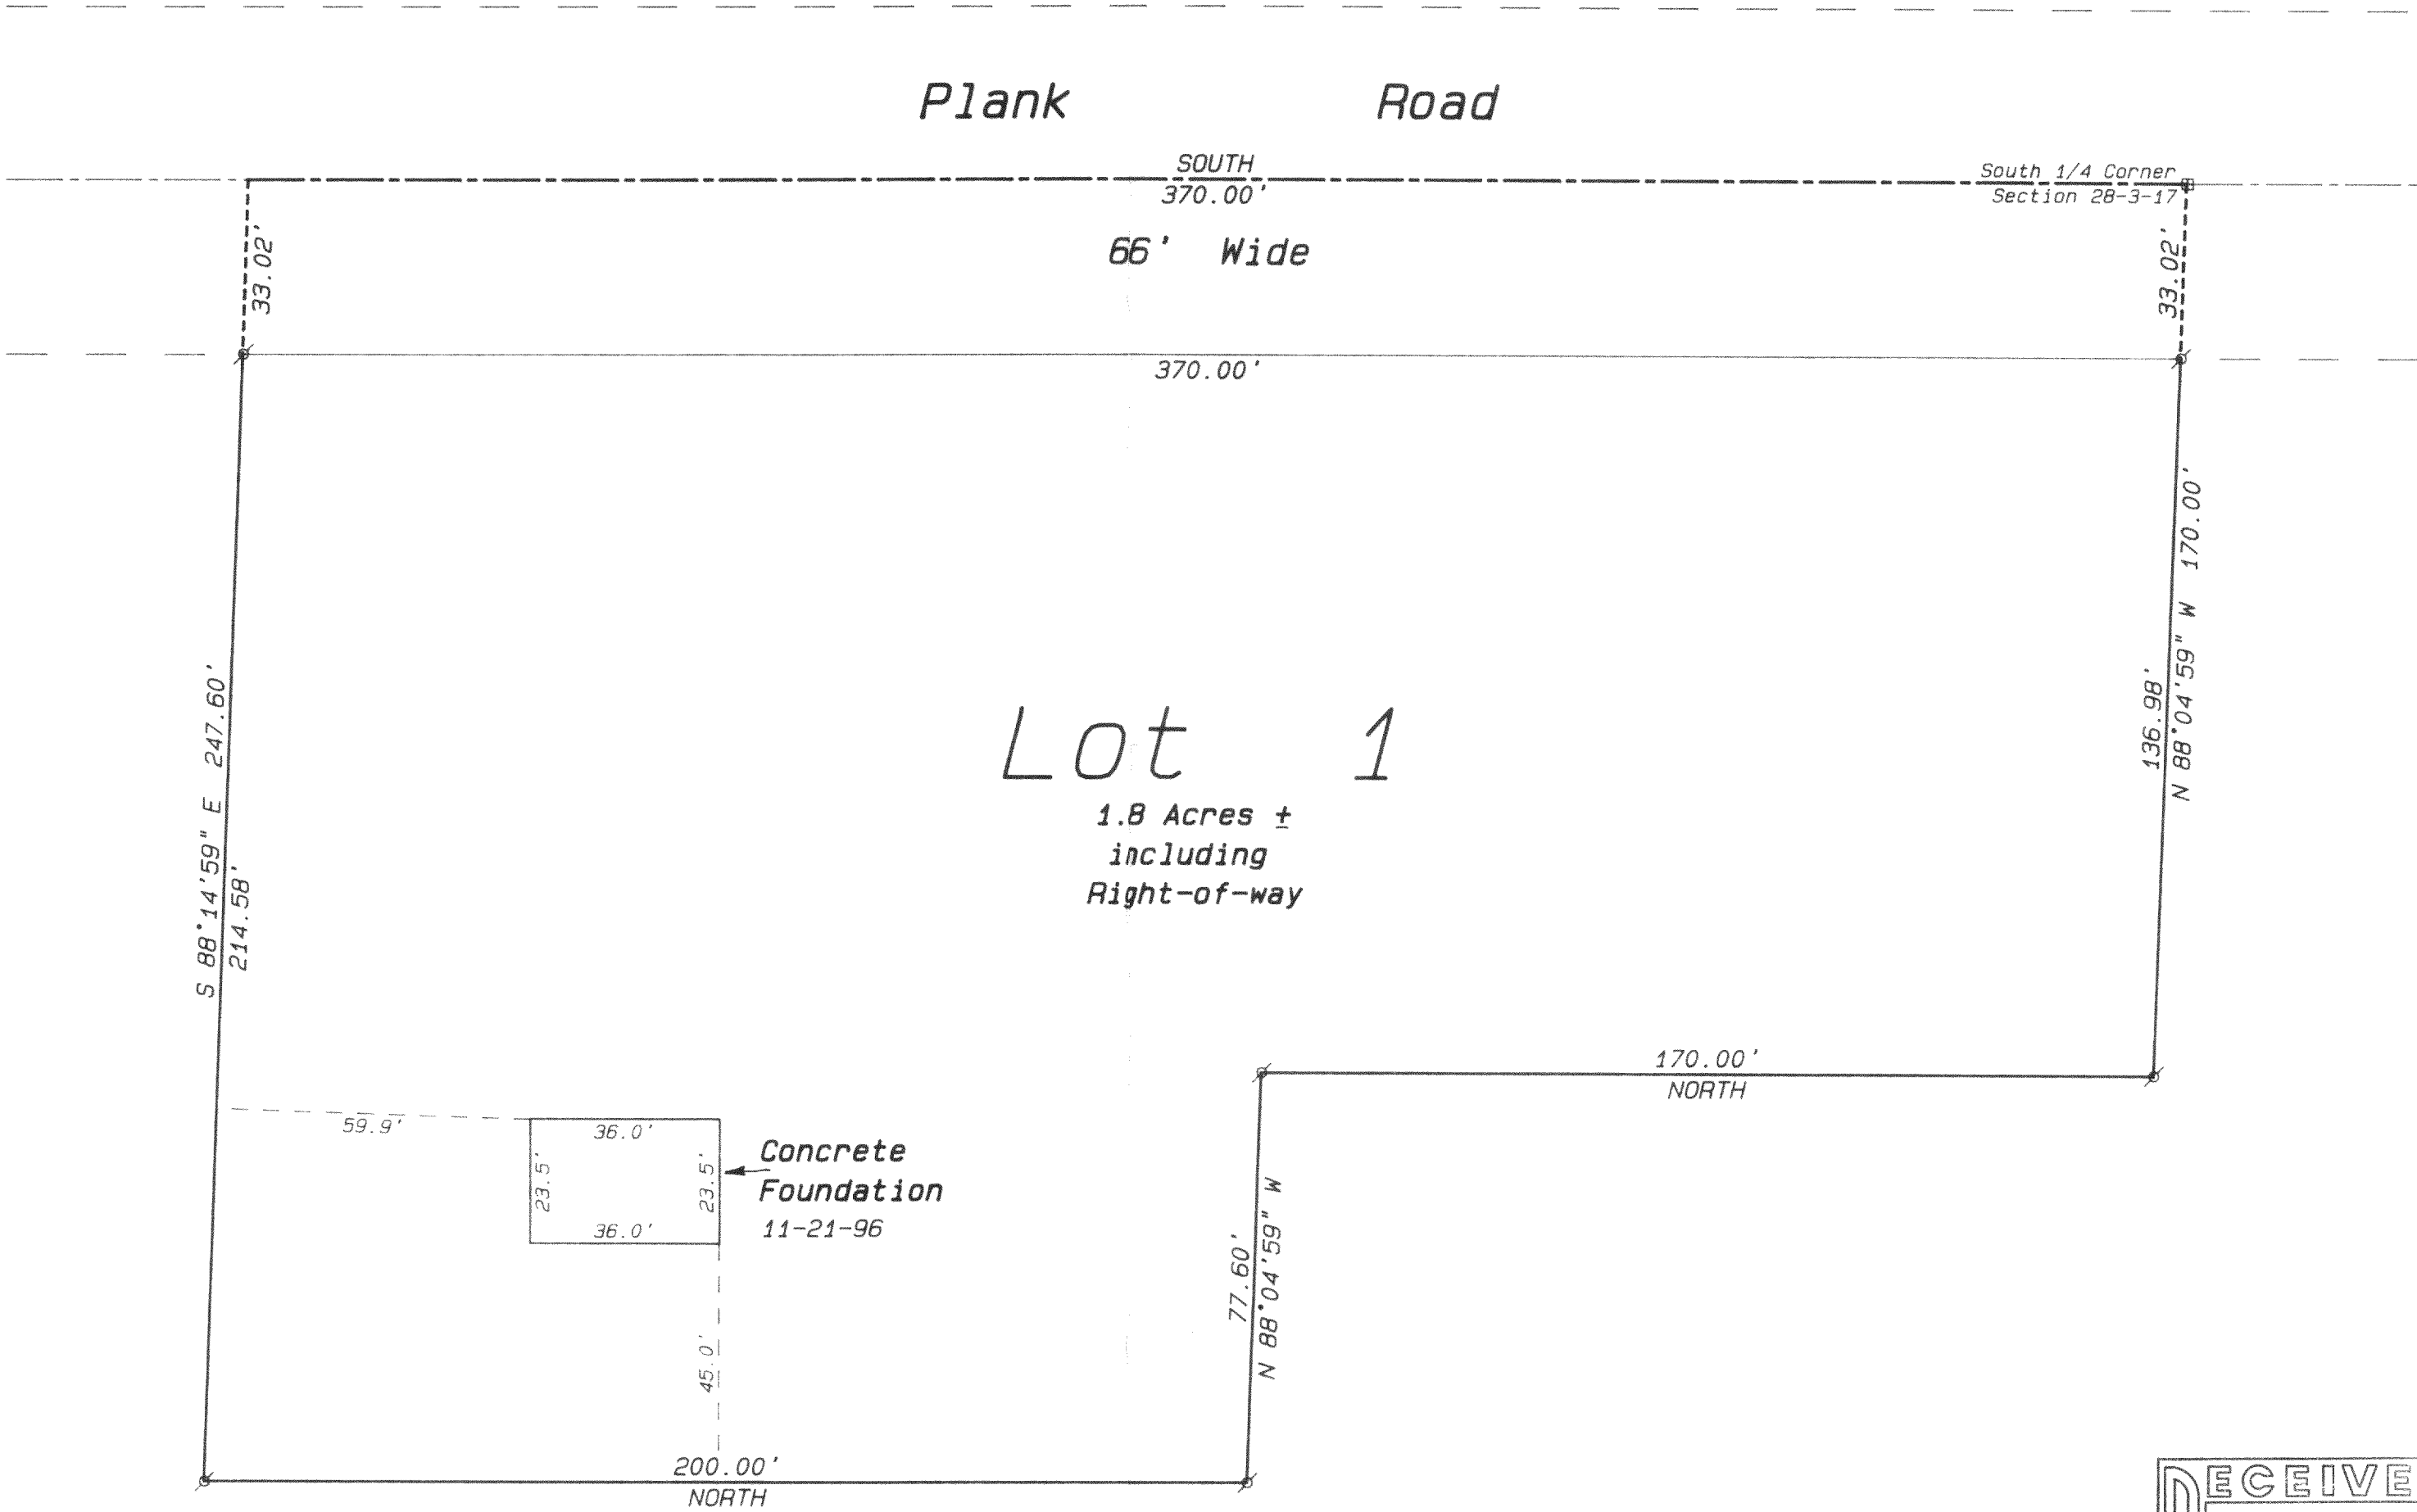


- Legend**
- FOUND IRON PIPE
 - FOUND IRON ROD
 - FOUND BRASS CAPPED MONUMENT
 - FOUND CONCRETE MONUMENT
 - CHISEL CUT IN CONCRETE
 - SET IRON ROD, 24" LONG, WEIGHING 1.5 LBS., LINEAL FT., 3/4" DIA.
 - SET IRON ROD, 30" LONG, WEIGHING 4.5 LBS., LINEAL FT., 1-11/16" DIA.
 - (XX) RECORDED AS DIMENSION
 - EXISTING FENCE

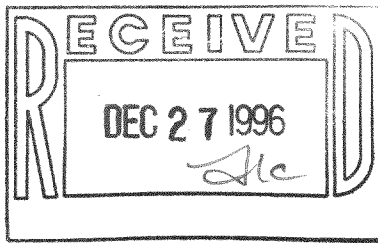

SCALE: 1" = 30 FEET

Ordered by: Amy Schwarz
Schauder Building, Inc.
4115 Highway 51 North
Janesville, Wisconsin 53545-9574

Owner: Kenneth J. Frederick
415 West Court Street
Elkhorn, Wisconsin 53121

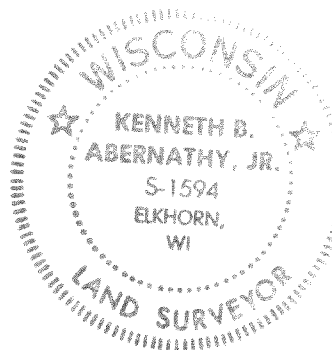

Kenneth B. Abernathy, Jr.
KENNETH B. ABERNATHY, JR.
WISCONSIN REGISTERED LAND SURVEYOR,
S-1594
Date: December 2, 1996 Job No. 1996.1109