

ABERNATHY and ASSOCIATES



Kenneth B. Abernathy Jr.

Wisconsin Registered Land Surveyor S-1594

W4056 Bray Road
Elkhorn, Wisconsin 53121
Phone (414) 723-4260 (office)
(414) 723-4813 (residence)

PLAT OF SURVEY

Lot 2 of Certified Survey Map Number 2068,
located in part of the Northeast 1/4 of the
Southwest 1/4 of Section 19, Town 3 North,
Range 17 East, Town of LaFayette, County of
Walworth, State of Wisconsin.

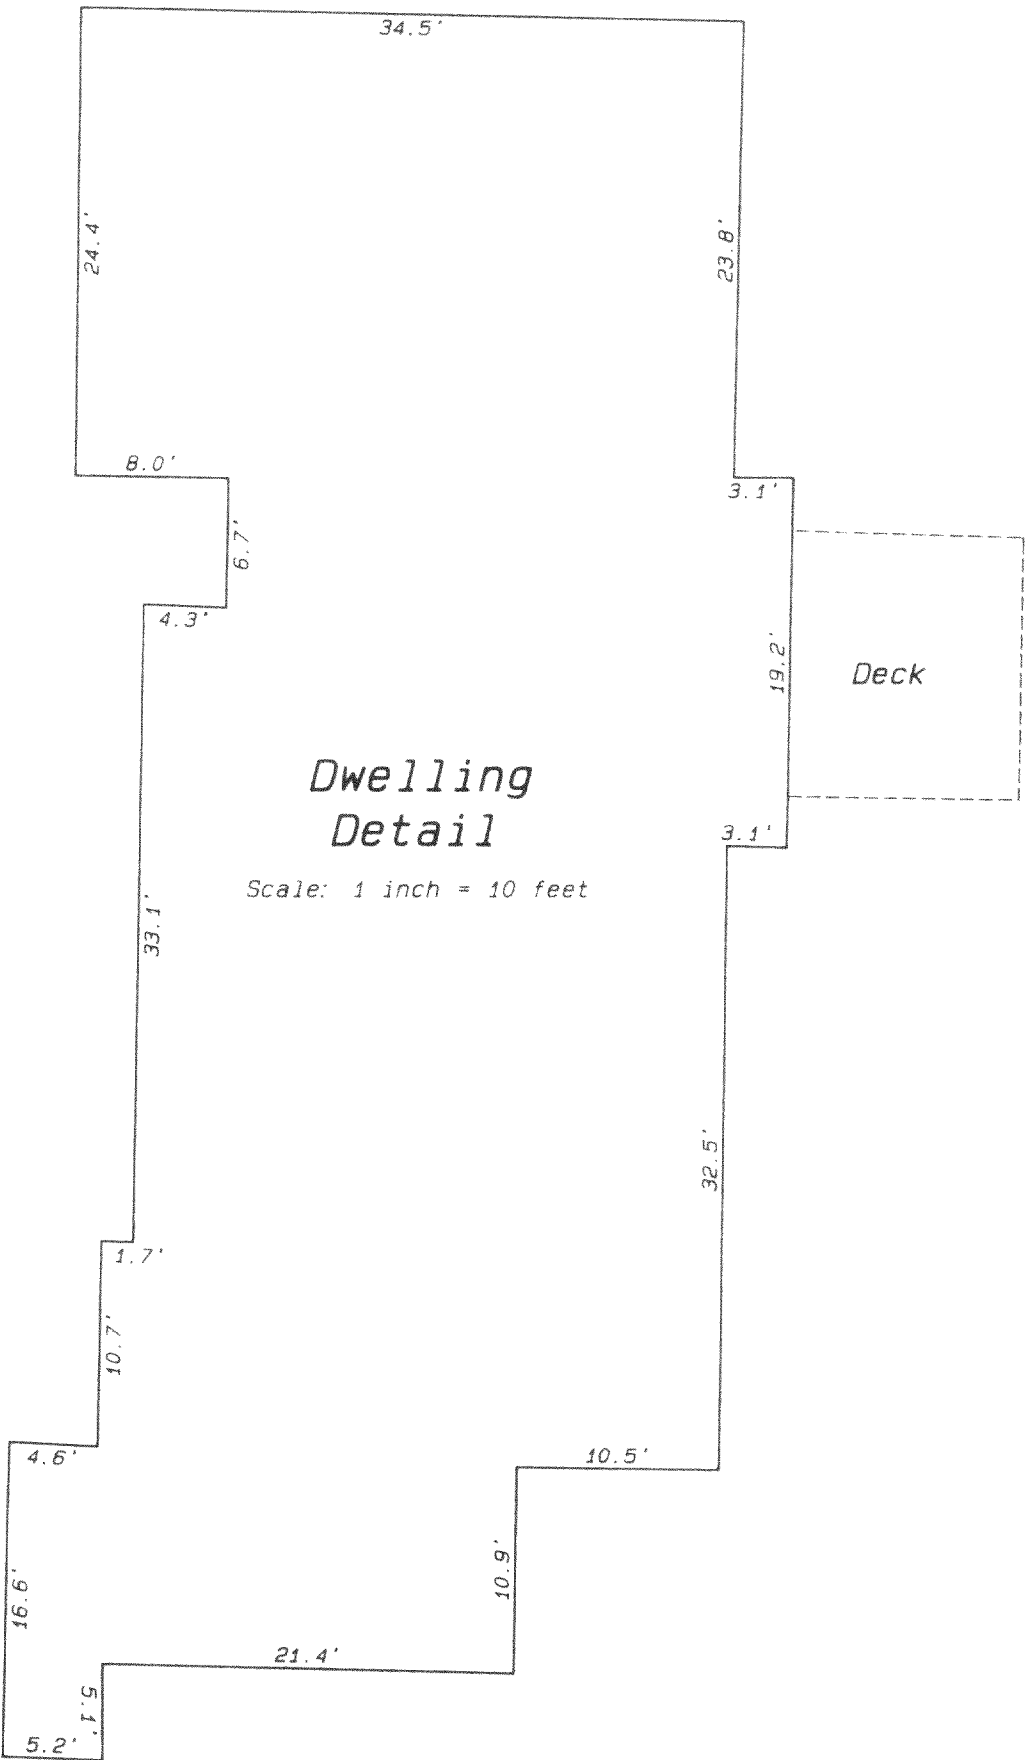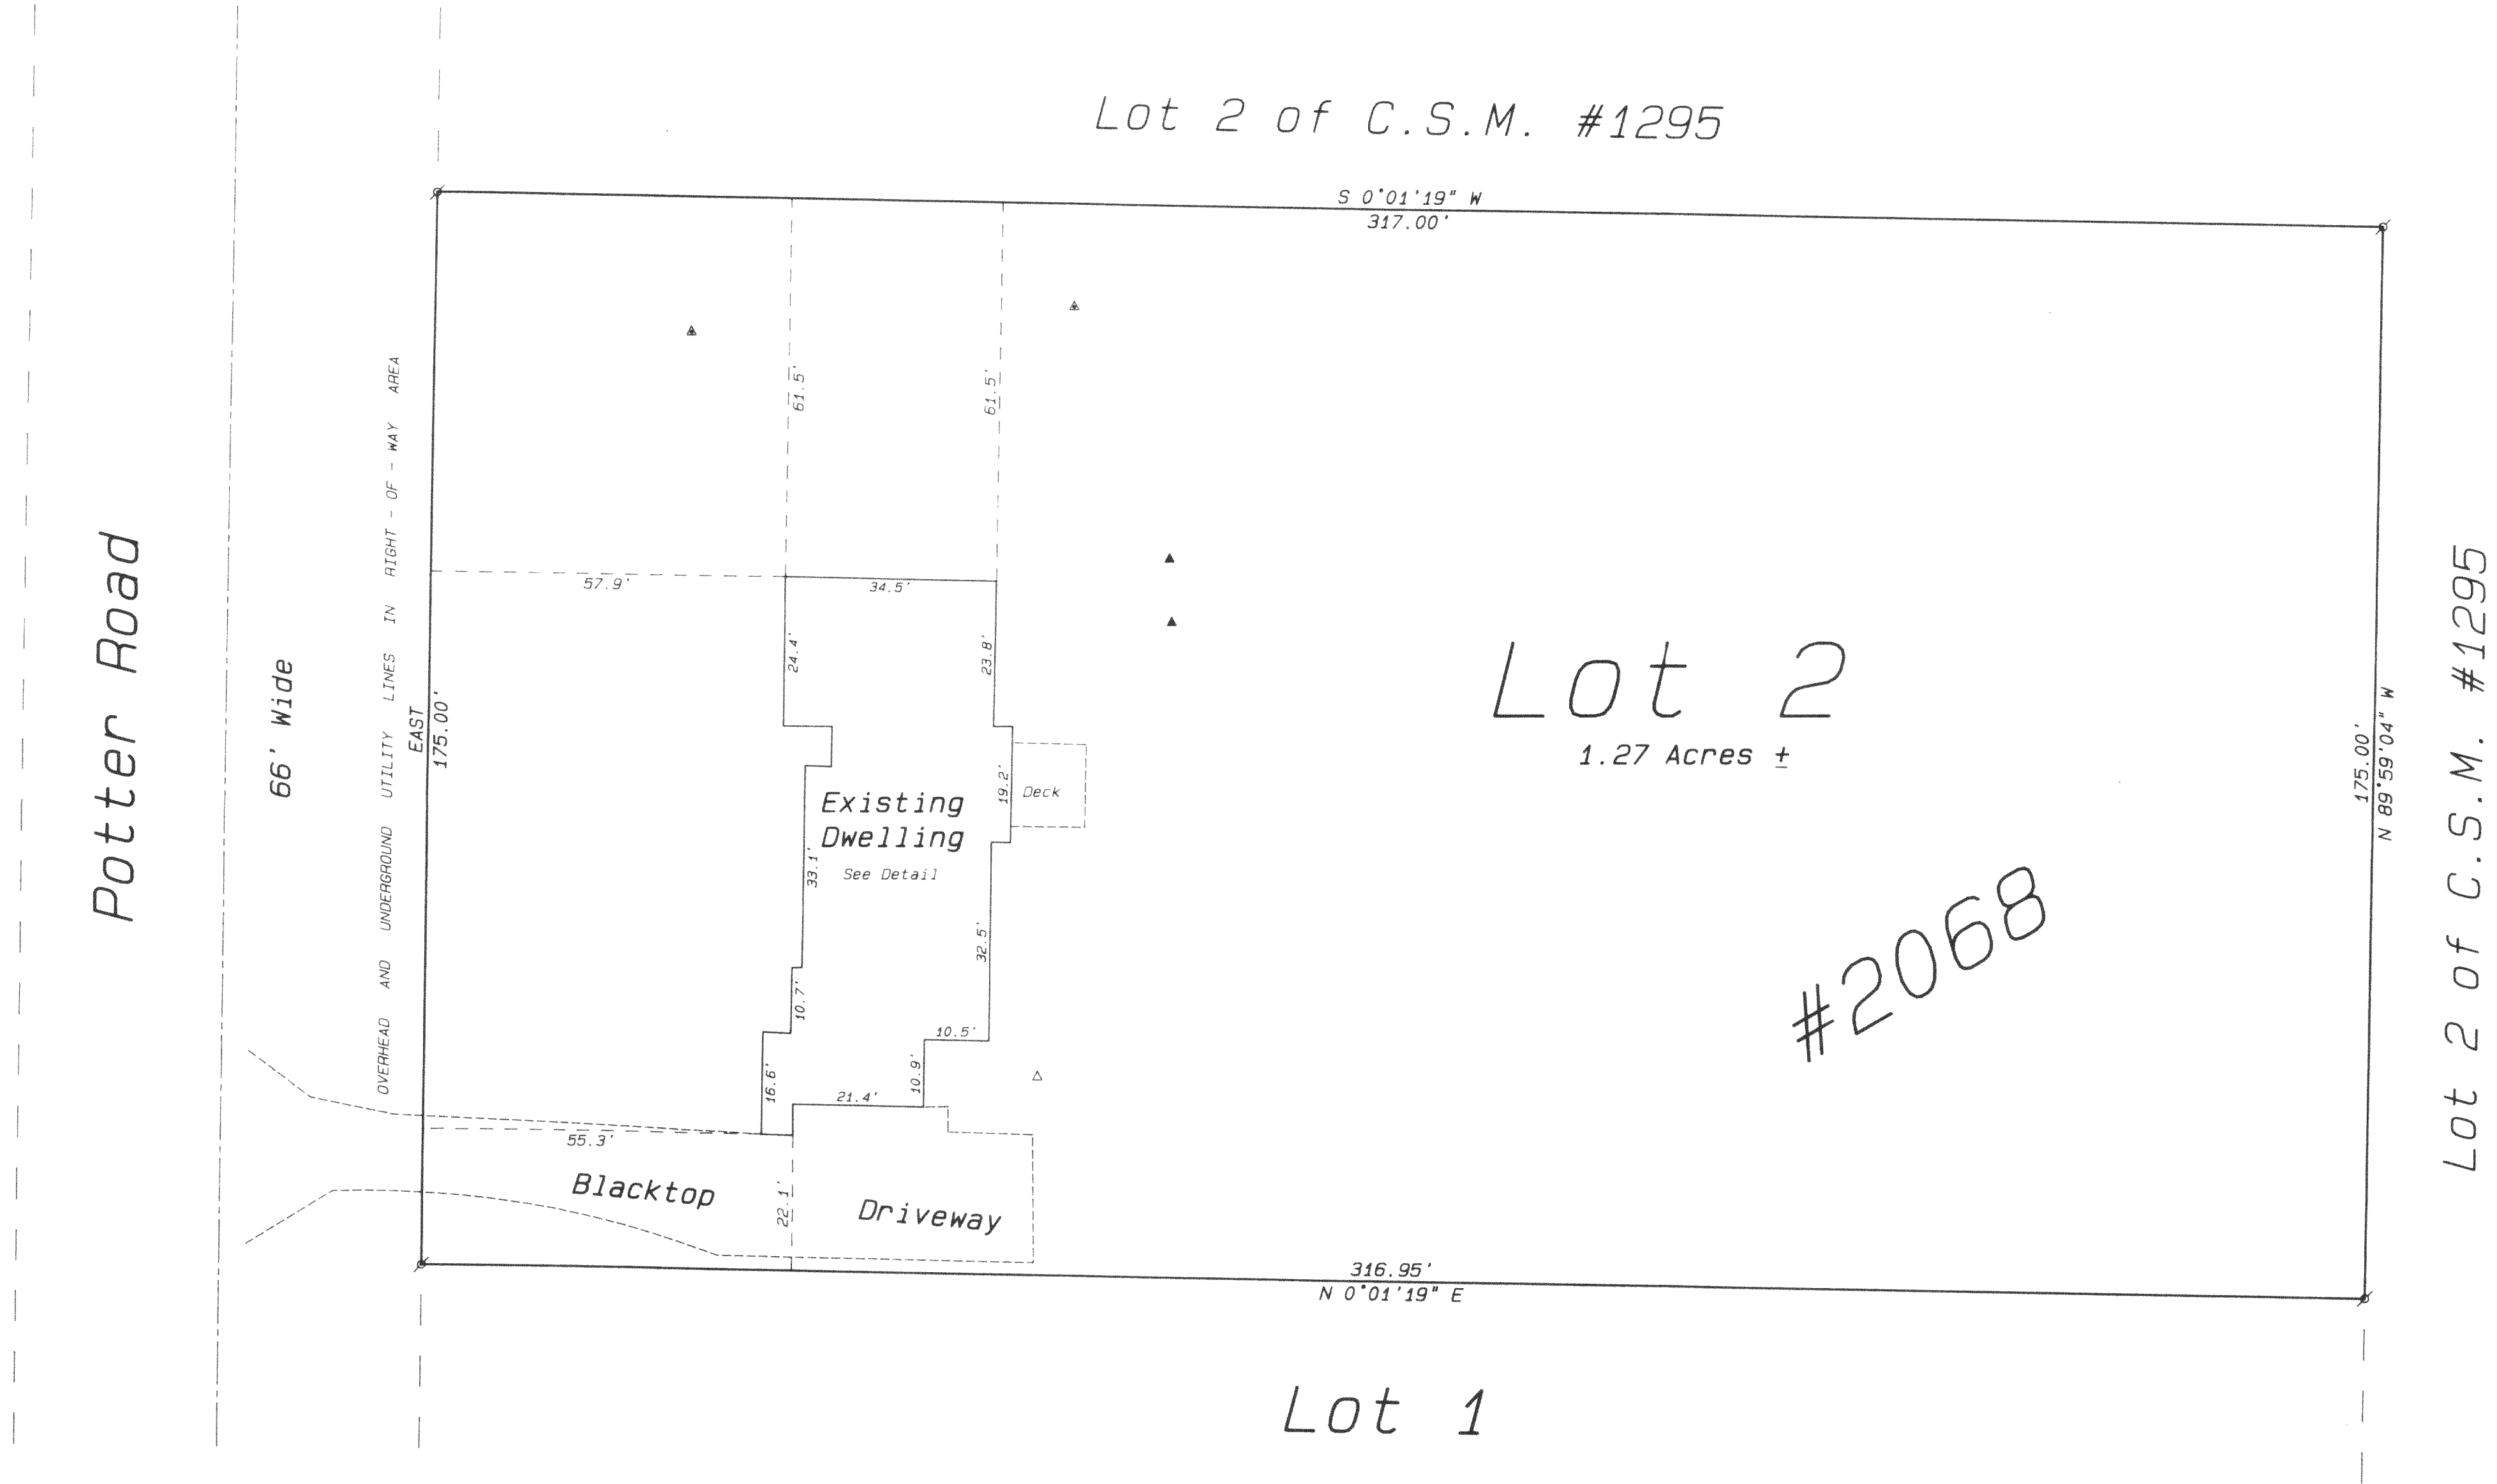


Legend

- FOUND IRON PIPE
- FOUND IRON ROD
- FOUND BRASS CAPPED MONUMENT
- FOUND CONCRETE MONUMENT
- CHISEL CUT IN CONCRETE
- SET IRON ROD, 24" LONG, WEIGHING 1.5 LBS./LINEAL FT., 3/4" DIA.
- SET IRON ROD, 30" LONG, WEIGHING 4.5 LBS./LINEAL FT., 1-11/16" DIA.
- RECORDED AS DIMENSION
- EXISTING FENCE
- WELL
- SEPTIC
- SEPTIC VENT



SCALE: 1"= 20 FEET

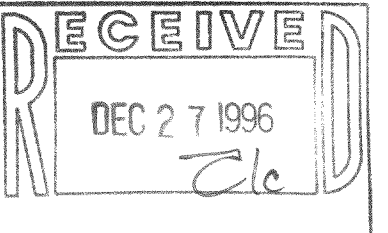

I hereby certify that the above described property has been surveyed by me or under my direction and that the above map is a true representation thereof and shows the size and location of the property, its exterior boundaries, the location of all visible structures and dimensions of all principal buildings thereon, boundary fences, apparent easements, roadways and visible encroachments, if any.
This survey is made for the use of the present owners of the property, and also those who purchase, mortgage, or guarantee the title thereof within one year from date hereof.

KENNETH B. ABERNATHY, JR.
WISCONSIN REGISTERED LAND SURVEYOR,
S-1594

Date: September 14, 1996 Job No. 1996.806

Owners: J. Clifford & Grace Johnson
W4715 Potter Road
Elkhorn, Wisconsin 53121

KA-2068-2
317-388