


CENTER OF SECTION 25-3-17

VOL. 645 PAGE 9426

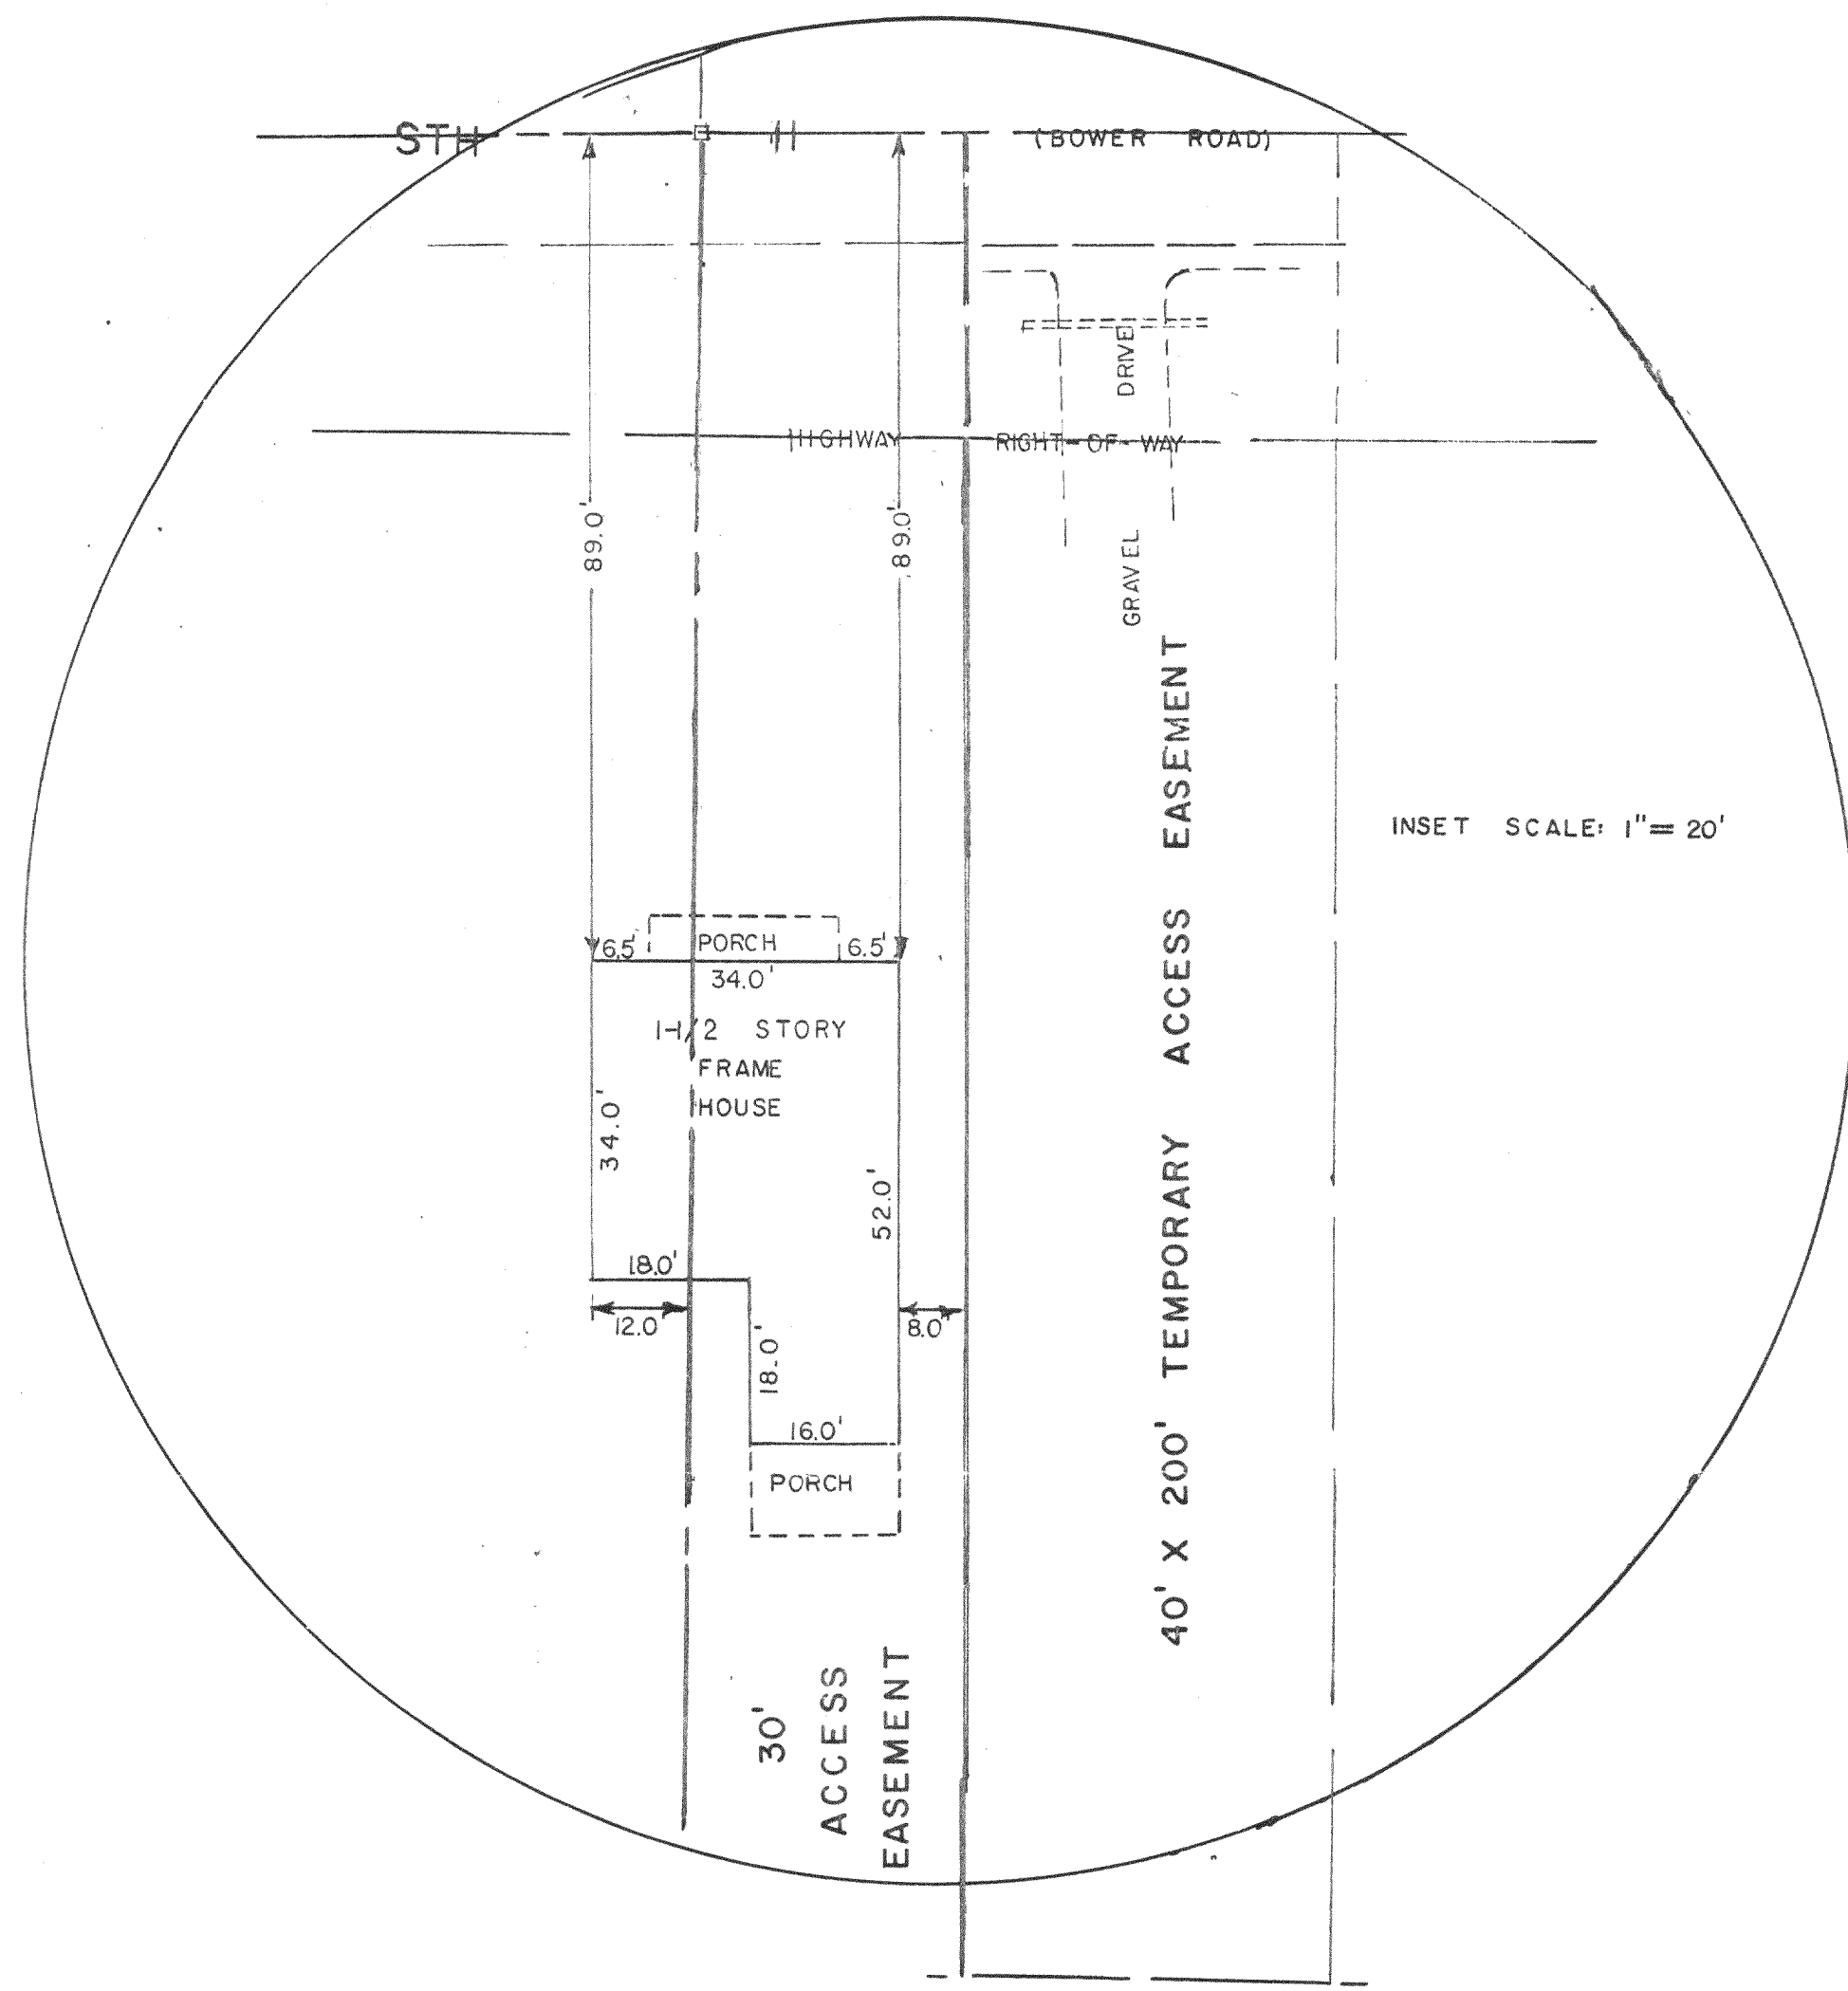

I HEREBY CERTIFY THAT I HAVE SURVEYED THE DESCRIBED PROPERTY AND THAT THE MAP SHOWN HEREON IS A CORRECT REPRESENTATION THEREOF AND SHOWS THE SIZE AND LOCATION OF THE PROPERTY, ITS EXTERIOR BOUNDARIES, THE LOCATION OF ALL VISIBLE STRUCTURES AND DIMENSIONS OF ALL PRINCIPAL BUILDINGS THEREON, APPARENT EASEMENTS, ROADWAYS, AND ENCROACHMENTS, IF ANY.

THIS SURVEY IS MADE FOR THE USE OF THE PRESENT OWNERS OF THE PROPERTY, AND THOSE WHO PURCHASE, MORTGAGE OR GUARANTEE THE TITLE THERE TO WITHIN ONE YEAR FROM DATE HEREOF.




CLARENCE W. BELLNER REG. NO. 5-482
January 31, 1995
DATE

QUALITY CONSULTING SERVICES, INC.
"Quality engineering is the cornerstone of our business."
4800 Grand View Place
Madison, Wisconsin 53719
9415 W. Forest Drive, Suite 303
Madison, Wisconsin 53717
MADISON • MILWAUKEE

NORTH 1/4 CORNER SECTION 36-3-17

VOL. 645 PAGE 9427

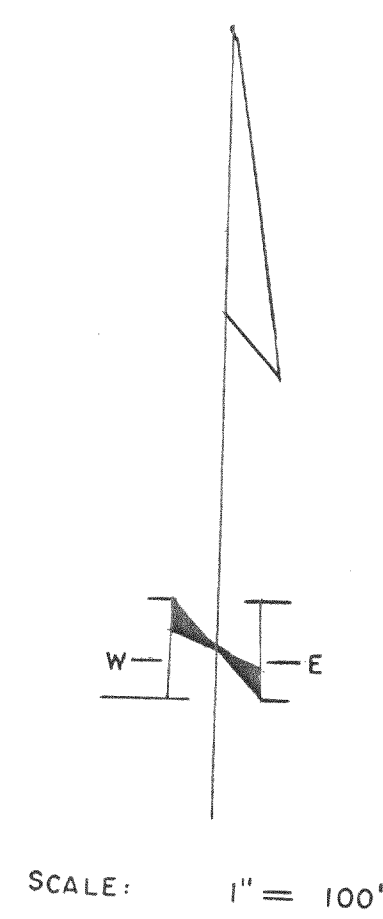

W 1/4 Sec. Line of the NE 1/4 Section 36-3-17

2662.12'

S 87° 22' 35" E

1326.06'

531.91'

S 87° 22' 35" E

663.00'

8 Acres of the NE 1/4 of the SW 1/4 of the NE 1/4 Section 36, T.3 N., R.17 E.

N 0° 13' 52" E

1197.14'

662.70'

1325.41'

S 87° 22' 31" E

662.70'

South 20 Acres of the S 1/2 of the SW 1/4 of the NE 1/4 Section 36, T.3 N., R.17 E.

663.24'


N 0° 09' 15" E

N 87° 22' 29" W

1324.74'

CENTER OF SECTION 36-3-17

WALTER - ATTACHMENT A - MAP

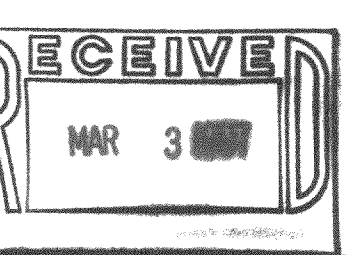

3/17-94

KLF-36-2
KLF-25-7
KA-2746-1