

ABERNATHY and ASSOCIATES

Kenneth B. Abernathy Jr.


Wisconsin Registered Land Surveyor S-1594

W4056 Bray Road
Elkhorn, Wisconsin 53121
Phone: (414) 723-4260 (office)
(414) 723-7209 (fax)

PLAT OF SURVEY

LOT 2 OF CERTIFIED SURVEY MAP NUMBER 2301,
LOCATED IN THE NORTHWEST 1/4 AND THE SOUTHWEST 1/4
OF THE NORTHEAST 1/4 OF SECTION 7, TOWN 3 NORTH,
RANGE 17 EAST, TOWN OF LAFAYETTE, WALWORTH COUNTY,
WISCONSIN.

Owners: Mike & Judy O'Donnell
N6840 Hodges Road
Elkhorn, Wisconsin 53121

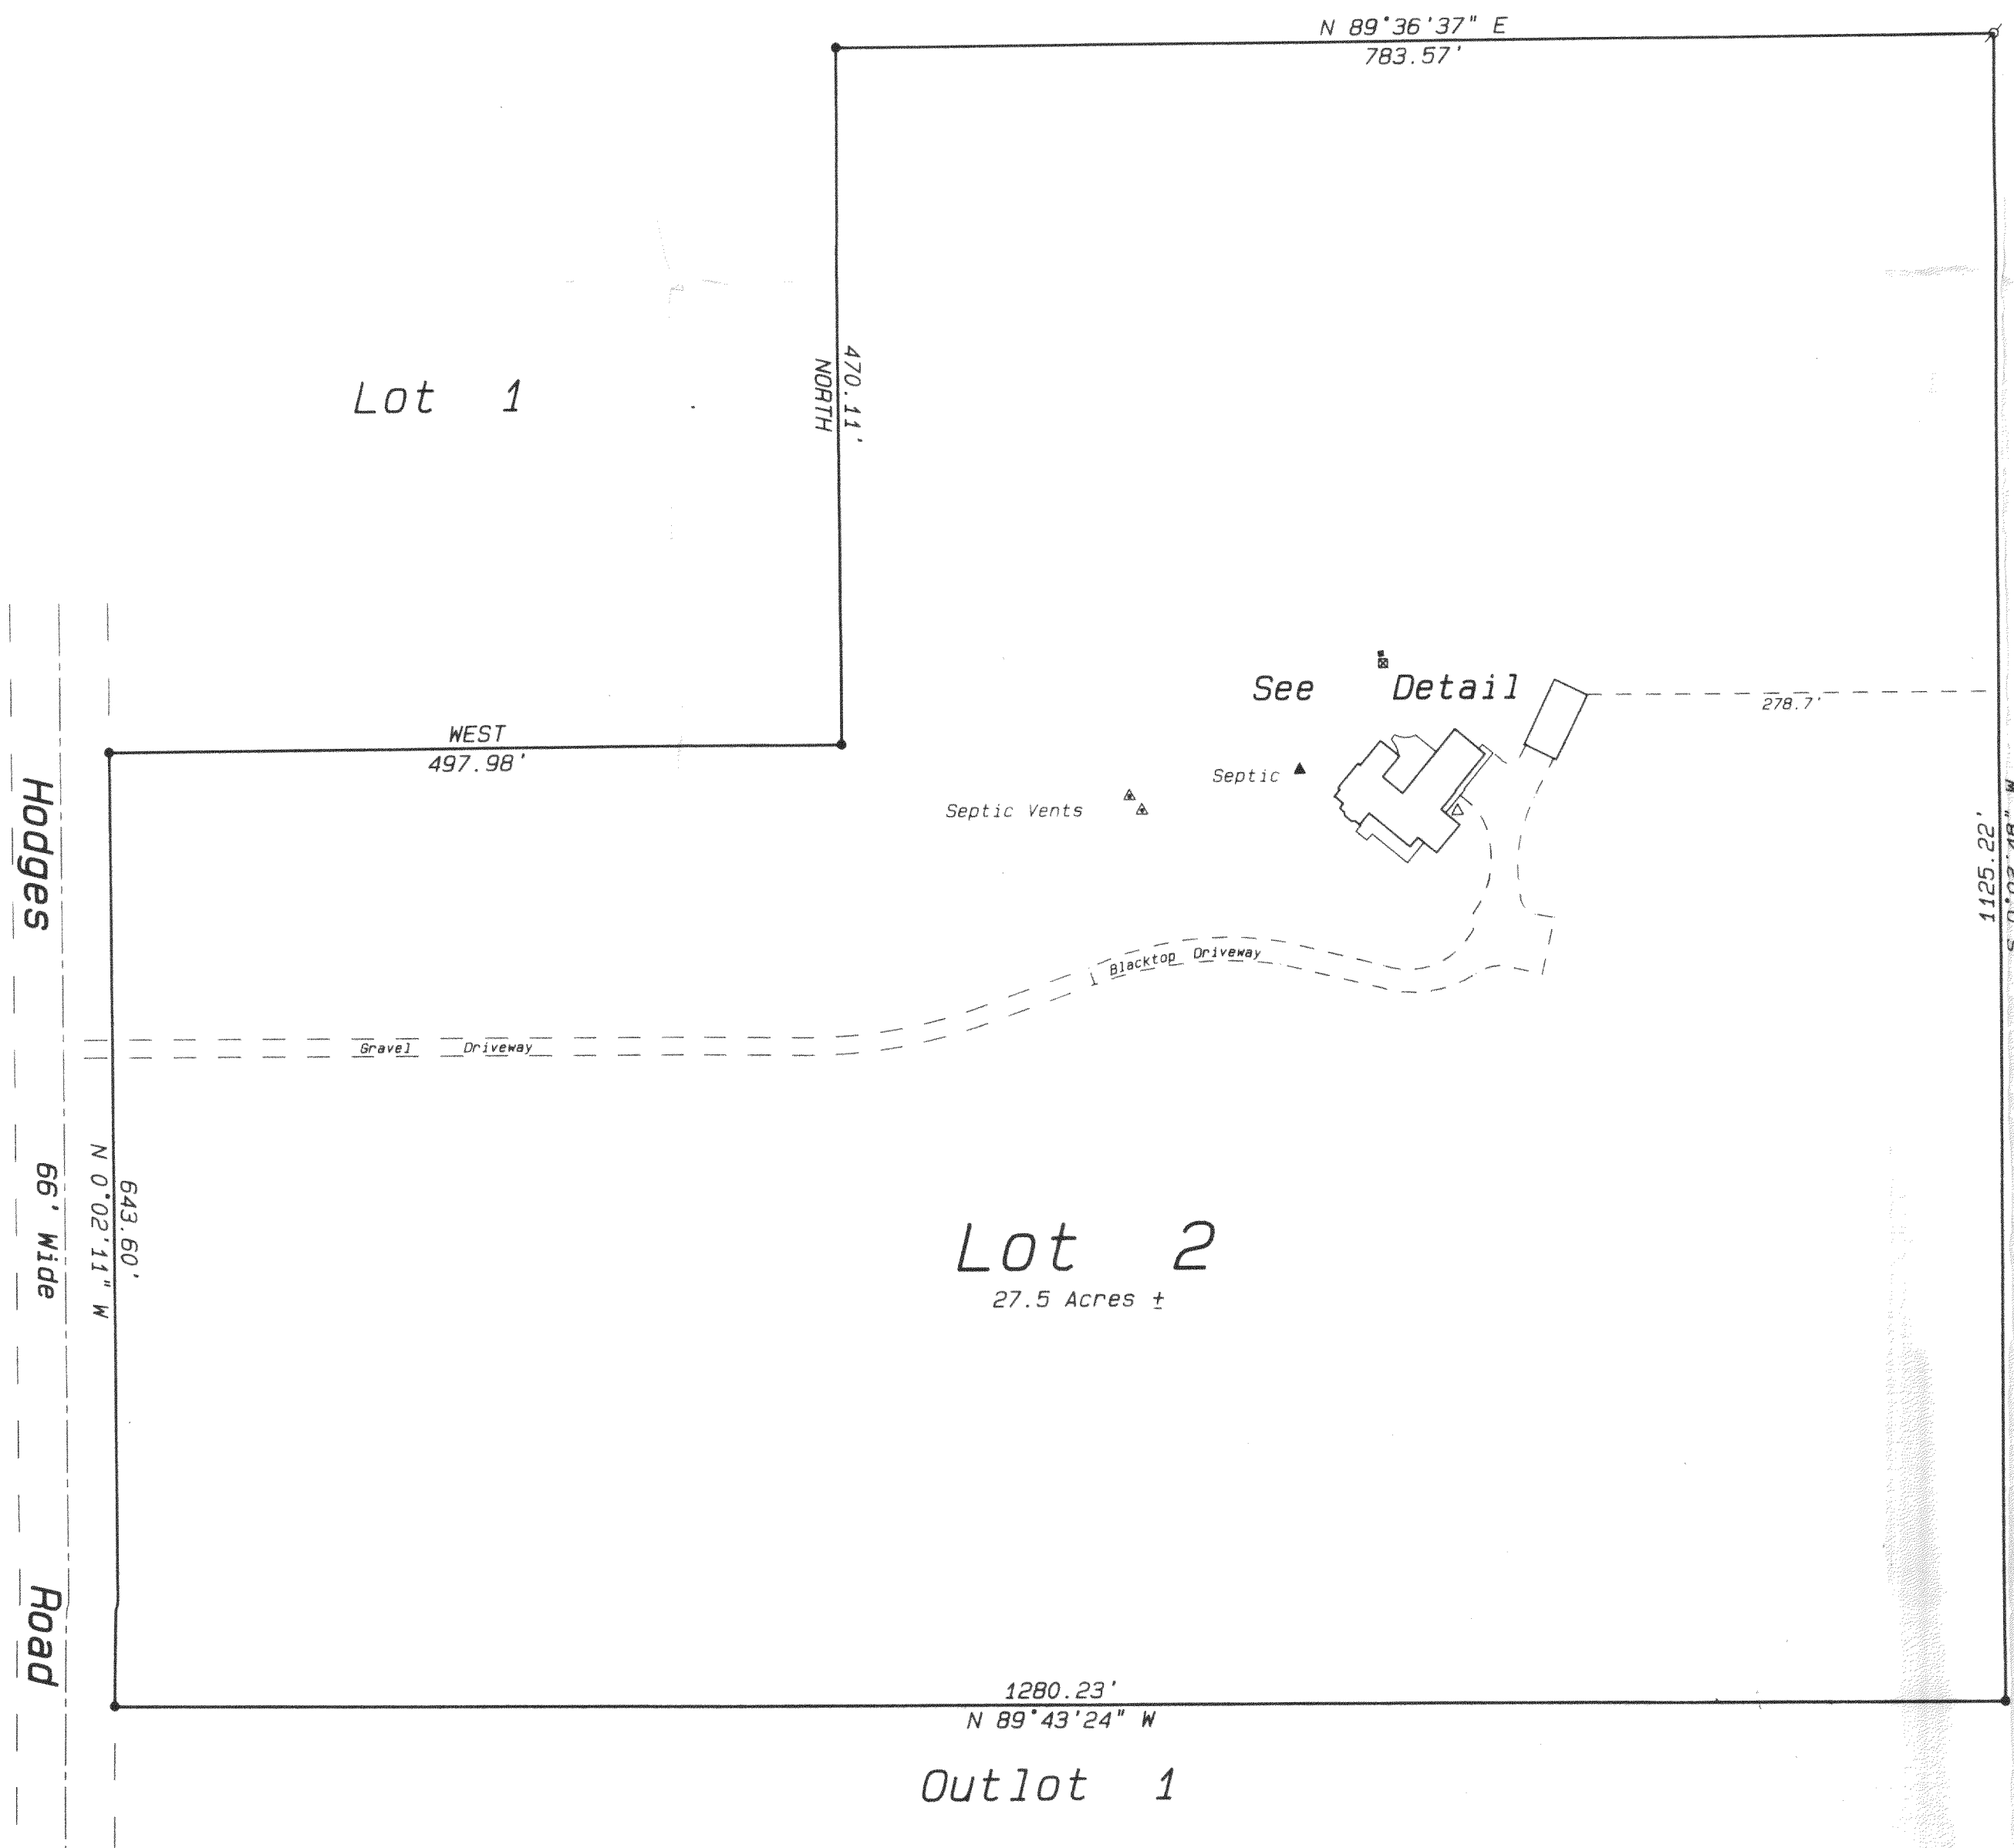


Utility Junction Box

Utility Pedestal



Legend

- FOUND IRON PIPE
- FOUND IRON ROD
- FOUND BRASS CAPPED MONUMENT
- FOUND CONCRETE MONUMENT
- CHISEL CUT IN CONCRETE
- SET IRON ROD, 24" LONG, WEIGHING 1.5 LBS., LINEAL FT., 3/4" DIA.
- SET IRON ROD, 36" LONG, WEIGHING 4.5 LBS., LINEAL FT., 1-1/8" DIA.
- RECORDED AS DIMENSION
- EXISTING FENCE

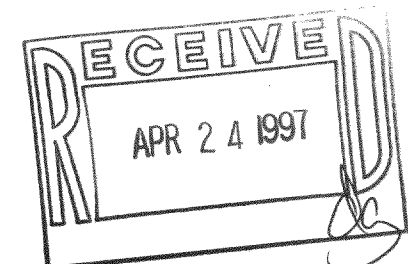

SCALE: 1" = 100 FEET



I hereby certify that the above described property has been surveyed by me or under my direction and that the above map is a true representation thereof and shows the size and location of the property, its exterior boundaries, the location of all visible structures and dimensions of all principal buildings thereon, boundary fences, apparent easements, roadways and visible encroachments, if any.

This survey is made for the use of the present owners of the property and also those who purchase, mortgage, or guarantee the title thereto within one year from date hereof.

Kenneth B. Abernathy, Jr.
KENNETH B. ABERNATHY, JR.
WISCONSIN REGISTERED LAND SURVEYOR,
S-1594

Date: March 26, 1997 Job No. 1997.309

KA-2301-2

317-402