

PLAT OF SURVEY



A PARCEL OF LAND LOCATED IN THE WEST 1/2 OF THE SOUTHWEST 1/4 OF SECTION 9, TOWN 3 NORTH, RANGE 17 EAST, LAFAYETTE TOWNSHIP, WALWORTH COUNTY, WISCONSIN.

LEGAL DESCRIPTION
(AS FOUND IN VOL. 649, PAGE 7465 OF RECORDS)


A PARCEL OF LAND LOCATED IN THE WEST 1/2 OF THE SOUTHWEST 1/4 OF SECTION 9, TOWN 3 NORTH, RANGE 17 EAST, WALWORTH COUNTY, WISCONSIN AND DESCRIBED AS FOLLOWS, TO-WIT: BEGINNING AT THE INTERSECTION OF THE NORTH-SOUTH 1/16TH LINE OF THE SOUTHWEST 1/4 OF SAID SECTION 9 AND THE CENTERLINE OF STATE TRUNK HIGHWAY 15; THENCE S 82°38' W, 186.61 FEET ALONG SAID CENTERLINE; THENCE N 0°16' W, 696.29 FEET; THENCE N 82°38' E, 190.38 FEET TO SAID 1/16TH LINE; THENCE SOUTH ALONG SAID LINE 696.29 FEET TO THE PLACE OF BEGINNING, CONTAINING 3.00 ACRES.

OWNER: NINA HAAS
W4606 COUNTY ROAD "ES"
ELKHORN, WIS. 53121


NOTE:
THE WEST LINE OF PARCEL WAS ASSUMED TO BEAR N 0°23'44" W FROM A PREVIOUS SURVEY BY BRADFORD L. SPENCER DATED 8-11-97.

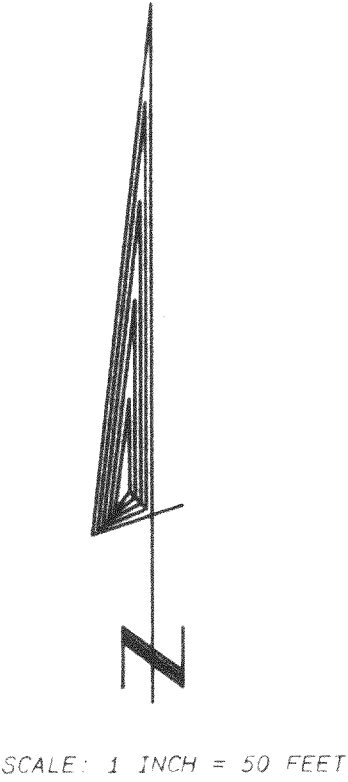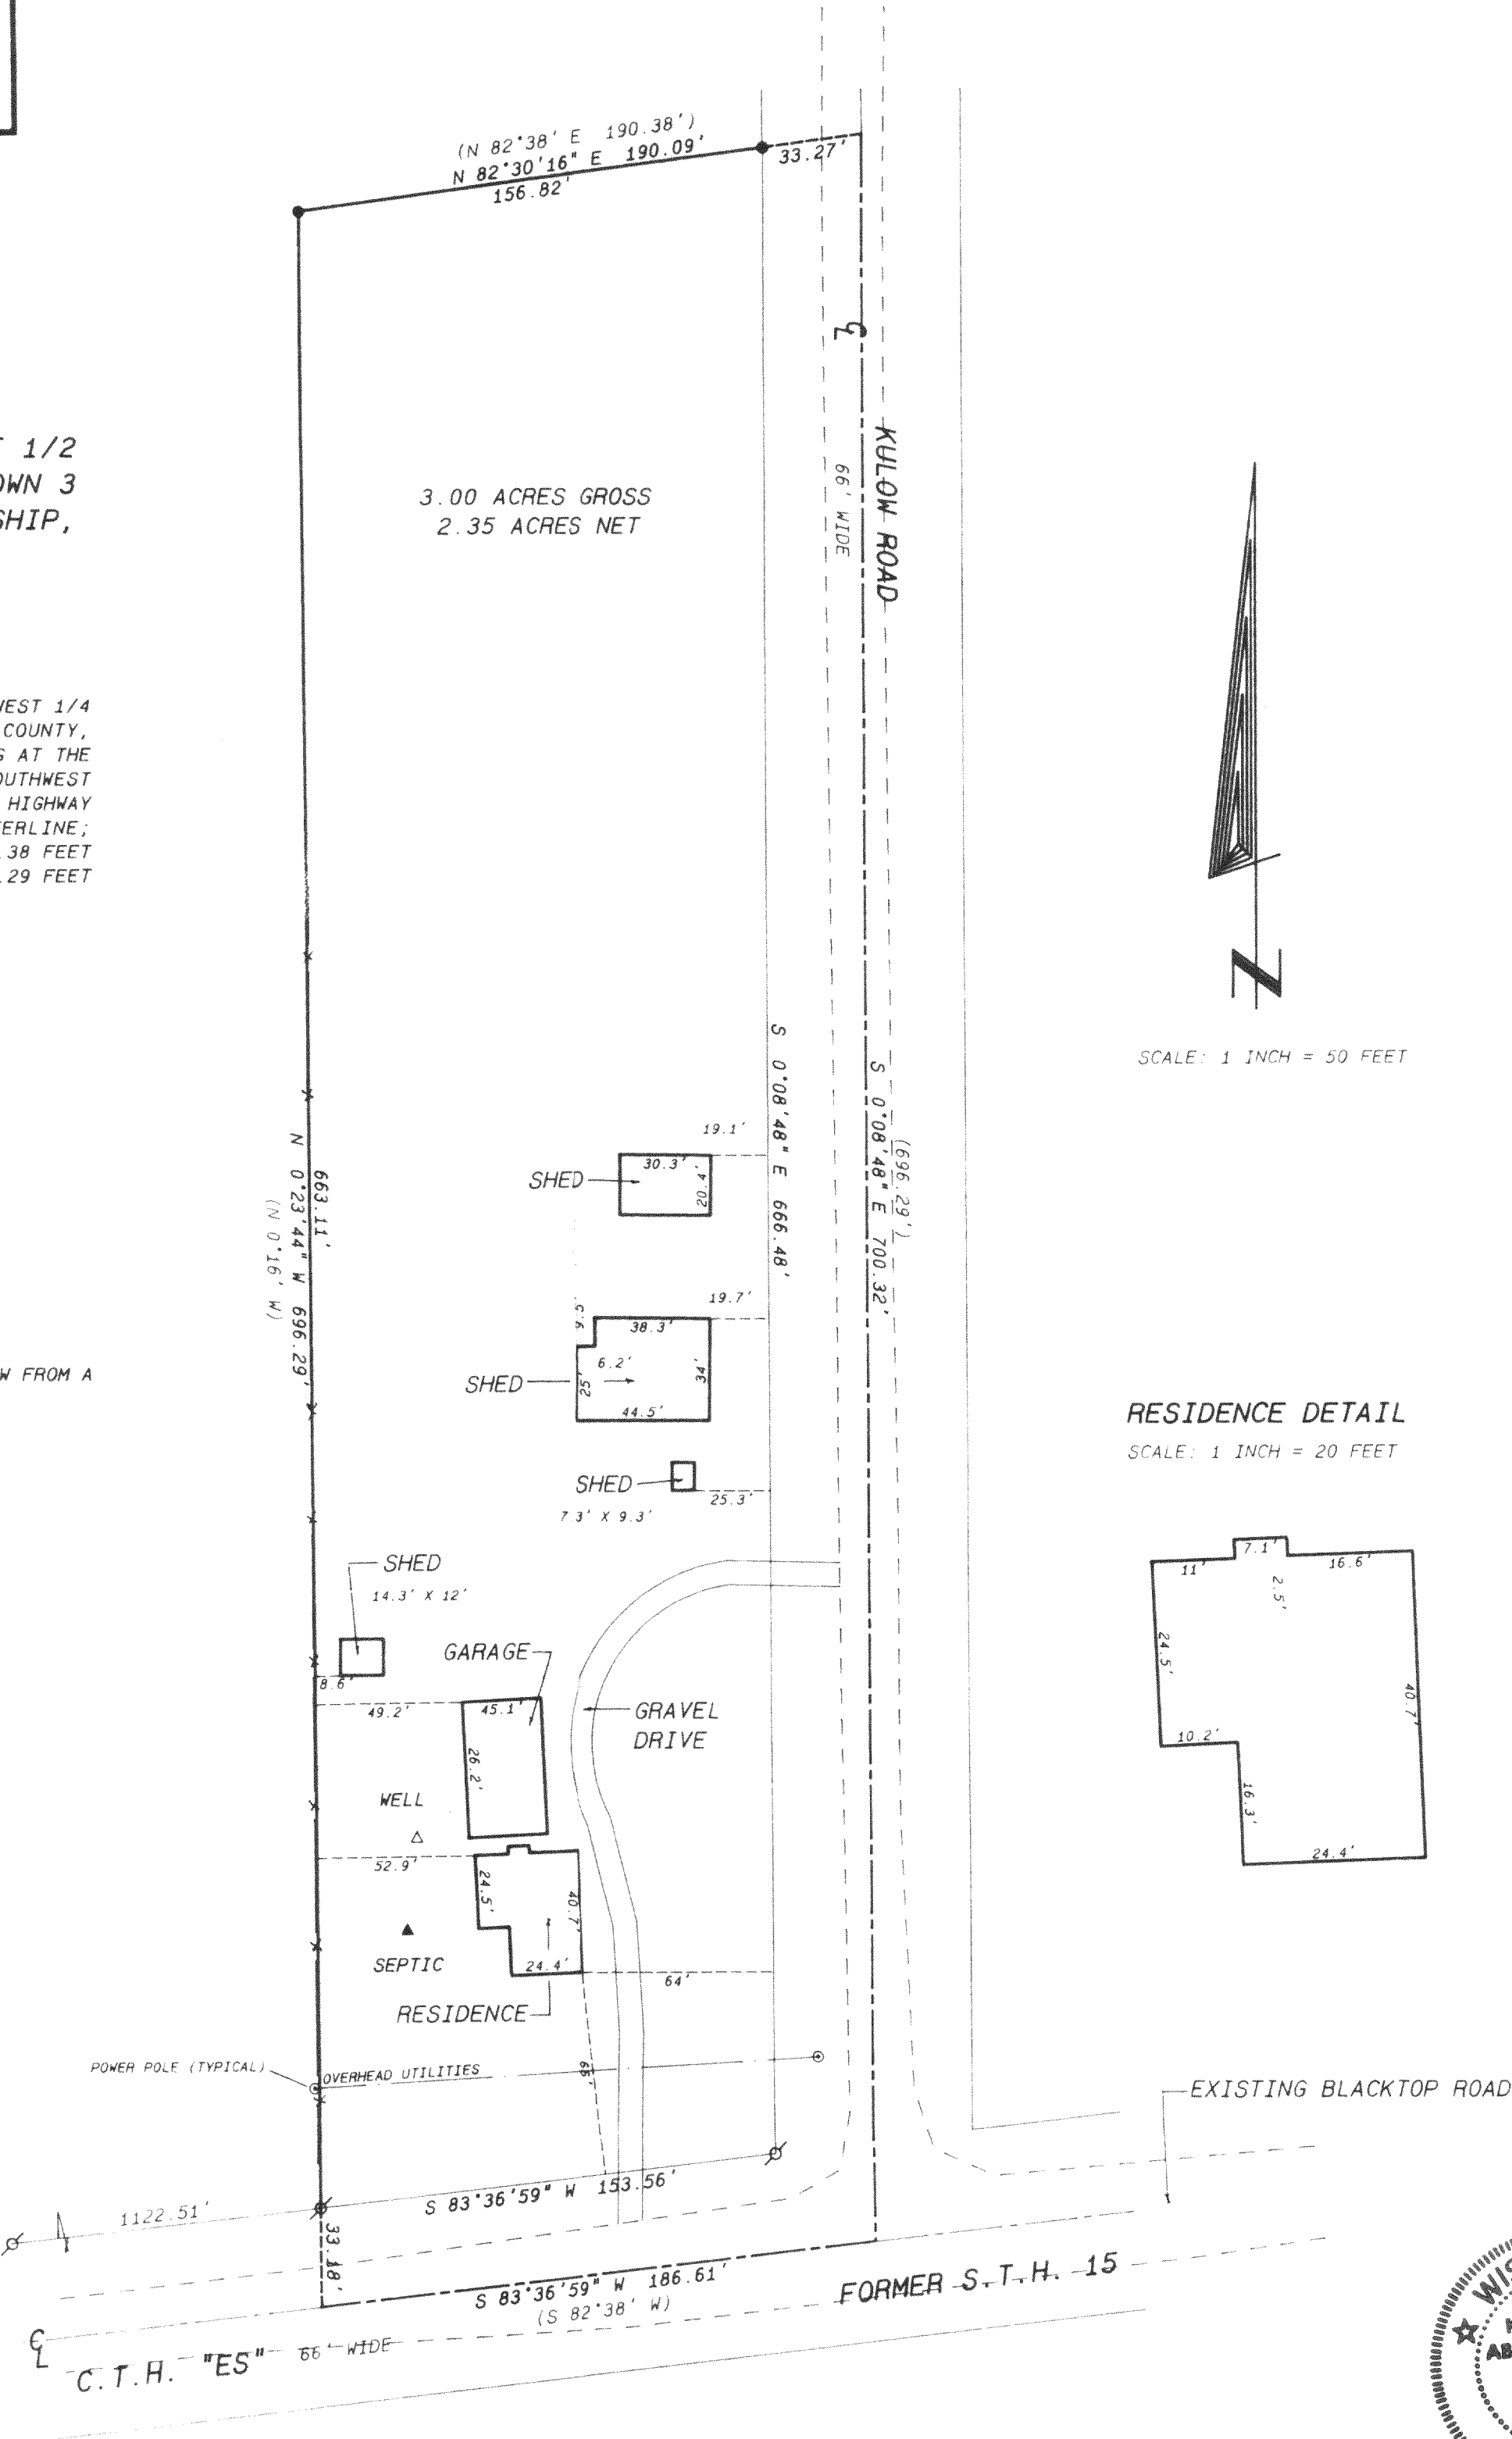

RESIDENCE DETAIL
SCALE: 1 INCH = 20 FEET

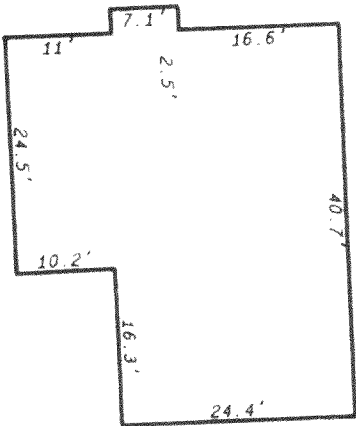


- Legend
- FOUND IRON PIPE
 - FOUND IRON ROD
 - FOUND BRASS CAPPED MONUMENT
 - FOUND CONCRETE MONUMENT
 - CHISEL CUT IN CONCRETE
 - SET IRON ROD, 24" LONG, WEIGHING 1.5 LBS. LINEAL FT., 3/4" DIA.
 - SET IRON ROD, 30" LONG, WEIGHING 4.5 LBS. LINEAL FT., 1 1/16" DIA.
 - RECORDED AS DIMENSION
 - EXISTING FENCE

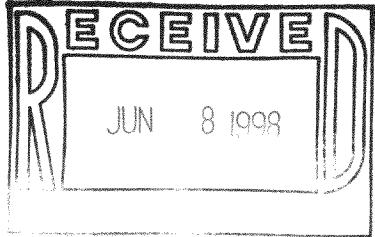

SCALE: 1" = 50 FEET

I hereby certify that the above described property has been surveyed by me or under my direction and that the above map is a true representation thereof and shows the size and location of the property, its exterior boundaries, the location of all visible structures and dimensions of all principal buildings thereon, boundary fences, apparent easements, roadways and visible encroachments, if any.

This survey is made for the use of the present owners of the property, and also those who purchase, mortgage, or guarantee the title thereto within one year from date hereof.

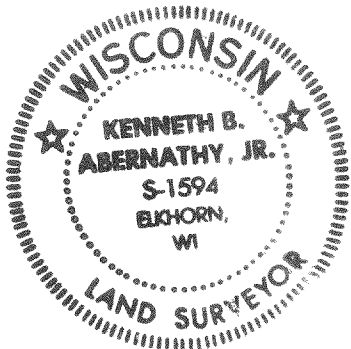

Kenneth B. Abernathy, Jr.
WISCONSIN REGISTERED LAND SURVEYOR,
S-1594
Date: 5-1-98 Job No. 98.414