

ABERNATHY and ASSOCIATES

Kenneth B. Abernathy Jr.

Wisconsin Registered Land Surveyor S-1594

Rt. 3, Box 273
Elkhorn, Wisconsin 53121
Phone: (414) 723-4260 (office)
(414) 723-7209 (FAX)

PLAT OF SURVEY



LOT 28 OF EVERGREEN ESTATES,
LOCATED IN THE SW 1/4 OF SECTION
19, TOWN 3 NORTH, RANGE 17 EAST,
WALWORTH COUNTY, WISCONSIN.

OWNER: DOROTHY CARAGOL TRUSTEE
DOROTHY CAROGOL REVOCABLE LIVING
TRUST
W4884 OVERLOOK DR.
ELKHORN, WI. 53121

ORDERED BY: RAULAND AGENCY
118 KENOSHA ST. P. O. BOX 159
WALWORTH, WI. 53184


LOT 29

LOT 27

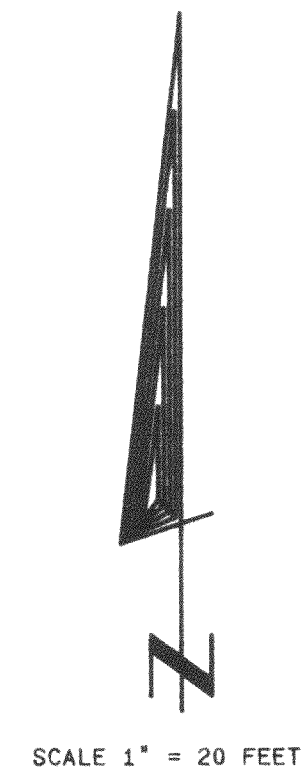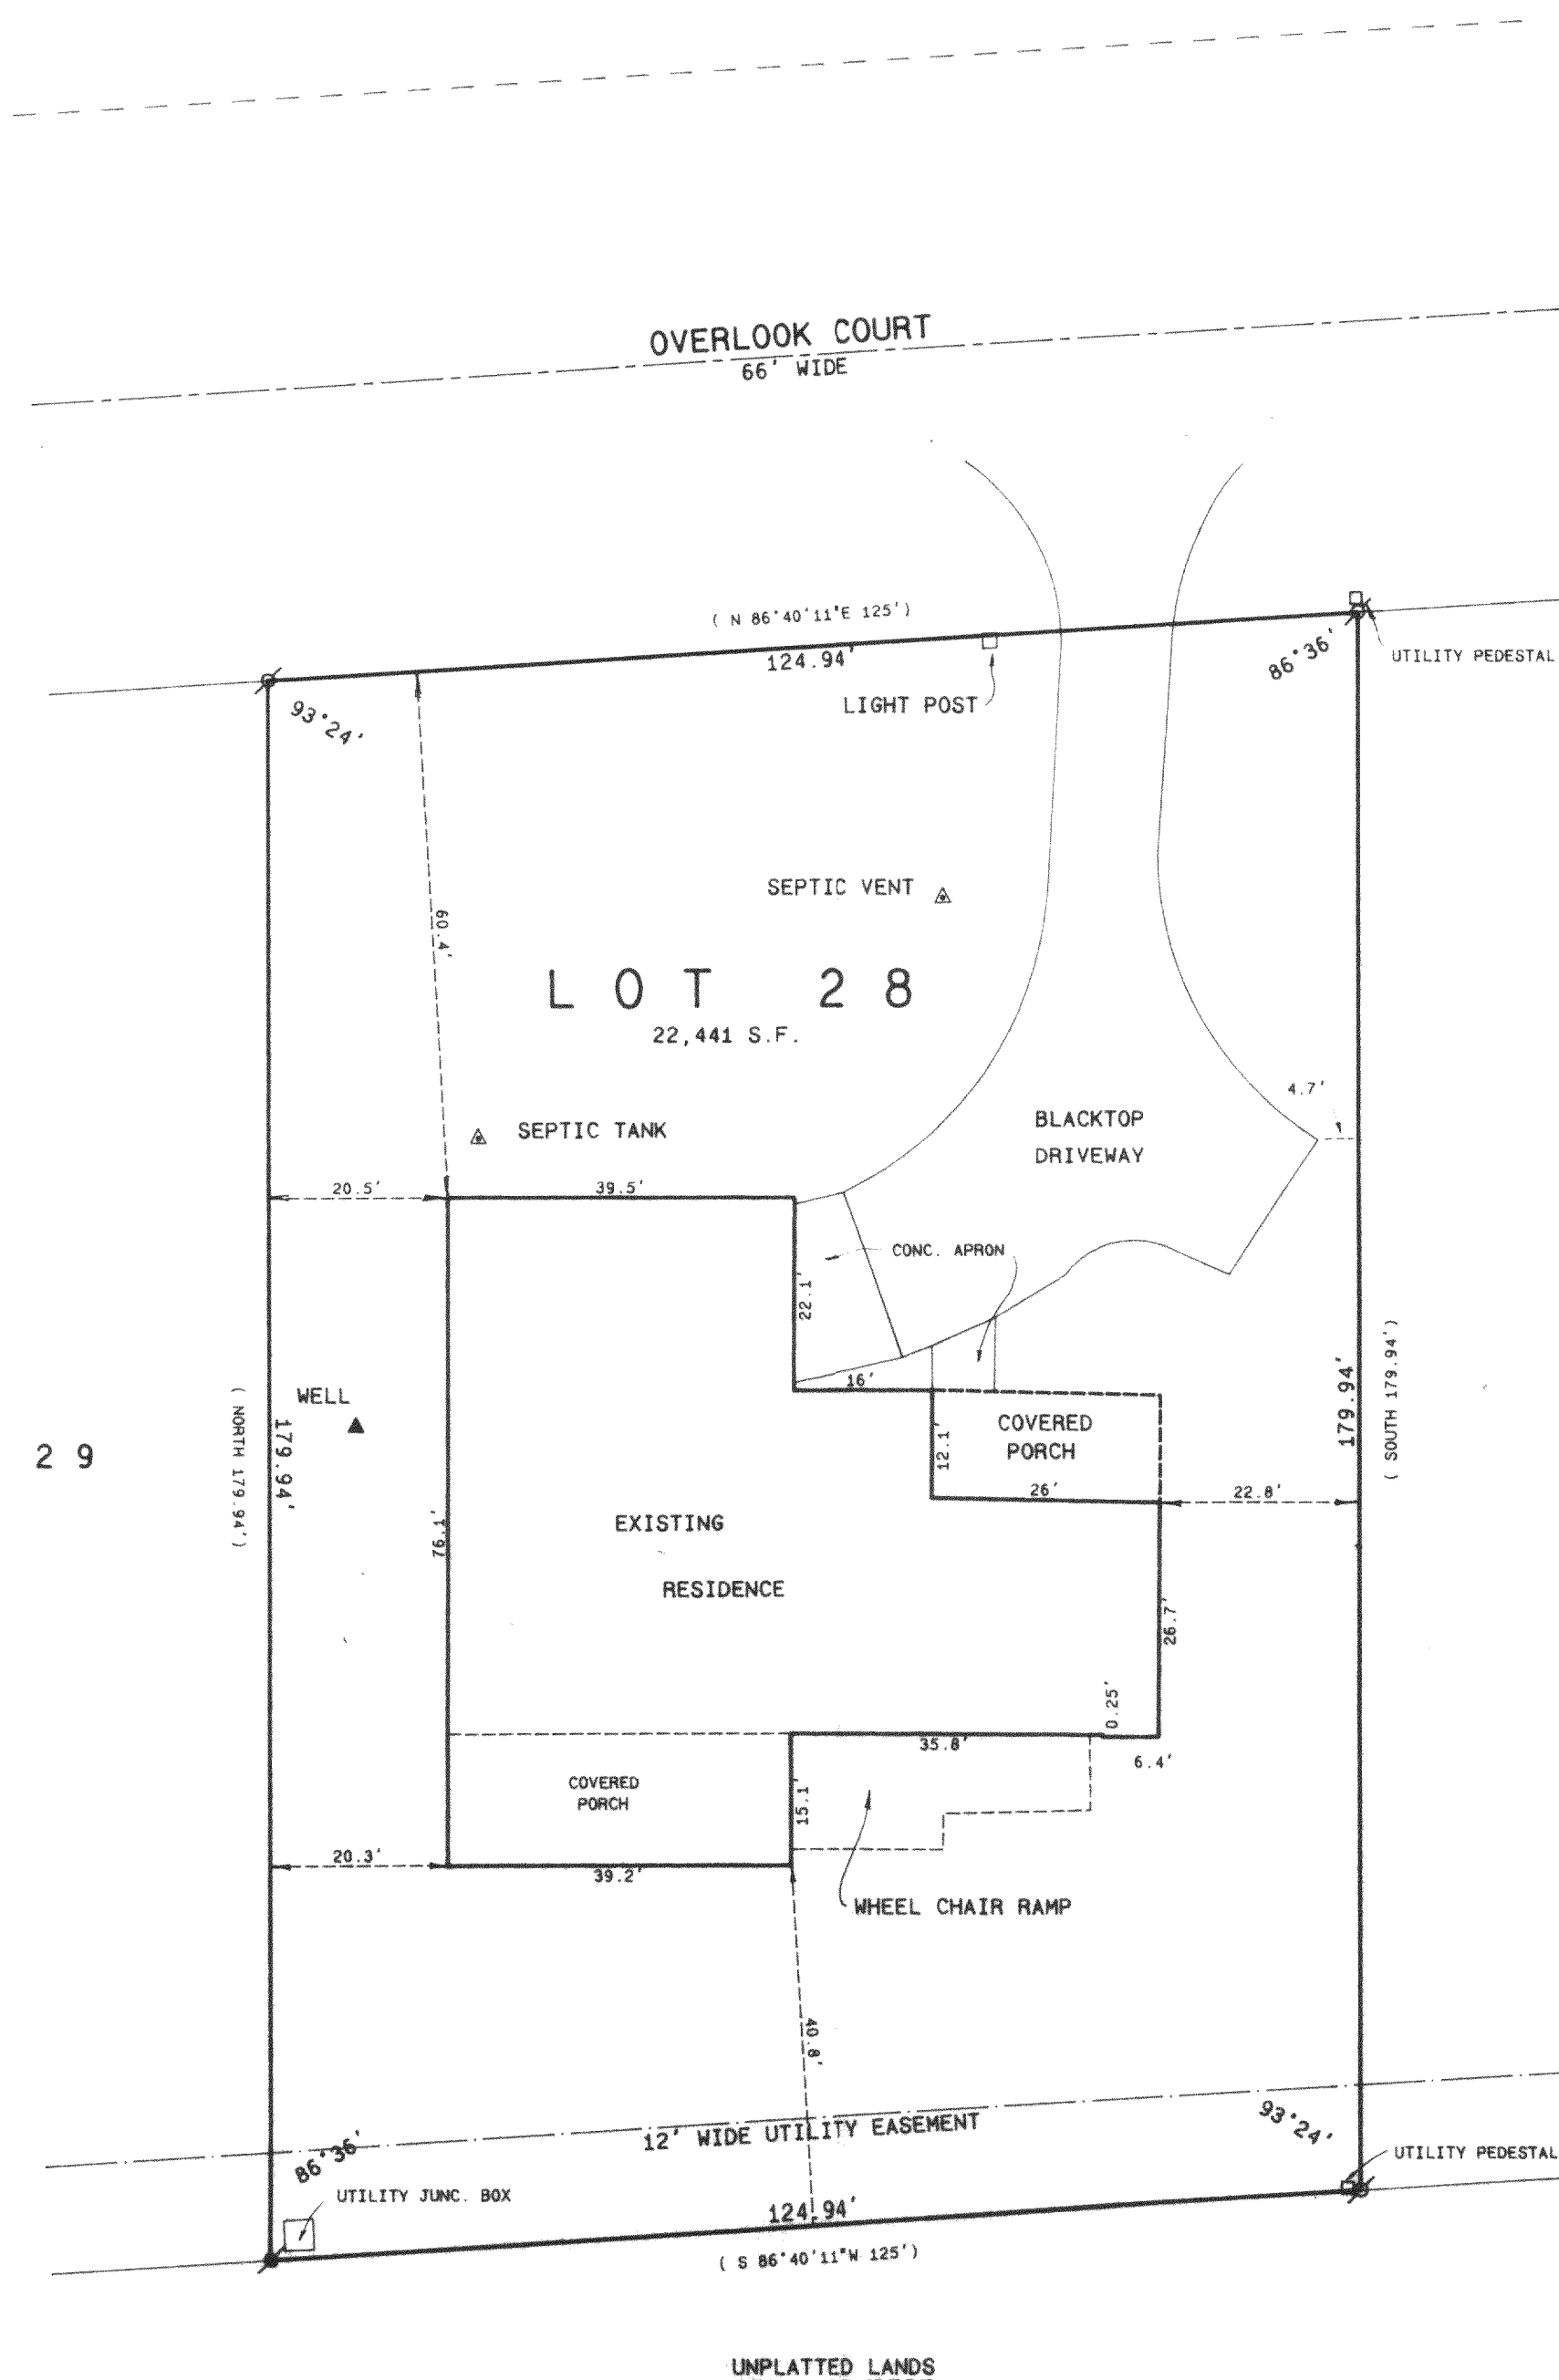

Legend

- FOUND IRON PIPE
- FOUND IRON ROD
- FOUND BRASS CAPPED MONUMENT
- FOUND CONCRETE MONUMENT
- CHISEL CUT IN CONCRETE
- SET IRON ROD, 24" LONG, WEIGHING 1.5 LBS./LINEAL FT., 3/4" DIA.
- SET IRON ROD, 30" LONG, WEIGHING 4.5 LBS./LINEAL FT., 1-11/16" DIA.
- RECORDED AS DIMENSION
- EXISTING FENCE

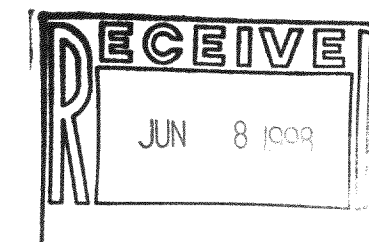

SCALE: 1" = 20 FEET



"I hereby certify that the above described property has been surveyed by me or under my direction and that the above map is a true representation thereof and shows the size and location of the property, its exterior boundaries, the location of all visible structures and dimensions of all principal buildings thereon, boundary fences, apparent easements, roadways and visible encroachments, if any."

"This survey is made for the use of the present owners of the property, and also those who purchase, mortgage, or guarantee the title thereto within one year from date hereof."

Kenneth B. Abernathy, Jr.
WISCONSIN REGISTERED LAND SURVEYOR,
S-1594
Date: 3-27-98 Job No. 98.313

KE-28
317-424