



PLAT OF SURVEY

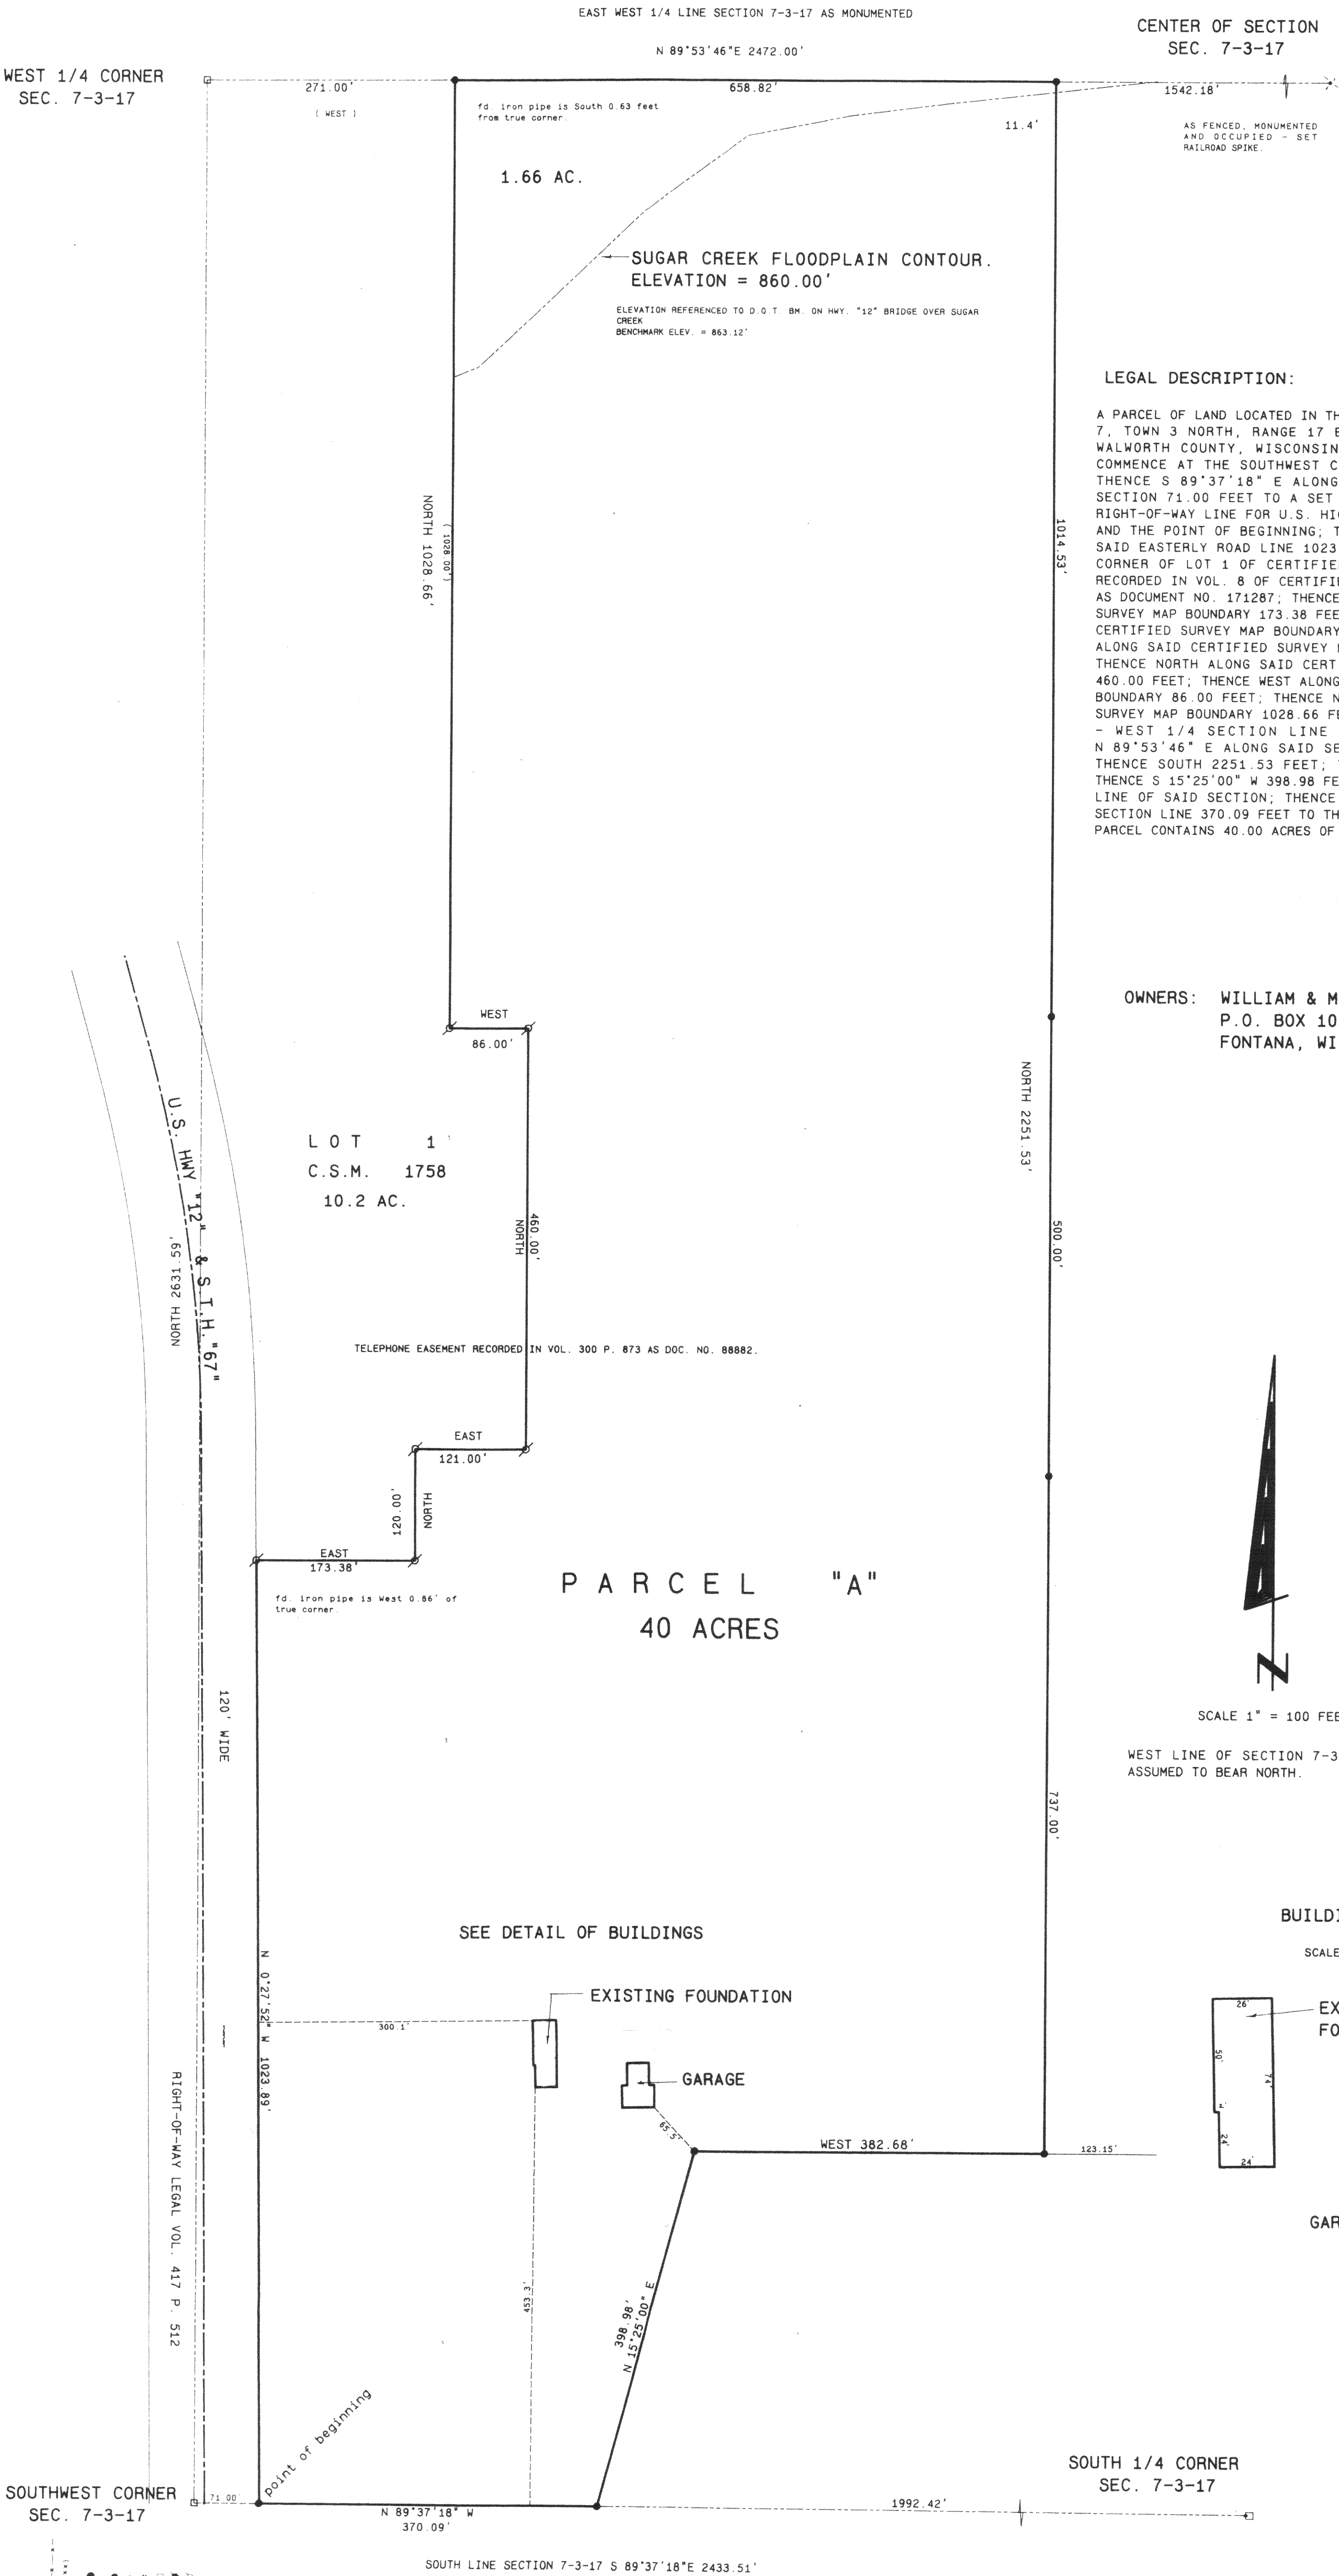

LEGAL DESCRIPTION:

A PARCEL OF LAND LOCATED IN THE SOUTHWEST 1/4 OF SECTION 7, TOWN 3 NORTH, RANGE 17 EAST, TOWN OF LAFAYETTE, WALWORTH COUNTY, WISCONSIN; DESCRIBED AS FOLLOWS: COMMENCE AT THE SOUTHWEST CORNER OF SAID SECTION 7; THENCE S 89°37'18" E ALONG THE SOUTH LINE OF SAID SECTION 71.00 FEET TO A SET IRON ROD IN THE EASTERLY RIGHT-OF-WAY LINE FOR U.S. HIGHWAY "12" AND S.T.H. "67" AND THE POINT OF BEGINNING; THENCE N 0°27'52" W ALONG SAID EASTERLY ROAD LINE 1023.89 FEET TO THE SOUTHWEST CORNER OF LOT 1 OF CERTIFIED SURVEY MAP NO. 1758 AS RECORDED IN VOL. 8 OF CERTIFIED SURVEY MAPS AS PAGE 185 AS DOCUMENT NO. 171287; THENCE EAST ALONG SAID CERTIFIED SURVEY MAP BOUNDARY 173.38 FEET; THENCE NORTH ALONG SAID CERTIFIED SURVEY MAP BOUNDARY 120.00 FEET; THENCE EAST ALONG SAID CERTIFIED SURVEY MAP BOUNDARY 121.00 FEET; THENCE NORTH ALONG SAID CERTIFIED SURVEY MAP BOUNDARY 460.00 FEET; THENCE WEST ALONG SAID CERTIFIED SURVEY MAP BOUNDARY 86.00 FEET; THENCE NORTH ALONG SAID CERTIFIED SURVEY MAP BOUNDARY 1028.66 FEET TO A POINT IN THE EAST - WEST 1/4 SECTION LINE AS MONUMENTED; THENCE N 89°53'46" E ALONG SAID SECTION LINE 658.82 FEET; THENCE SOUTH 2251.53 FEET; THENCE WEST 382.66 FEET; THENCE S 15°25'00" W 398.98 FEET TO A POINT IN THE SOUTH LINE OF SAID SECTION; THENCE N 89°37'18" W ALONG SAID SECTION LINE 370.09 FEET TO THE POINT OF BEGINNING. SAID PARCEL CONTAINS 40.00 ACRES OF LAND MORE OR LESS.

OWNERS: WILLIAM & MARY LEHNER
P.O. BOX 103
FONTANA, WI. 53125

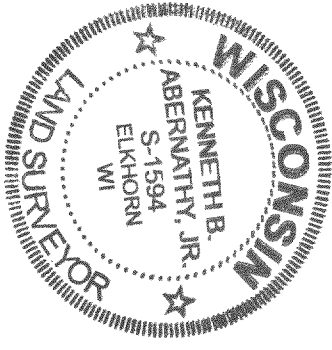

Kenneth B. Abernathy, Jr.
KENNETH B. ABERNATHY, JR.
WISCONSIN REGISTERED LAND SURVEYOR,
S-1594
Date: JUNE 30, 1999 Job No. 74-1008

317-449
KLF-7-4A