

WORK ORDERED BY: PAT PRAHL
1661 AVENUE OF CHAMPIONS
LAKE GENEVA, WI. 53147

FARRIS, HANSEN & ASSOCIATES, INC.
Engineering, Architecture, Surveying
7 Ridgway Court P.O. Box 437
ELKHORN, WISCONSIN 53121
Office: (414) 723-2098
Fax: (414) 723-5886

REVISIONS

PROJECT NO.
5296
DATE:
06-02-99
SHEET NO.
1 OF 1

BOUNDARY & TOPOGRAPHIC SURVEY LOT 18 OF BLOCK 2 ALPINE TOWER ESTATES


A SUBDIVISION LOCATED IN PART OF
THE NE 1/4 OF SECTION 13
TOWN 3 NORTH, RANGE 17 EAST
WALWORTH COUNTY, WISCONSIN

ASSIGNED SW LINE LOT 18
N 51° 52' 37" W

BENCH MARK
ASSIGNED TOP OF IRON PIPE STAKE
EL. = 200.00'

LEGEND

- = FOUND IRON PIPE STAKE
- ⊕ = SOIL BORING
- (xxx) = RECORDED AS
- △ = FOUND LATH

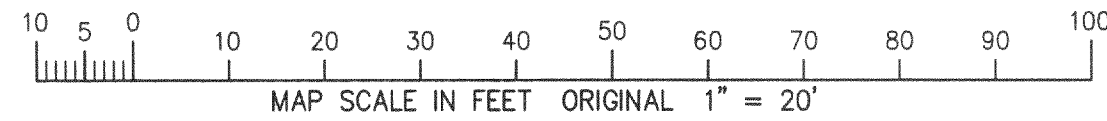

NOTE: COPIES OF THIS MAP TO WHICH THE FOLLOWING
CERTIFICATE WILL APPLY SHOW SURVEYOR'S ORIGINAL SEAL
AND SIGNATURE IN RED INK. COPIES BY ANY OTHER MEANS
MAY HAVE ALTERATIONS WHICH DO NOT REPRESENT THE
SURVEYOR'S WORK PRODUCT.

I HEREBY CERTIFY THAT THE ABOVE DESCRIBED PROPERTY HAS
BEEN SURVEYED UNDER MY DIRECTION AND THAT THE ABOVE MAP
IS A TRUE REPRESENTATION THEREOF AND SHOWS THE SIZE AND
LOCATION OF THE PROPERTY AND ITS EXTERIOR BOUNDARIES.
THIS SURVEY IS MADE FOR THE USE OF THE PRESENT OWNERS
OF THE PROPERTY, AND ALSO THOSE WHO PURCHASE, MORTGAGE,
OR GUARANTEE THE TITLE THERETO WITHIN ONE YEAR FROM THE
DATE HEREOF.


DATED: 6-2-99

Peter S. Gordon
PETER S. GORDON R.L.S. 2101

Revised 10/5/99
to show size & loc.
of AS BUILT RES.



BENCH MARK
ASSIGNED TOP OF IRON PIPE STAKE
EL. = 187.03'

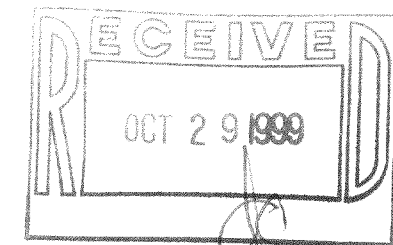

COPPERHEAD LANE

317-4466

KAT-40