

PLAY OF SURVEY

LOT 1 OF CERTIFIED SURVEY MAP NO. 3159

RECORDED IN VOL. 17 P. 186-189 AS DOCUMENT NO. 431110

NW 1/4 OF SECTION 33, TOWN 3 NORTH, RANGE 17 EAST, WALWORTH COUNTY,
WISCONSIN

L O T 2
CSM # 3159

OWNERS: JOHN AND MARSHA REIF
P.O. BOX 326
SHARON, WI. 53585

L O T 1
CSM # 3144

SCALE 1" = 40 FEET

REFERENCE ELEVATION
BENCHMARK - TOP OF SPIKE
ELEV. = 1023.12'

RESIDENCE DETAIL


SCALE 1" = 12 FEET

CHORD = S 11°14'30"E
90.98'
R. = 233.00'
I = 22°31'00"

Legend

- | | |
|---|---|
|  | FOUND IRON PIPE |
|  | FOUND IRON ROD |
|  | FOUND BRASS CAPPED MONUMENT |
|  | FOUND CONCRETE MONUMENT |
|  | CHISEL CUT IN CONCRETE |
|  | SET IRON ROD, 24" LONG, WEIGHING
1.5 LBS., LINEAL FT., 3/8" DIA. |
|  | SET IRON ROD, 30" LONG, WEIGHING
4.5 LBS., LINEAL FT., 1 1/8" DIA. |
|  | RECORDED AS DIMENSION |
|  | EXISTING FENCE |

SCALE: 1" = 40 FEET

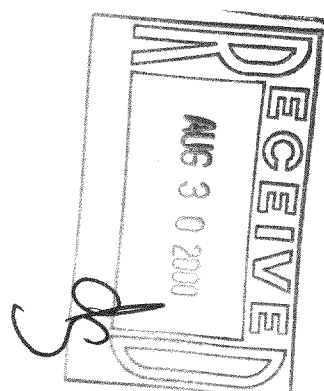

I, Keneth B. Abernathy, Jr., do hereby certify that the above described property has been surveyed for representation thereof and shown the size and location of the property, the location of the boundaries, the location of all water, structures and easements, roadways and visible encroachments, if any, and the location of the proposed subdivision, and that none of the above is within any other lease, mortgage or guarantee of the land covered within one year from the date hereof.

Keneth B. Abernathy, Jr.

KENNETH B. ABERNATHY, JR.
 WISCONSIN REGISTERED LAND SURVEYOR
 S-1594

Date: MARCH 3, 2000 Job No. 5-1594

Date: MARCH 3, 2000 Job No. 00-209

317-501

KA-3159-1