

ABERNATHY and ASSOCIATES


Kenneth B. Abernathy Jr.

Wisconsin Registered Land Surveyor S-1594

W4056 BRAY RD.
ELKHORN, WI. 53121
PHONE: (262) 723-4260 (OFFICE)
(262) 723-7209 (FAX)
Email: abernathy@elknet.net



PLAT OF SURVEY

LOT 127 OF EVERGREEN ESTATES SUBDIVISION, LOCATED
IN THE SOUTHWEST 1/4 OF SECTION 18, TOWN 3 NORTH,
RANGE 17 EAST, LA FAYETTE TOWNSHIP, WALWORTH
COUNTY, WISCONSIN.

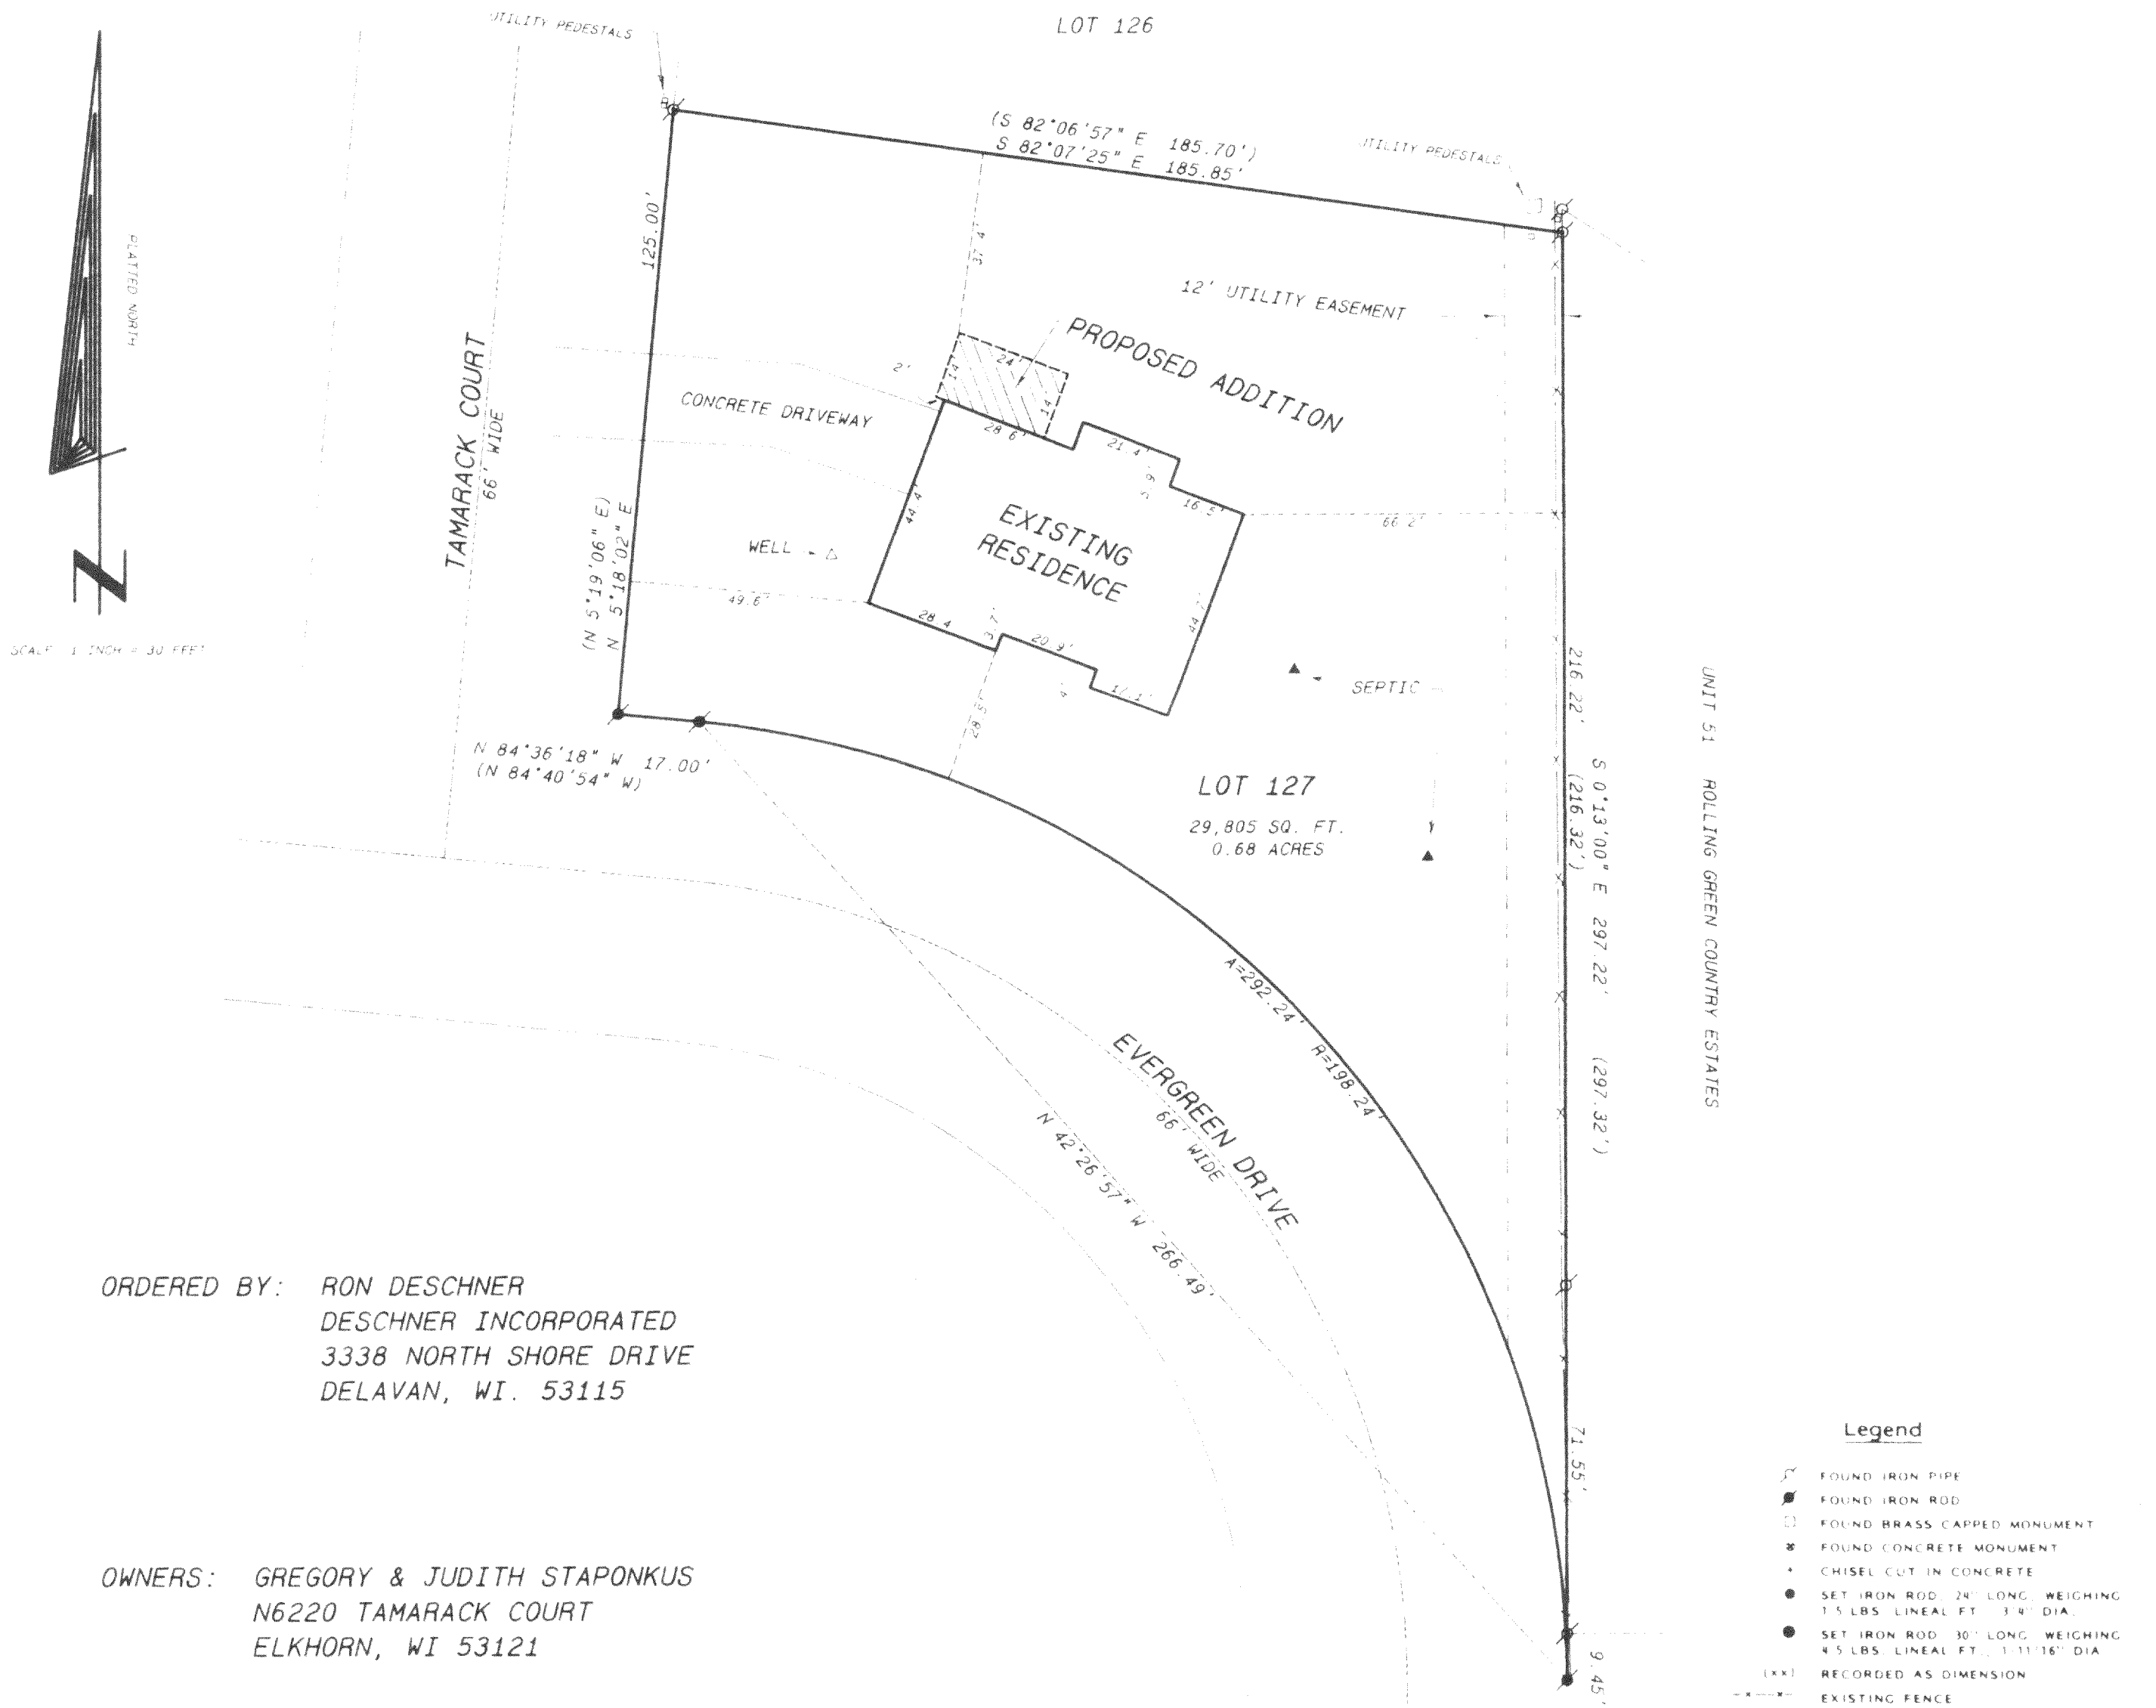

ORDERED BY: RON DESCHNER
DESCHNER INCORPORATED
3338 NORTH SHORE DRIVE
DELAVER, WI. 53115

OWNERS: GREGORY & JUDITH STAPONKUS
N6220 TAMARACK COURT
ELKHORN, WI 53121

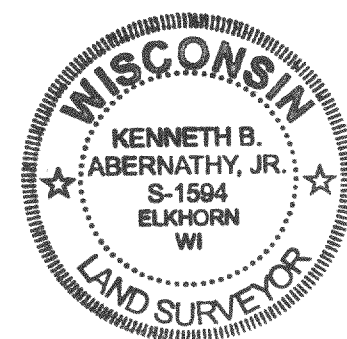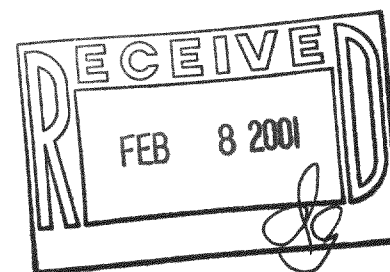

SCALE: 1"= 30 FEET

I hereby certify that the above described property has been surveyed by me in accordance with the laws of the State of Wisconsin, and that the above map is a true and correct representation of the same as shown on the ground. The property is located in the Southwest 1/4 of Section 18, Town 3 North, Range 17 East, La Fayette Township, Walworth County, Wisconsin. The survey was made for the use of the present owners of the property, and also those who may hereafter acquire the title thereto. A term one year from date hereof.

Kenneth B. Abernathy, Jr.
KENNETH B. ABERNATHY, JR.
WISCONSIN REGISTERED LAND SURVEYOR,
S-1594
Date: 12-22-2000 Job No. 001205

KE-127

317-511