


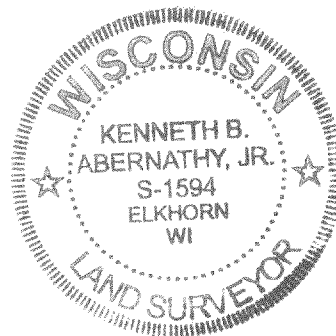

CERTIFIED SURVEY MAP NO. 3297
DOC. NO. 460868

VOL. 18
PAGES 251 - 253

A CERTIFIED SURVEY MAP OF LOT 1 OF CERTIFIED SURVEY MAP NO. 2958 AS RECORDED IN VOLUME 15 OF CERTIFIED SURVEY MAPS AS PAGES 260 AND 261 AS DOCUMENT NUMBER 376818 AND LANDS LOCATED IN THE SOUTHEAST 1/4 OF THE NORTHEAST 1/4 OF SECTION 6, TOWN 3 NORTH, RANGE 17 EAST, TOWN OF LAFAYETTE, WALWORTH COUNTY, WISCONSIN.

Kenneth B. Abernathy Jr.
Kenneth B. Abernathy Jr.

Wis. Reg. No. S-1594
Abernathy & Associates
W4056 Bray Road
Elkhorn, Wisconsin 53121
(414) 723-4260

3/30/01 REVISED 7/17/01 "AS BUILT"

ZONED A-5 and A-1
SOILS: MpB

OWNERS: CHARLES R. GRANGER
PEGGY A. GRANGER
7426 PLEASANT RD.
WATERFORD, WI. 53185


GRAPHIC SCALE IN FEET



BASIS FOR BEARINGS

THE EAST LINE OF THE NE 1/4 OF SEC. 6-3-17 WAS ASSUMED TO BEAR N 0°02'W TO MATCH EXISTING SURVEYS OF RECORD.

SCALE 1" = 120 FEET


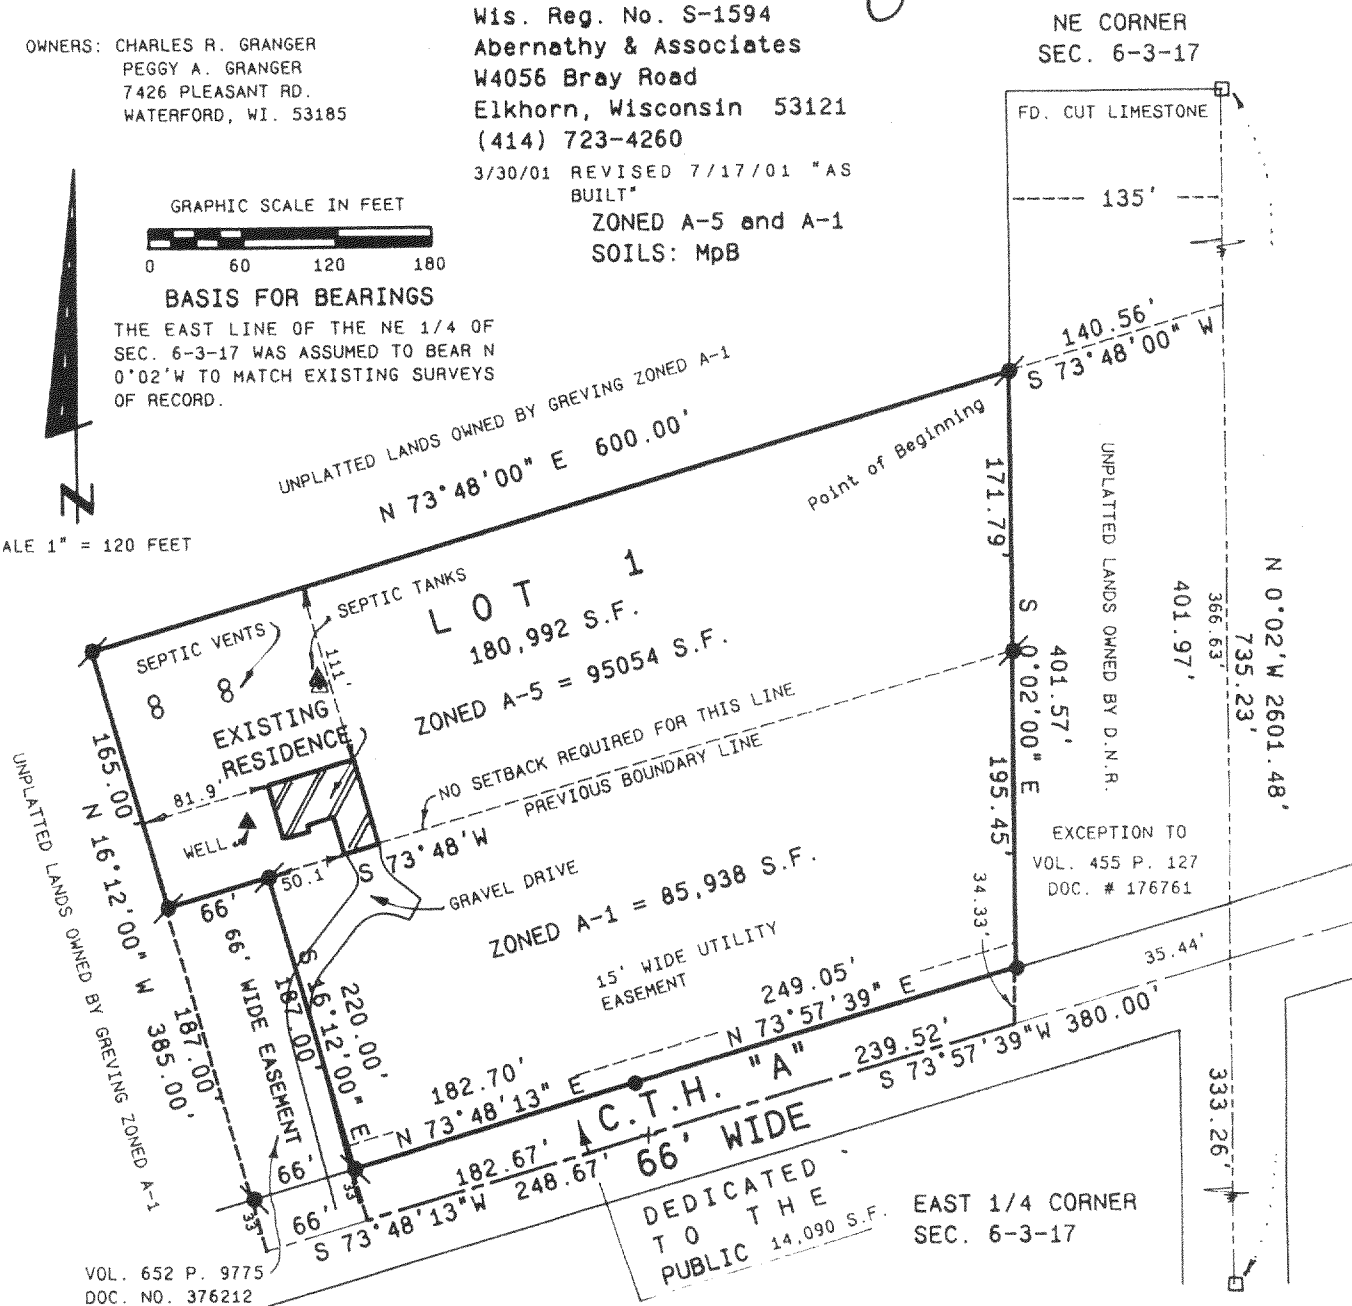


LEGEND

- SET 3/4" DIA. IRON ROD, 24" LONG, WEIGHING 1.5 lbs./ lin. ft.
- WALWORTH COUNTY SECTION CORNER FOUND
- ▲ SOIL BORING
- 3/4" DIA. IRON ROD FOUND

RESTRICTIONS

- 1) No structures on A-1 zoning except minor structures.
- 2) Lot 1 shall not be further divided along the existing zoning line without rezone or Walworth County Land Management Committee approval.
- 3) The A-1 zoned area shall not be considered a separate buildable parcel.

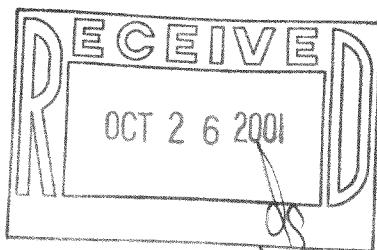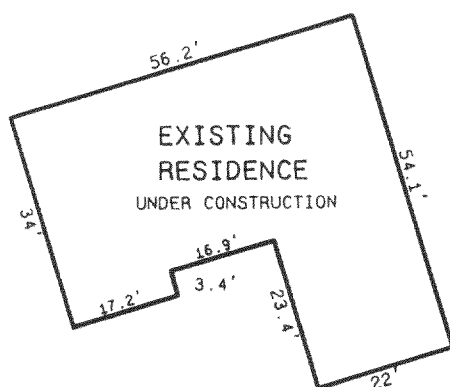

PROJ. NO. 98.109

317-522