

FARRIS, HANSEN & ASSOCIATES, INC.

ENGINEERING — ARCHITECTURE — SURVEYING
 7 RIDGWAY COURT — P.O. BOX 437 — ELKHORN, WISCONSIN 53121
 PHONE: (262) 723-2098 FAX: (262) 723-5886

PLAT OF SURVEY




LOT 91 EVERGREEN ESTATES
 A SUBDIVISION LOCATED IN
 SECTIONS 18 & 19, TOWN 3 NORTH, RANGE 17 EAST
 WALWORTH COUNTY, WI.

— WORK ORDERED BY —
 DAVID NELSON
 616 E. MARKET STREET, UNIT 103
 ELKHORN, WI. 53121



SPRUCE LANE
 66' WIDE

EDGE OF PAVE

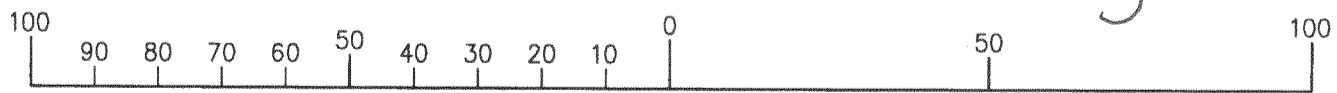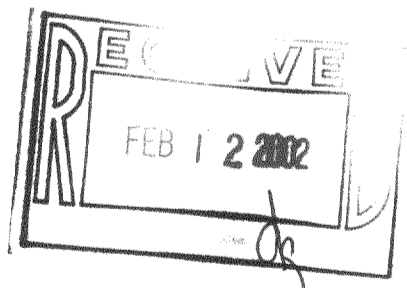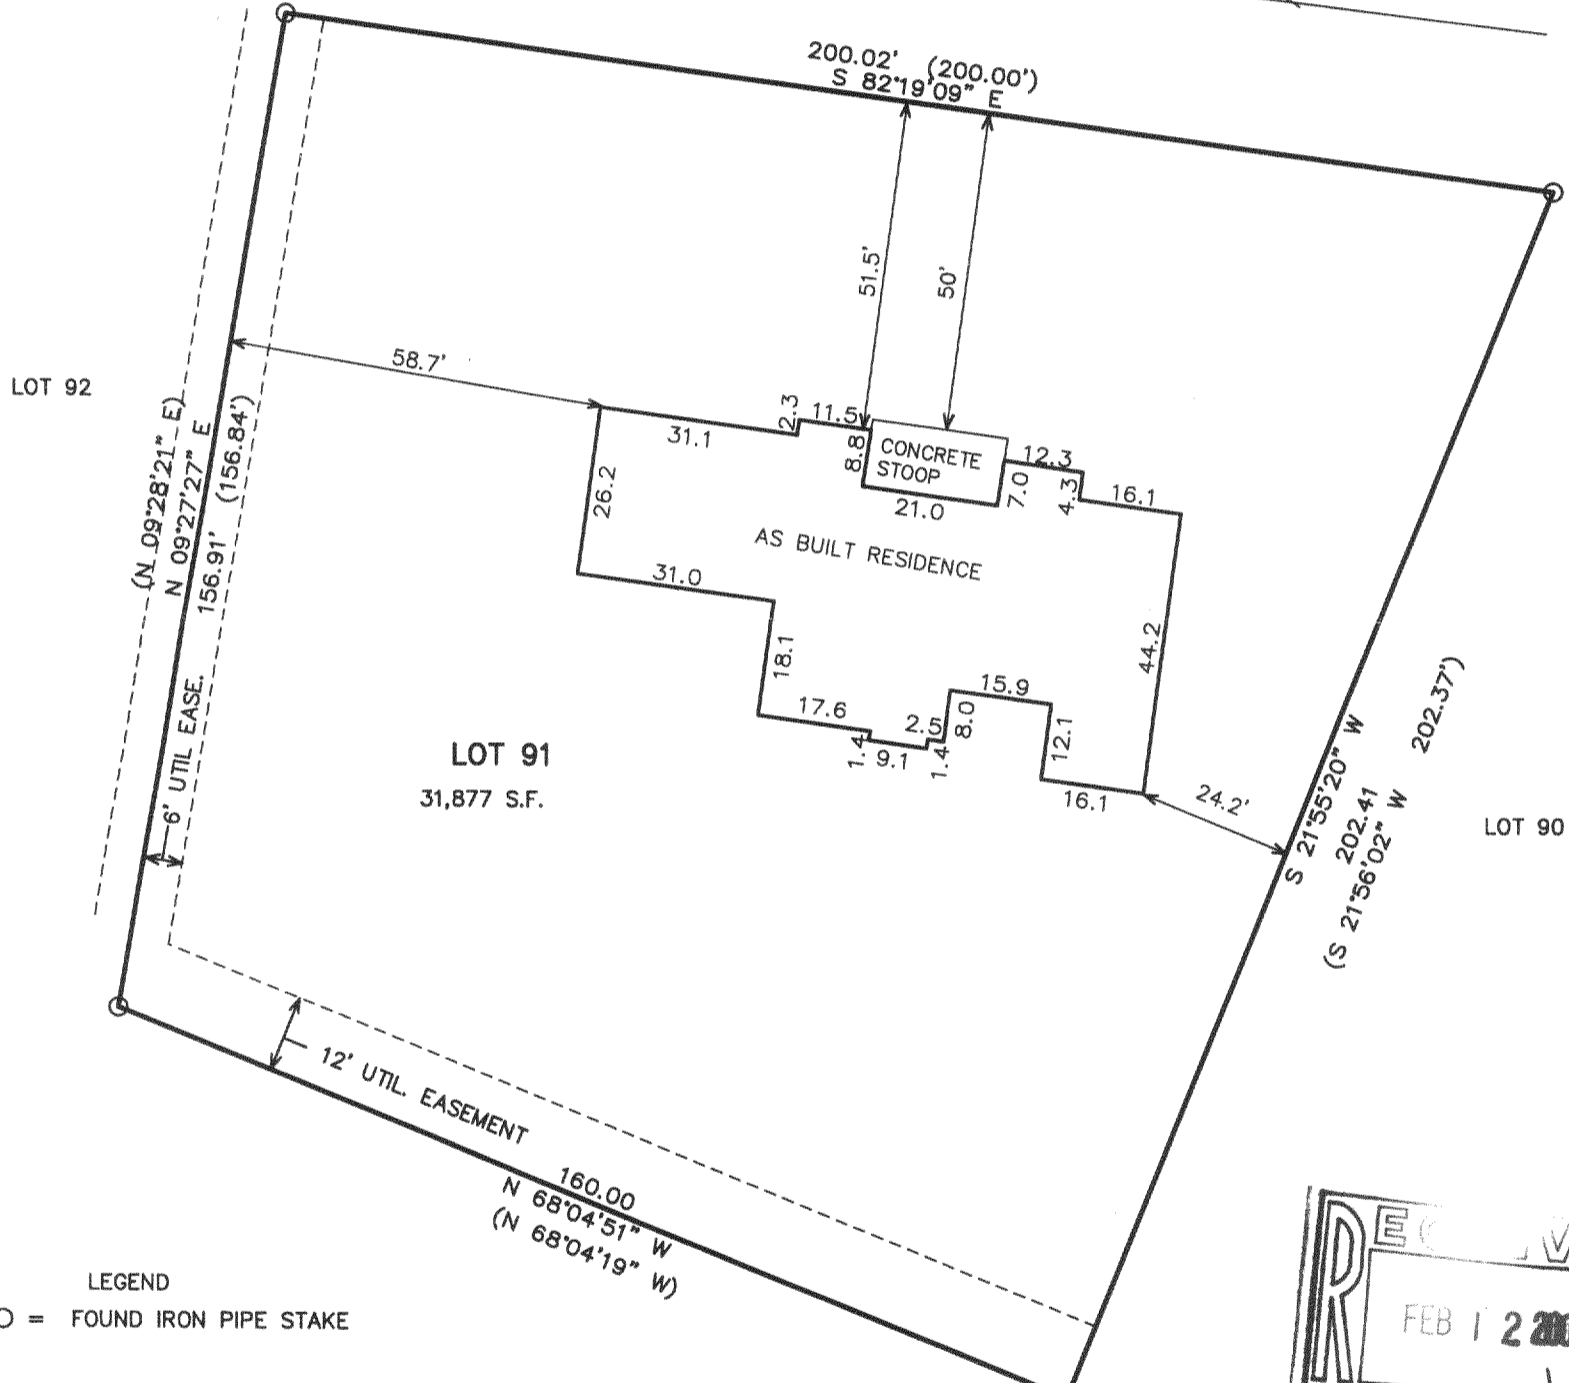

MAP SCALE IN FEET ORIGINAL 1" = 30'

NOTE: COPIES OF THIS MAP TO WHICH THE FOLLOWING CERTIFICATE WILL APPLY SHOW SURVEYOR'S ORIGINAL SEAL AND SIGNATURE IN RED INK. COPIES BY ANY OTHER MEANS MAY HAVE ALTERATIONS WHICH DO NOT REPRESENT THE SURVEYOR'S WORK PRODUCT.

I HEREBY CERTIFY THAT THE ABOVE DESCRIBED PROPERTY HAS BEEN SURVEYED UNDER MY DIRECTION AND THAT THE ABOVE MAP IS A TRUE REPRESENTATION THEREOF AND SHOWS THE SIZE AND LOCATION OF THE PROPERTY AND ITS EXTERIOR BOUNDARIES. THIS SURVEY IS MADE FOR THE USE OF THE PRESENT OWNERS OF THE PROPERTY, AND ALSO THOSE WHO PURCHASE, MORTGAGE, OR GUARANTEE THE TITLE THERETO WITHIN ONE YEAR FROM THE DATE HEREOF.

DATED: JAN 31, 2002

Peter S. Gordon
 PETER S. GORDON R.L.S. 2101

PROJECT: 5965
 DATE: 01-31-02
 SHEET 1 OF 1

x:\PROJECTS\5965\survey\DC5 01-31-02

KE-91 317-526