




PLAT OF SURVEY
LOT 1 OF CERTIFIED SURVEY MAP NO. 3401
LOCATED IN PART OF THE SW 1/4 OF THE SW 1/4 OF SECTION 6,
TOWN 3 NORTH, RANGE 17 EAST, WALWORTH COUNTY, WISCONSIN

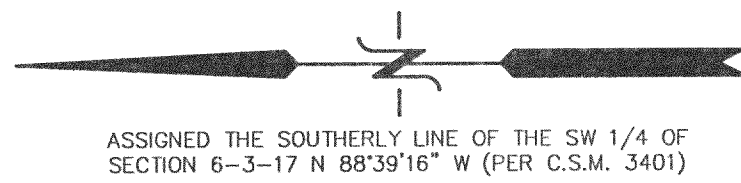

ASSIGNED THE SOUTHERLY LINE OF THE SW 1/4 OF
SECTION 6-3-17 N 88°39'16" W (PER C.S.M. 3401)

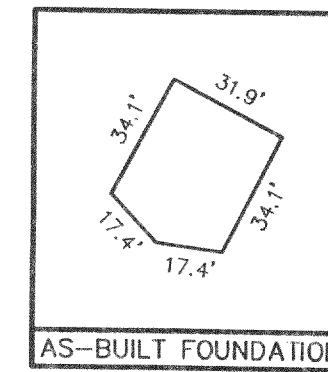

AS-BUILT FOUNDATION

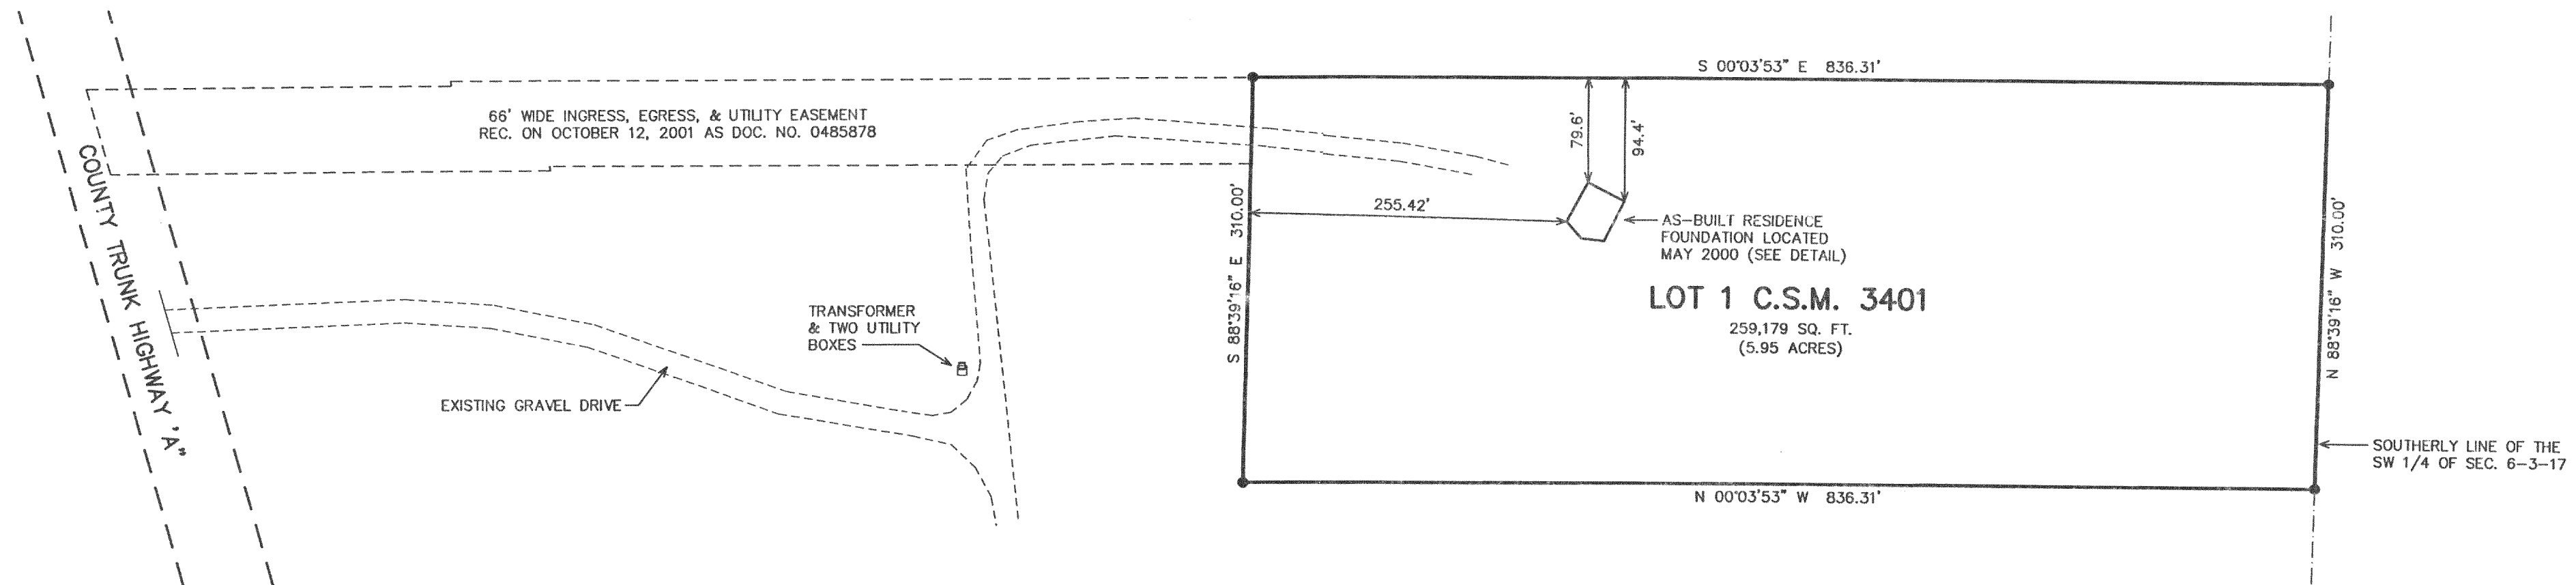

LEGEND
● = FOUND IRON REBAR STAKE
{xxx} = RECORDED AS






NOTE: COPIES OF THIS MAP TO WHICH THE FOLLOWING CERTIFICATE WILL APPLY SHOW
THE SURVEYOR'S ORIGINAL SEAL AND SIGNATURE IN RED INK. COPIES BY ANY OTHER
MEANS MAY HAVE ALTERATIONS WHICH DO NOT REPRESENT THE SURVEYOR'S WORK
PRODUCT.

I HEREBY CERTIFY THAT THE ABOVE DESCRIBED PROPERTY HAS BEEN SURVEYED UNDER
MY DIRECTION AND THAT THE ABOVE MAP IS A TRUE REPRESENTATION THEREOF AND
SHOWS THE SIZE AND LOCATION OF THE PROPERTY, ITS EXTERIOR BOUNDARIES, THE
LOCATION OF ALL VISIBLE STRUCTURES, AND DIMENSIONS OF ALL PRINCIPLE
BUILDINGS THEREON, BOUNDARY FENCES, APPARENT EASEMENTS, ROADWAYS, AND
VISIBLE ENCROACHMENTS, IF ANY. THIS SURVEY IS MADE FOR THE USE OF THE
PRESENT OWNERS OF THE PROPERTY, AND ALSO THOSE WHO PURCHASE, MORTGAGE, OR
GUARANTEE THE TITLE THERE TO WITHIN ONE YEAR FROM THE DATE HEREOF.

DATED: April 18, 2002

Peter S. Gordon
PETER S. GORDON

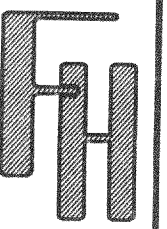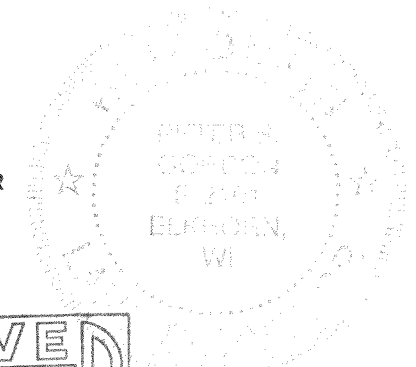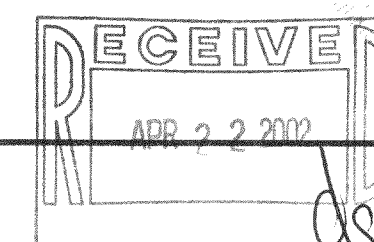

PLAT OF SURVEY

WORK ORDERED BY -
KATHY CONSOLINO
W4480 CTY. ROAD ES
ELKHORN, WI. 53121

FARRIS, HANSEN & ASSOCIATES, INC.
ENGINEERING - ARCHITECTURE - SURVEYING
7 RIDGWAY COURT P.O. BOX 437
ELKHORN, WISCONSIN 53121
OFFICE: (262) 723-2098 FAX: (262) 723-5886

REVISIONS

PROJECT NO.
5596
DATE:
04/17/2002
SHEET NO.
1 OF 1

X:\PROJECTS\5596\DCAD\SURVEY.DCS 04/17/2002

KA-3401-1 317-530