


FARRIS, HANSEN & COOPER, INC.

ENGINEERING, SURVEYING AND LAND PLANNING
715 W. WALWORTH ST. - P.O. BOX 487 - ELKHORN, WI 53121
OFFICE: 414/723-2098

LONGMEADOW ROAD - 66' WIDE

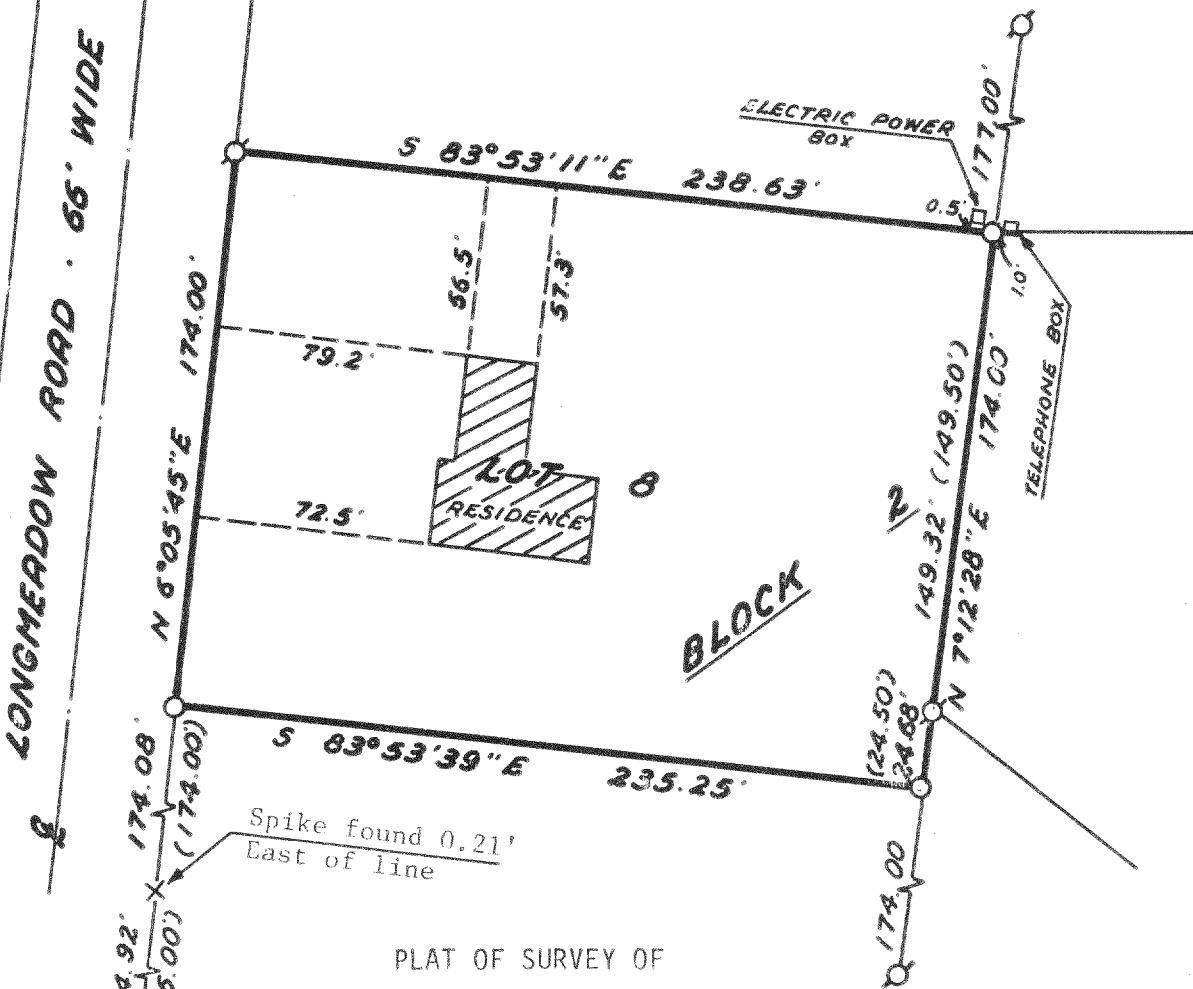

PLAT OF SURVEY OF

LOT 8, BLOCK 2, ALPINE TOWER ESTATES, TOWN 3
NORTH, RANGE 17 EAST, TOWN OF LA FAYETTE,
WALWORTH COUNTY, WISCONSIN.


ORDERED BY: Ger Mel Realty

I hereby certify that I have surveyed
the property described hereon and that
this Plat of Survey is a true and accu-
rate representation of the lot lines
and buildings to the best of my know-
ledge and belief.

Daniel D. Cooper

Daniel D. Cooper
Registered Land Surveyor, S-1464

Nov. 28, 1978
Date

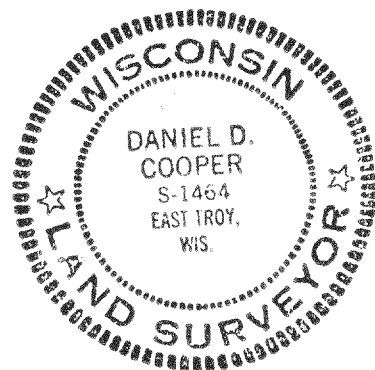

NOTE: The Easterly right-of-way line of
Longmeadow Road is assumed to bear
N 6°05'45" E as platted.

SCALE: 1"=60'

LEGEND

- ⊗—1" Dia. Iron Pipe Found
- ⊗—2" Dia. Iron Pipe Found
- ()—Record Dimension
- 1" x 24" Iron Pipe Set

DRAWING NUMBER 1432.2

317-54