


Plat of Survey

of

Lot 1 of Certified Survey Map No. 693,
recorded in Vol. 3 of Certified Survey Maps of Walworth
County on Page 196 and located in the Northwest 1/4
of Section 3 and the Northeast 1/4 of Section 4, Town 3
North, Range 17 East, Town of LaFayette, Walworth
County, Wisconsin.

Surveyed for: **American Classic Properties, Inc.**
2068 Division Street
East Troy, Wisconsin. 53120

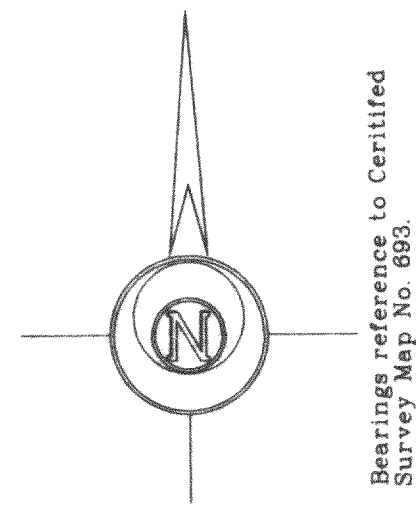




Survey Date: August 23, 2001.
Revisions:

Scale in Feet
1" = 60'
0' 30' 60' 120'

Jensen & Olson Land Surveying, LLC
45 South Wisconsin Street
Elkhorn, Wisconsin. 53121
P.O. Box 322
Telephone (262) 723-3434
Facsimile (262) 723-8044

Legend
Found County Section Corner
Found Iron Pipe
Set Wood Stake
Recorded Information
Utility Pedestal
Concrete Surface
Asphalt
Gravel

Sheet 1 of 1 Sheets
Job Reference Number
2001.118
2001.118

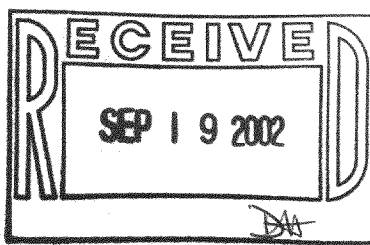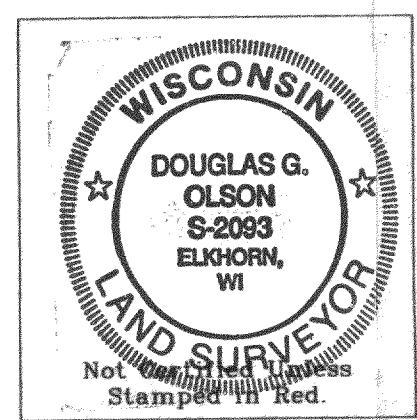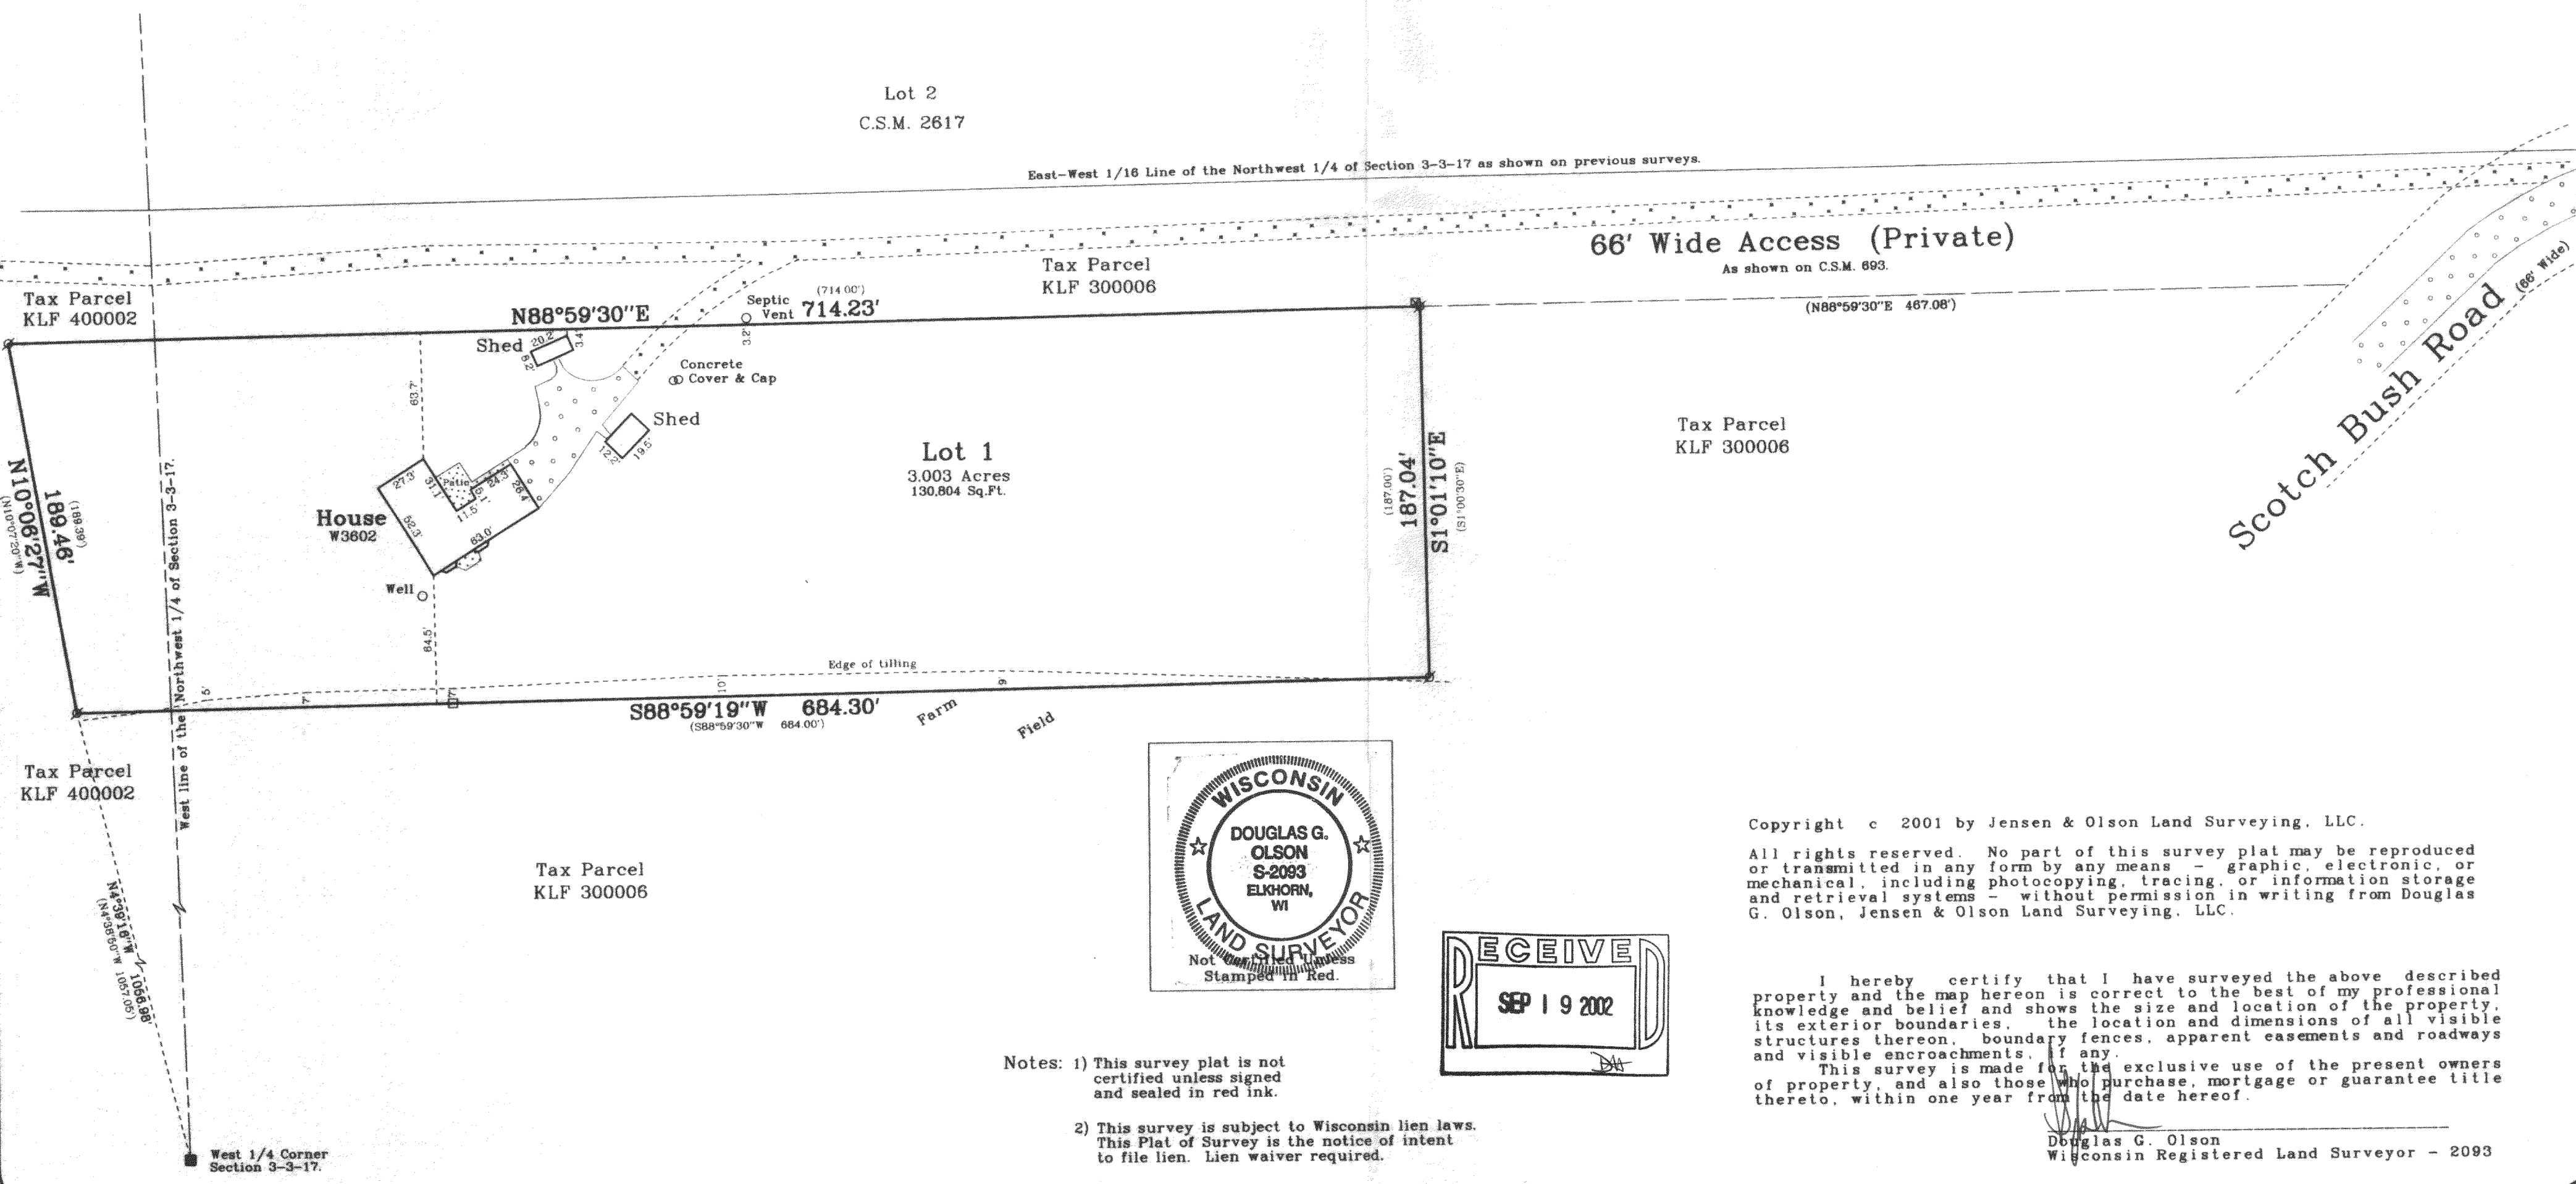

- Notes: 1) This survey plat is not certified unless signed and sealed in red ink.
- 2) This survey is subject to Wisconsin lien laws. This Plat of Survey is the notice of intent to file lien. Lien waiver required.

Copyright © 2001 by Jensen & Olson Land Surveying, LLC.

All rights reserved. No part of this survey plat may be reproduced or transmitted in any form by any means - graphic, electronic, or mechanical, including photocopying, tracing, or information storage and retrieval systems - without permission in writing from Douglas G. Olson, Jensen & Olson Land Surveying, LLC.

I hereby certify that I have surveyed the above described property and the map hereon is correct to the best of my professional knowledge and belief and shows the size and location of the property, its exterior boundaries, the location and dimensions of all visible structures thereon, boundary fences, apparent easements and roadways and visible encroachments, if any.

This survey is made for the exclusive use of the present owners of property, and also those who purchase, mortgage or guarantee title thereto, within one year from the date hereof.

Douglas G. Olson
Wisconsin Registered Land Surveyor - 2093