



FARRIS, HANSEN, & ASSOCIATES, INC.
ENGINEERING, ARCHITECTURE, SURVEYING
7 RIDGWAY COURT — P.O. BOX 437, ELKHORN, WISCONSIN, 53121
PHONE: (414) 723-2098 FAX: (414) 723-5886

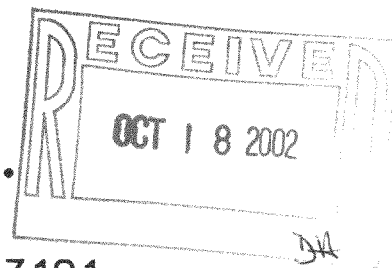

— WORK ORDERED BY —
TERONOMY BUILDERS
PO BOX 479
EAST TROY, WI. 53120

PERMIT PLAT
LOT 1 CSM 3169
PART OF THE NE 1/4 OF THE SW 1/4
SECTION 4, TOWN 3 NORTH, RANGE 17 EAST
WALWORTH COUNTY, WISCONSIN

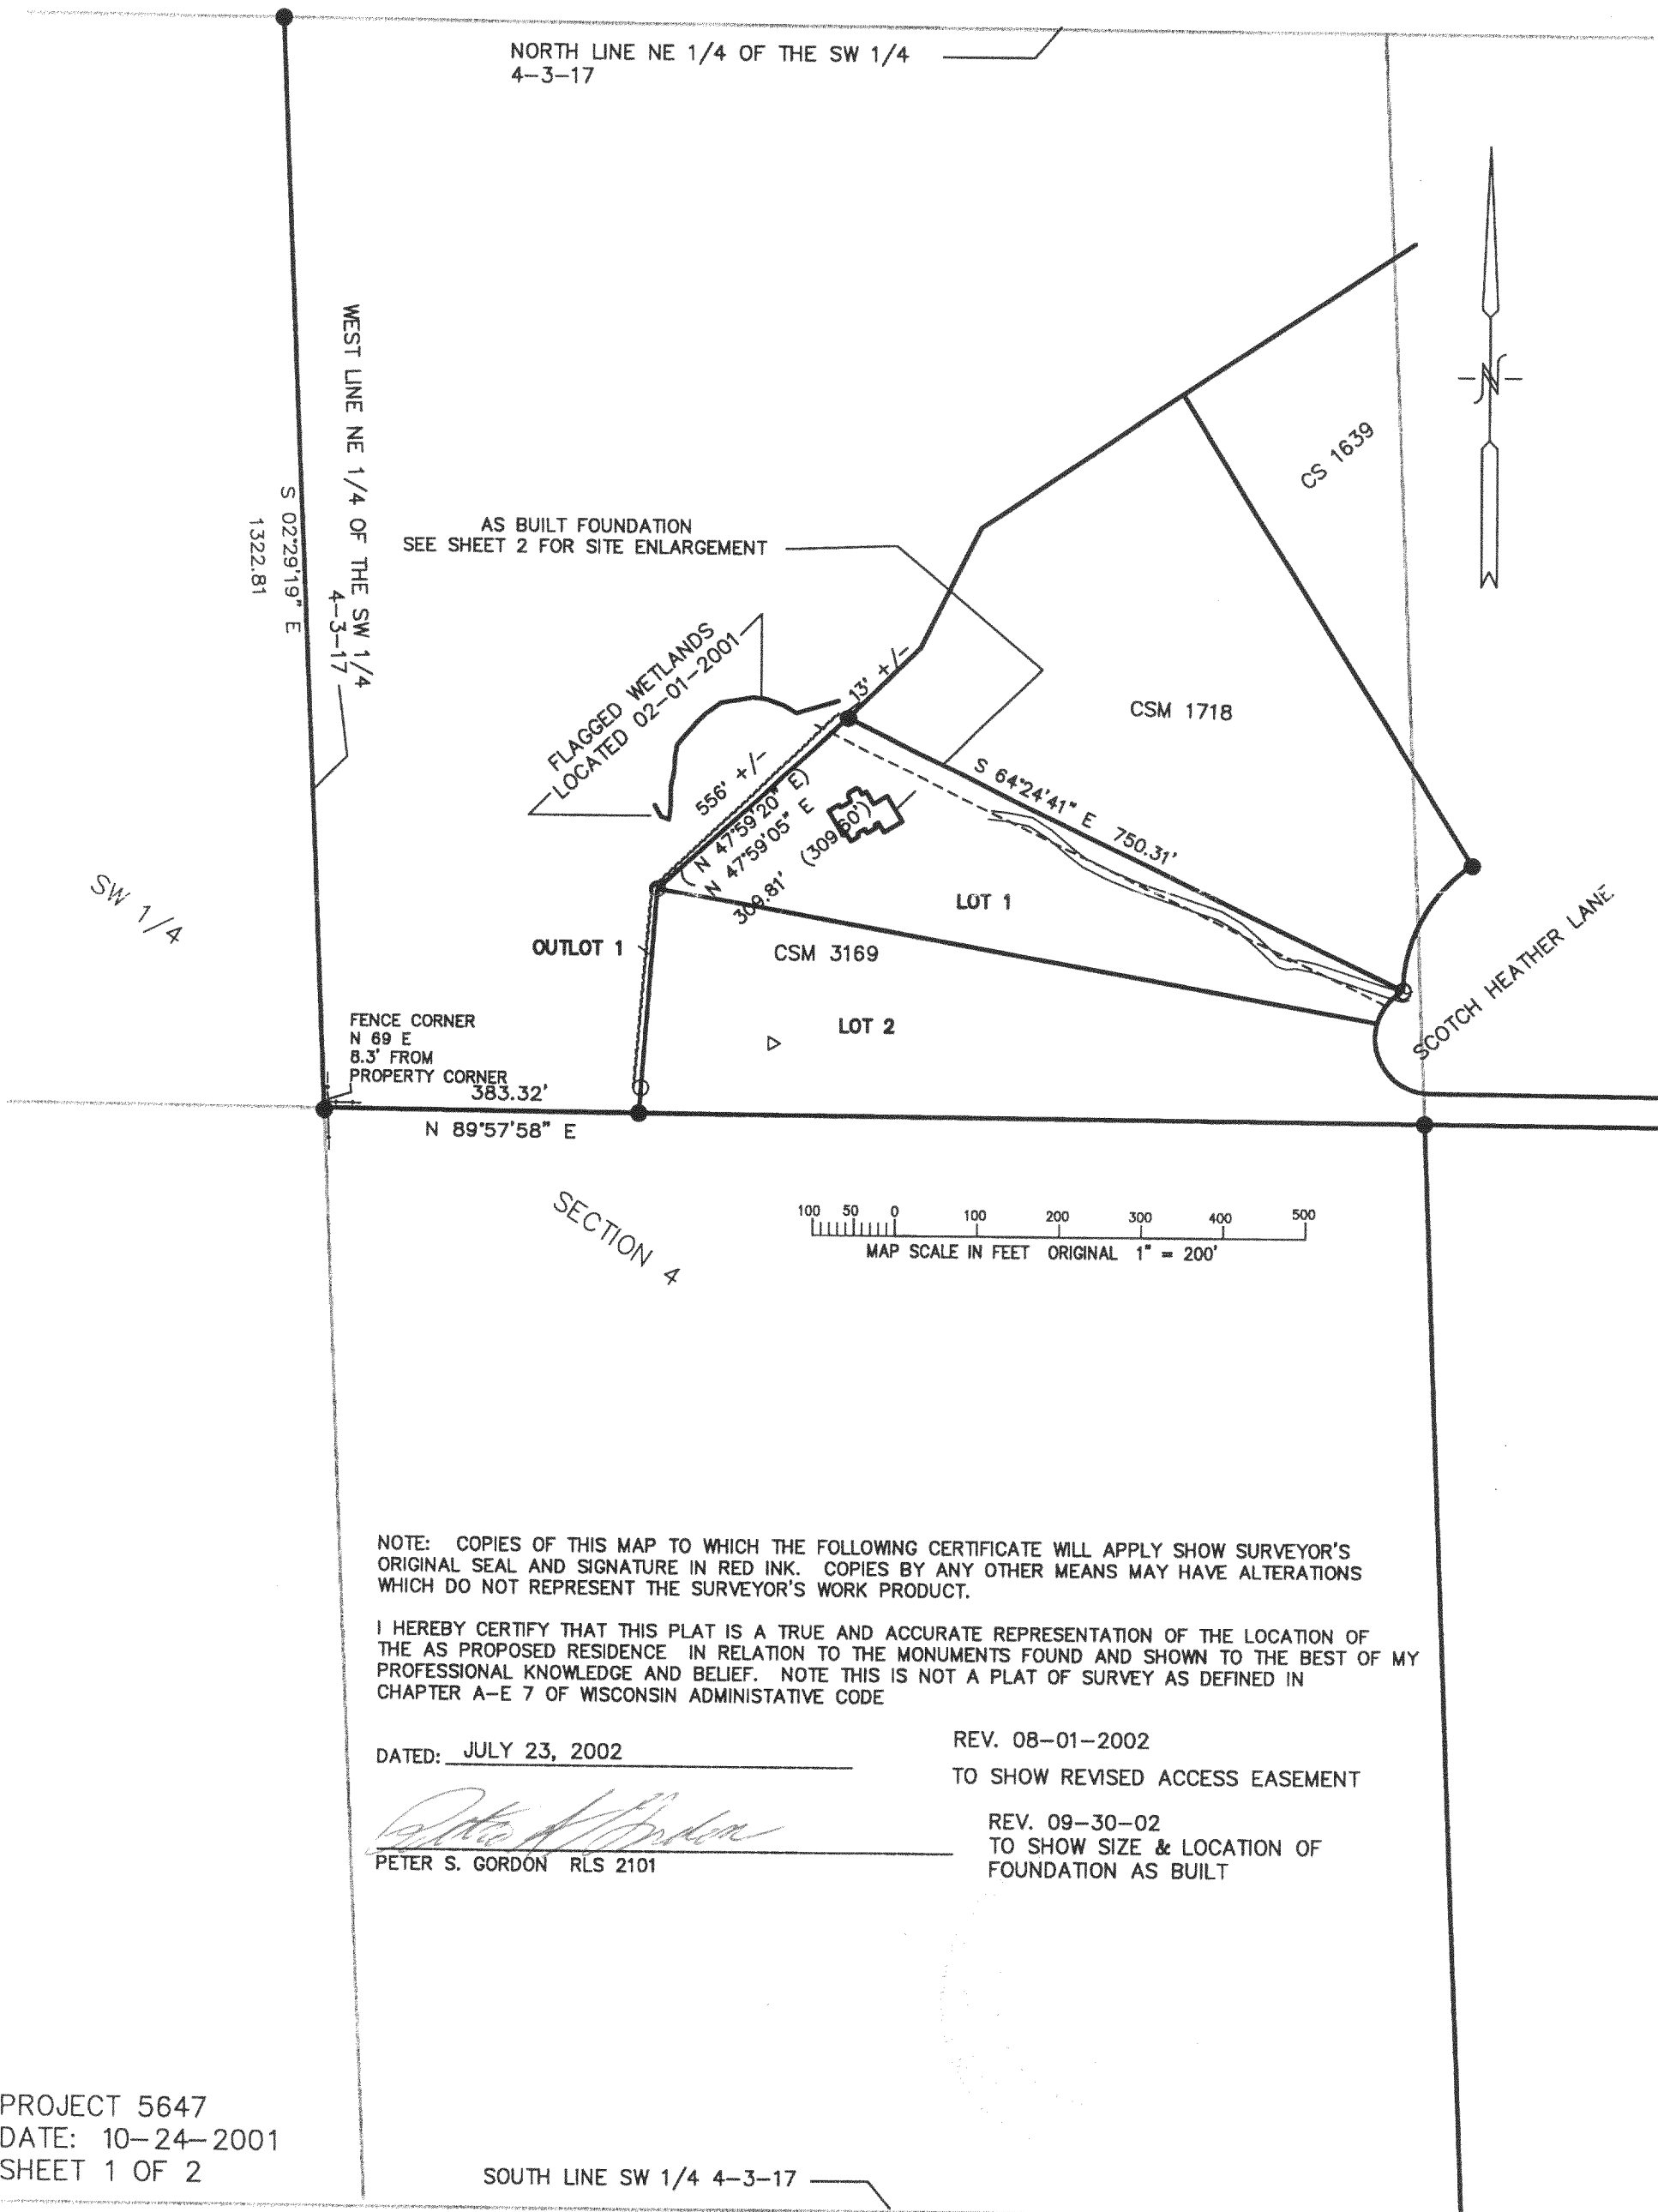

PROJECT 5647
DATE: 10-24-2001
SHEET 1 OF 2

SOUTH LINE SW 1/4 4-3-17

KA3169-1

317-554

FARRIS, HANSEN, & ASSOCIATES, INC.
ENGINEERING, ARCHITECTURE, SURVEYING
7 RIDGWAY COURT — P.O. BOX 437, ELKHORN, WISCONSIN, 53121
PHONE: (414) 723-2098 FAX: (414) 723-5886

LEGAL DESCRIPTION
SANITARY SEWER EASEMENT AREA

AN EASEMENT FOR THE CONSTRUCTION AND MAINTENANCE OF A PRIVATE SANITARY SEWER SYSTEM, BEING A PART OF TAX PARCEL LF-4-4, LOCATED IN THE SW 1/4 OF SECTION 4, TOWN 3 NORTH, RANGE 17 EAST, WALWORTH COUNTY, WISCONSIN. SAID EASEMENT TO BENEFIT LOT 1 OF CERTIFIED SURVEY MAP NO. 3169, RECORDED AS DOCUMENT NO. 432454 OF WALWORTH COUNTY CERTIFIED SURVEYS, DESCRIBED AS FOLLOWS:
BEGINNING AT THE SOUTHWEST CORNER OF SAID LOT 1; THENCE NORTH, 200 FEET; THENCE EAST 230 FEET MORE OR LESS TO THE NORTHWEST CORNER OF SAID LOT 1; THENCE SOUTHWESTERLY TO THE POINT OF BEGINNING.

