

PREPARED FOR:


H & R CONSTRUCTION
1629 SHERMAN RD.
JACKSON, WI
53037

PLAT OF SURVEY

- OF -

J.K. SURVEYING INC.
N3705 WILLOWBEND LANE
LAKE GENEVA, WI, 53147
262-248-3697

UNIT 33 OF PHASE 2 ROLLING GREEN ESTATES, A CONDOMINIUM
LOCATED IN, THE SOUTHEAST 1/4 AND THE SOUTH WEST 1/4 OF
SECTION 18, TOWN 3 NORTH, RANGE 17 EAST, TOWN OF LAFAYETTE
WALWORTH COUNTY, WISCONSIN.

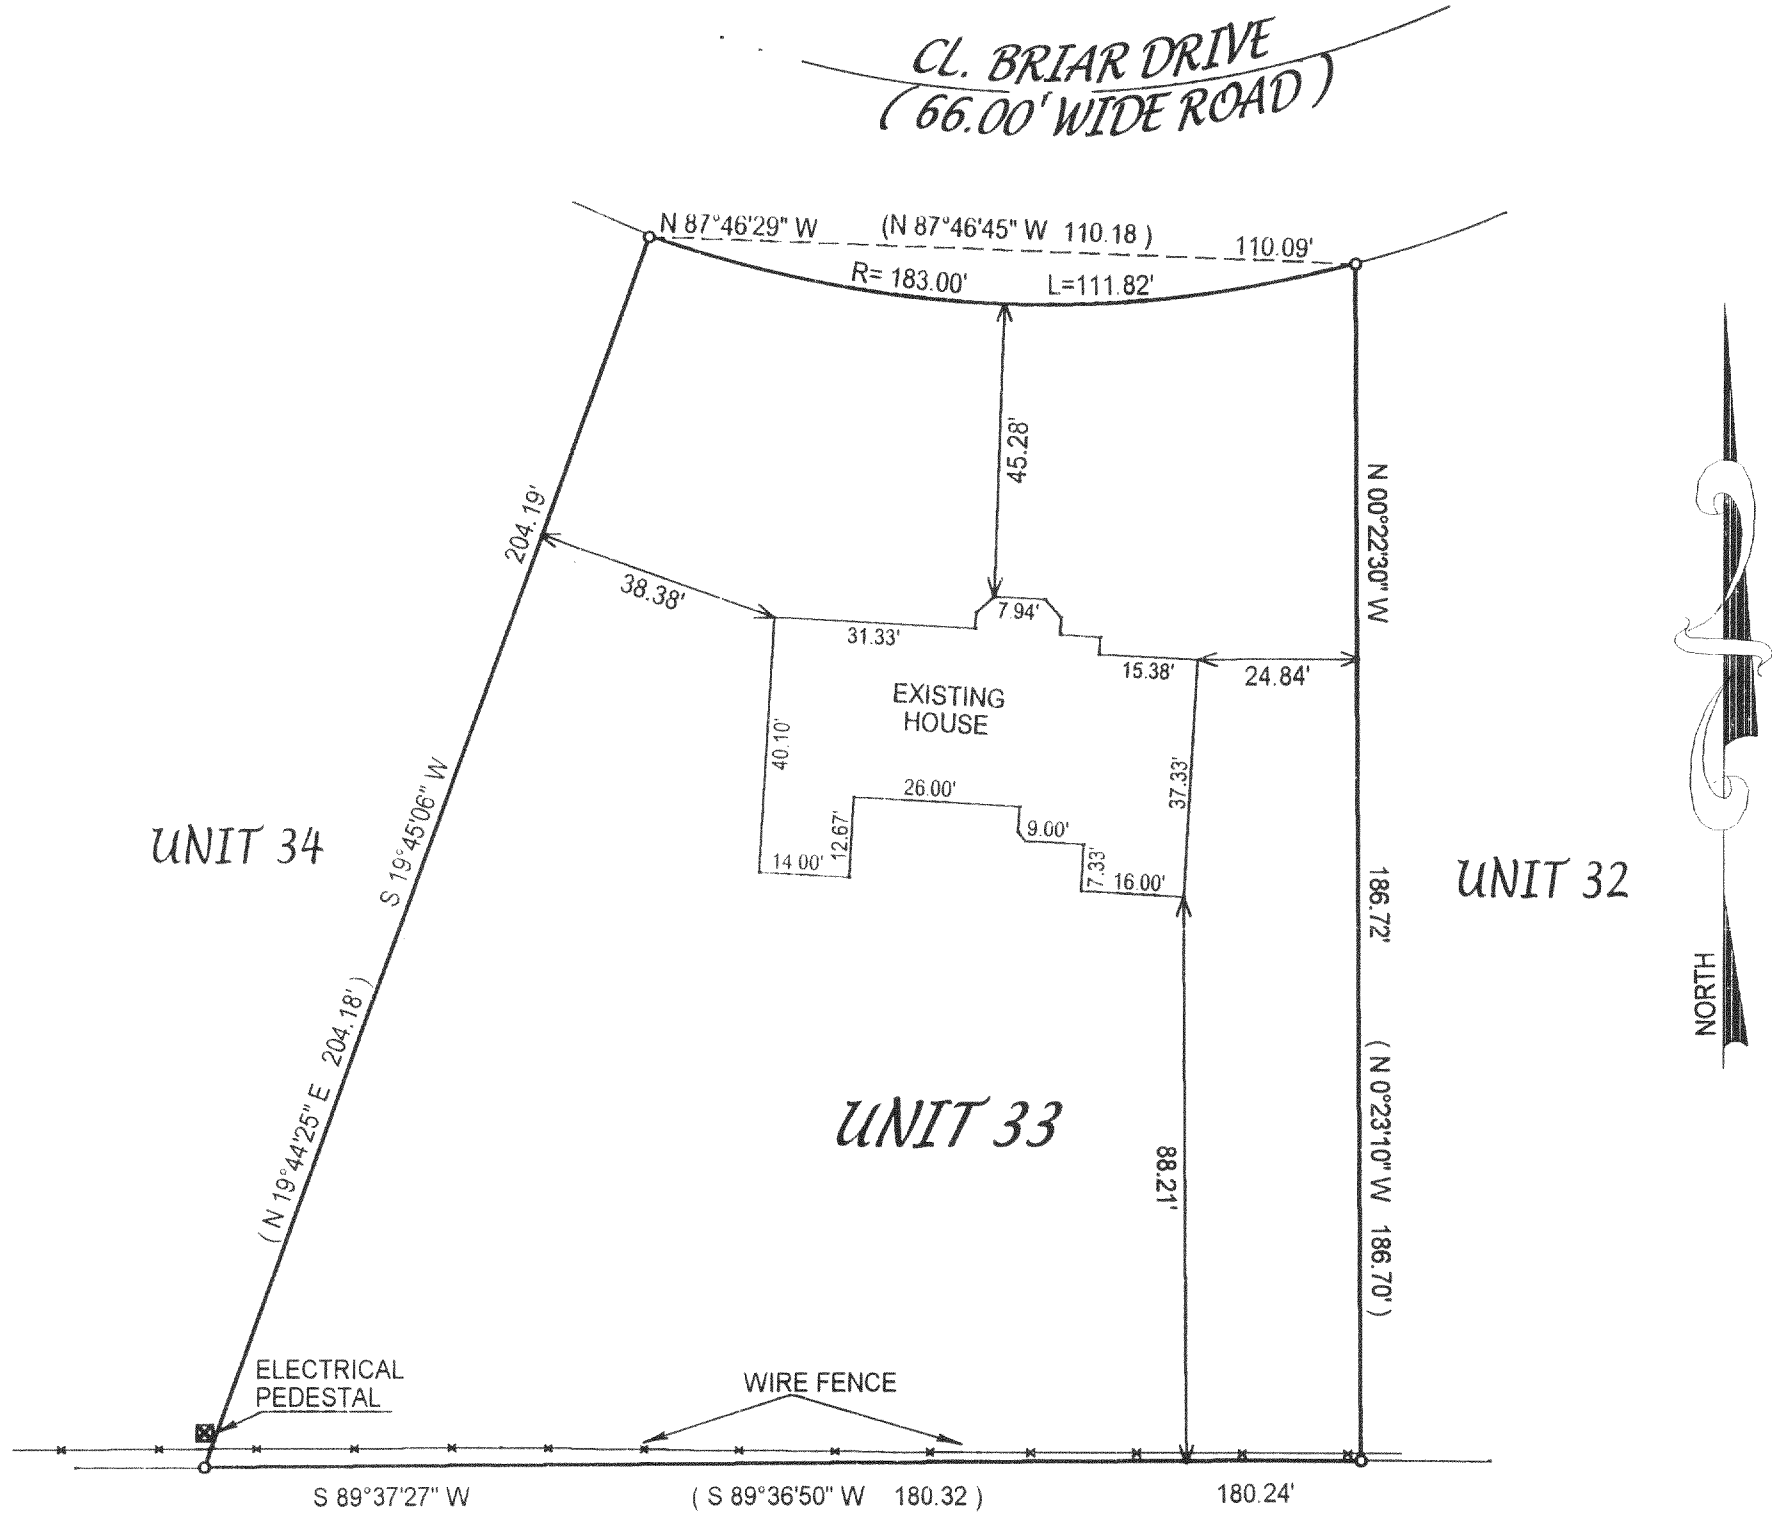

- () = recorded as
- = found iron bar
- = found iron pipe
- = set iron pipe
- = set iron bar

SCALE 1" = 30'

JOB # 01-357PH2

TAX ID # KRG 00033


DATE OF LAST REVISION 2 / 27 / 2003
REVISED 12 / 17 / 2002
REVISED 11 / 21 / 2002

COMPARE LEGAL DESCRIPTION ABOVE AND DRAWING WITH DEED. FOR BUILDING RESTRICTIONS AND
EASEMENTS NOT SHOWN REFER TO DEED. ABSTRACT SOURCES AND LOCAL MUNICIPAL CODES NOTIFY
THE SURVEYOR IMMEDIATELY OF ANY DISCREPANCY.

"I hereby certify that I have surveyed the above described property and that
the above map is a true representation thereof and shows the size and
location of all visible structures, apparent easements and encroachments
if any."

This survey is made for the present owners of the property, and those who
purchase, mortgage, or guarantee the title thereto, within one year from
the date hereof.

DATED THIS 24TH, DAY OF AUGUST 2001.

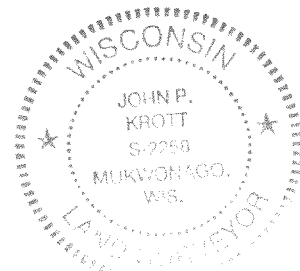

John P. Krott
JOHN KROTT S - 2258
Wisconsin Registered Land Surveyor
(original if signed in red)

317-572