


PLAT OF SURVEY

J.K. SURVEYING INC.
N3705 WILLOWBEND LANE
LAKE GENEVA, WI, 53147
262-248-3697

PREPARED FOR:
DOUG AND KELLY BOUCAT

- OF -

LOT 2 OF WALWORTH COUNTY CERTIFIED SURVEY MAP NUMBER 2345 AS RECORDED
IN VOLUME 11 OF CERTIFIED SURVEYS, PAGES 250 AND 251 AT THE WALWORTH COUNTY
REGISTRAR OF DEEDS, BEING A REDIVISION OF LOT 15 OF BLOCK 2 OF ALPINE TOWER
ESTATES, BEING A SUBDIVISION OF PART OF THE NORTHEAST 1/4 OF SECTION 13, TOWN
3 NORTH, RANGE 17 EAST, TOWN OF LAFAYETTE, WALWORTH COUNTY, WISCONSIN.

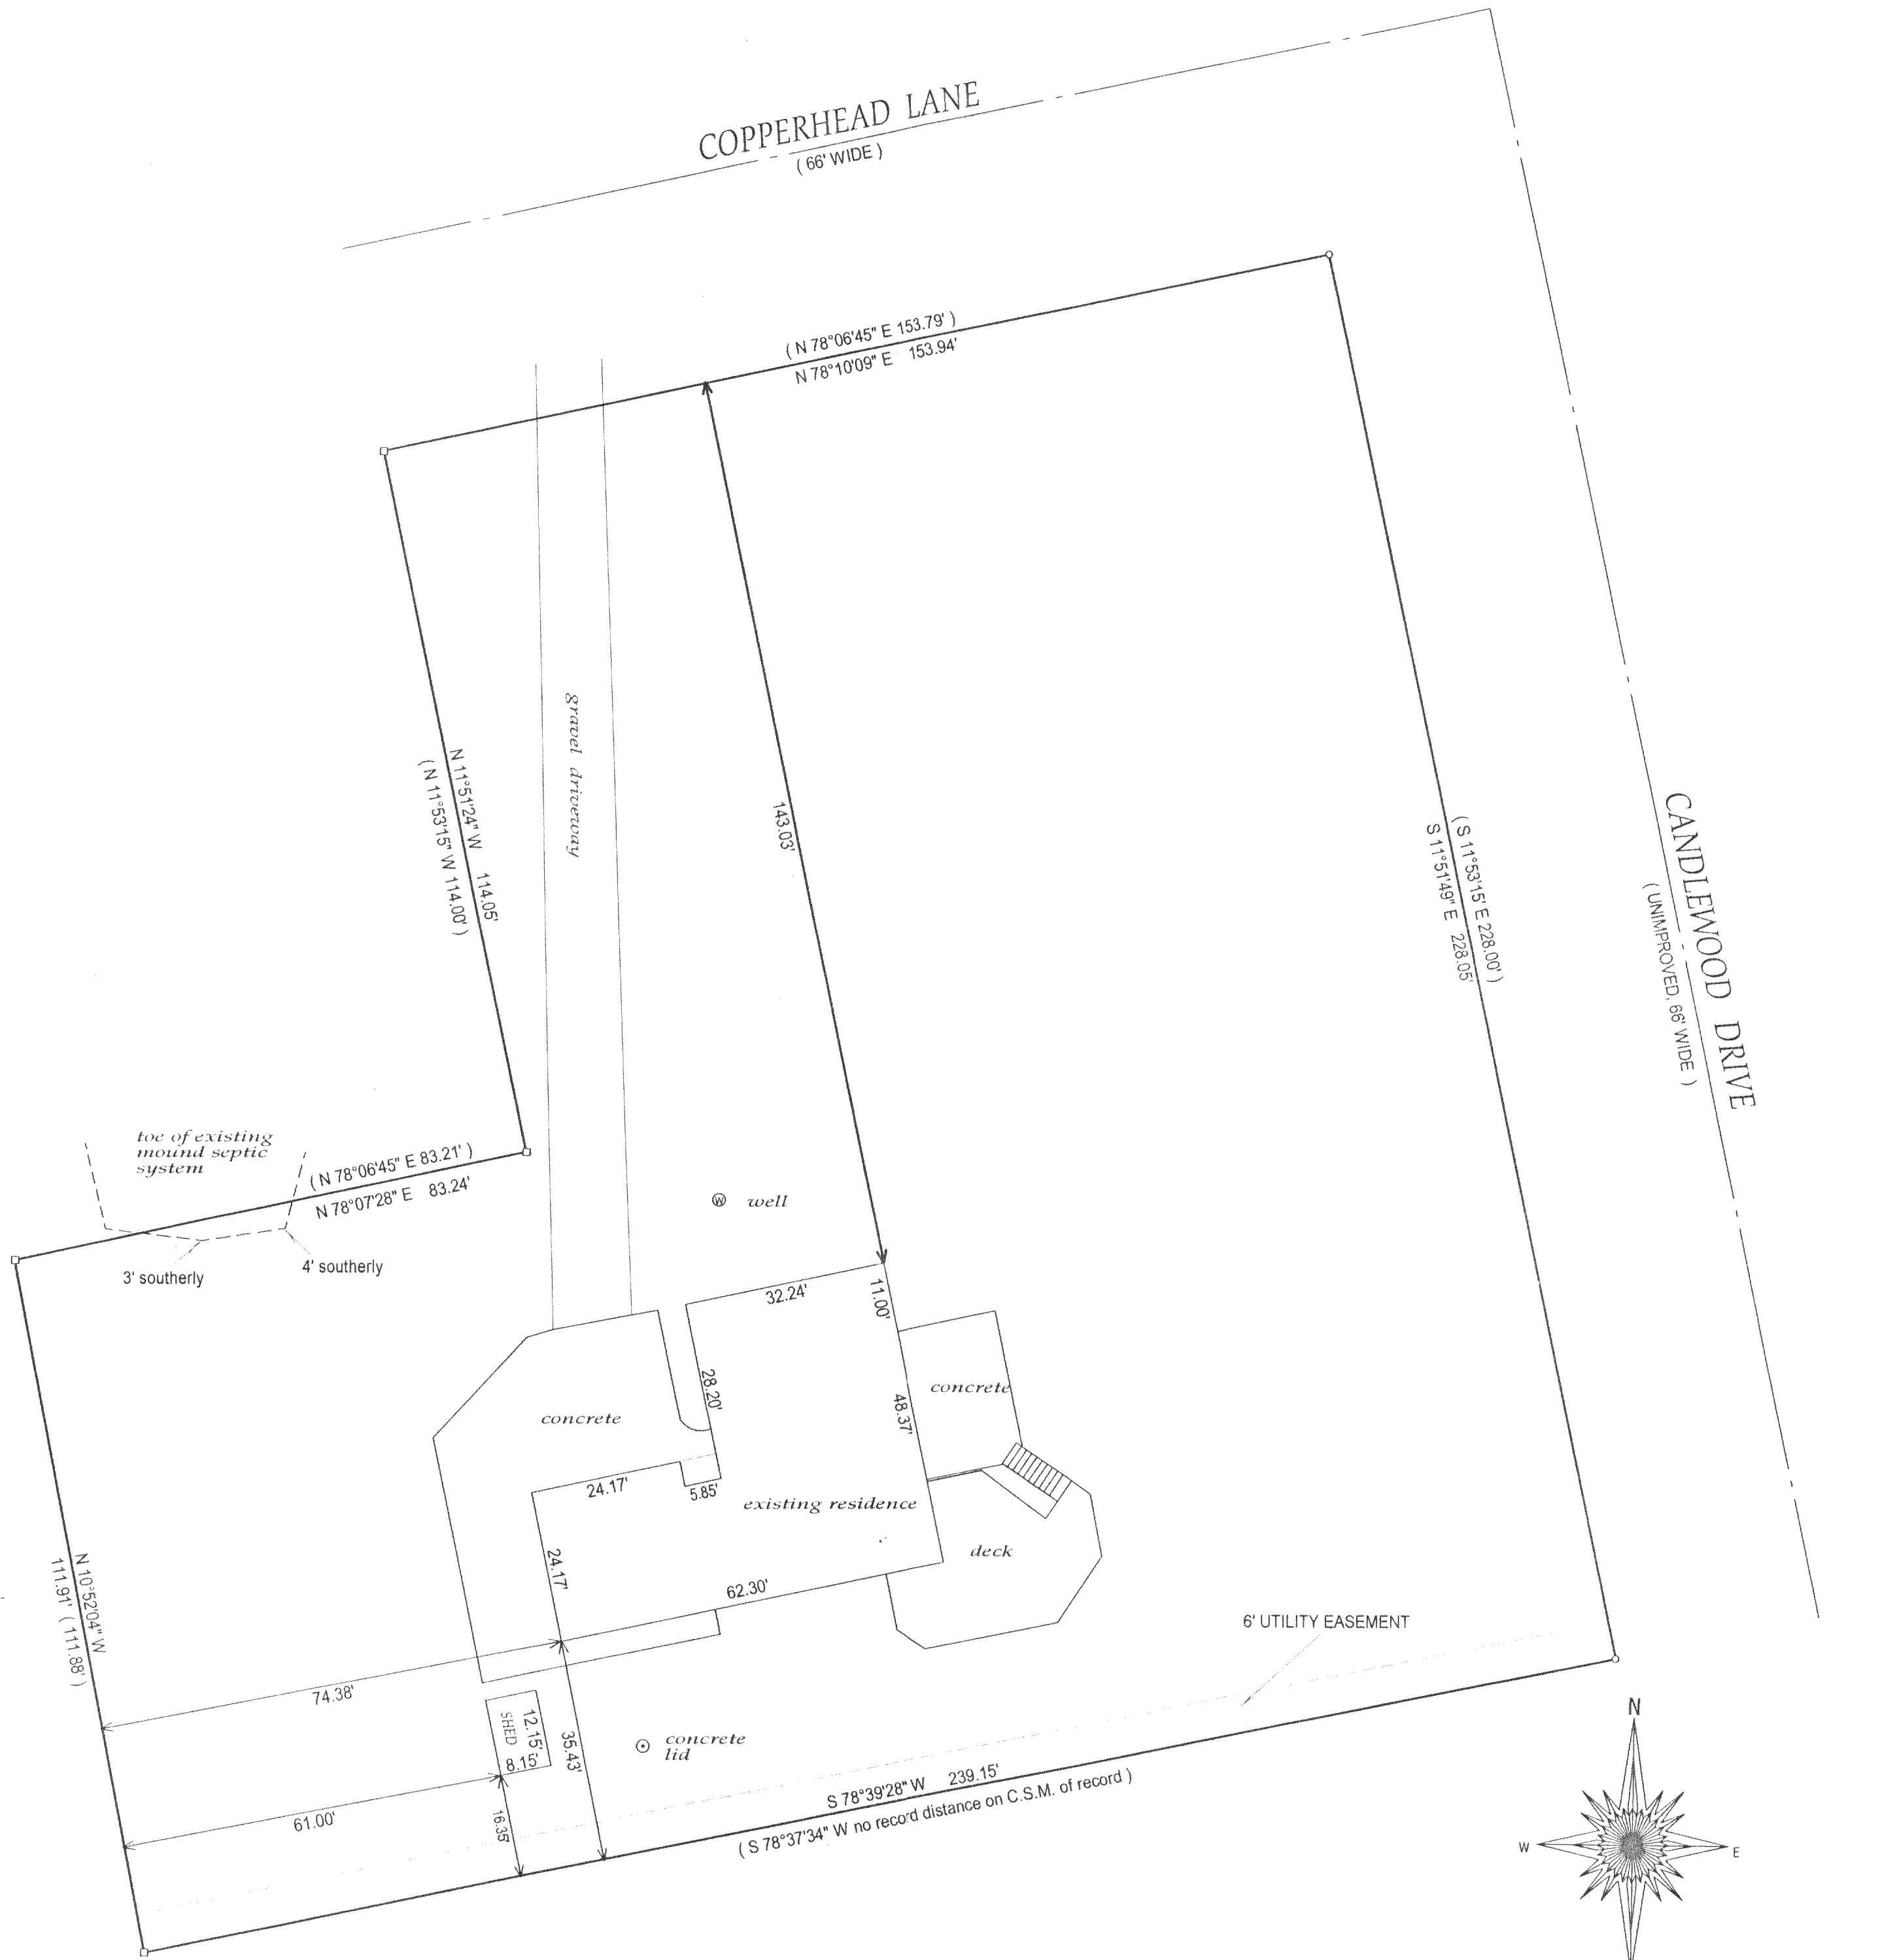

() = recorded as

○ = iron pipe found

● = iron pipe set

SCALE 1" = 20'

JOB # 03-187


TAX ID # KA 2345 00002

COMPARE LEGAL DESCRIPTION ABOVE AND DRAWING WITH DEED. FOR BUILDING RESTRICTIONS AND EASEMENTS NOT SHOWN, REFER TO DEED. ABSTRACT SOURCES AND LOCAL MUNICIPAL CODES. NOTIFY THE SURVEYOR IMMEDIATELY OF ANY DISCREPANCY.


"I hereby certify that I have surveyed the above described property and that the above map is a true representation thereof and shows the size and location of all visible structures, apparent easements and encroachments if any."

This survey is made for the present owners of the property, and those who purchase, mortgage, or guarantee the title thereto, within one year from the date hereof.

DATED THIS 16 TH, DAY OF APRIL 20 03

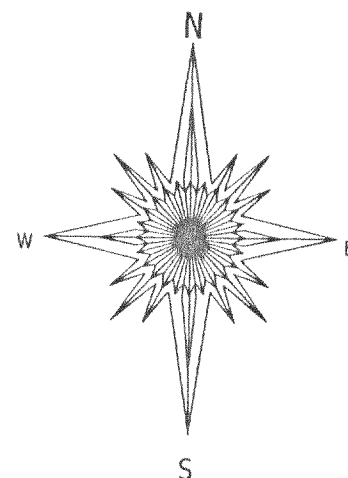

20 0 20 40 60

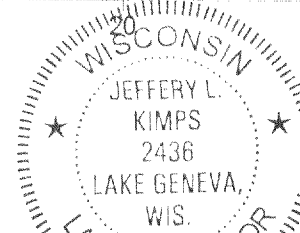

JEFFREY L. KIMPS S-2436
Wisconsin Registered Land Surveyor
(original if signed in red)

317-615