

HOLLAND & THOMAS, L.L.C. - LAND SURVEYORS

202 West Street Johnson Creek, WI 53038 (920) 699-3305

A

B

C

D


E

F

G

PLAT OF SURVEY

FOR LOT 48 OF PHASE 2 OF ROLLING GREEN COUNTRY ESTATES, PART OF THE
SE 1/4 AND SW 1/4 OF SECTION 18, TOWN 3 NORTH, RANGE 17 EAST,
TOWN OF LAFAYETTE, WALWORTH COUNTY, WISCONSIN.

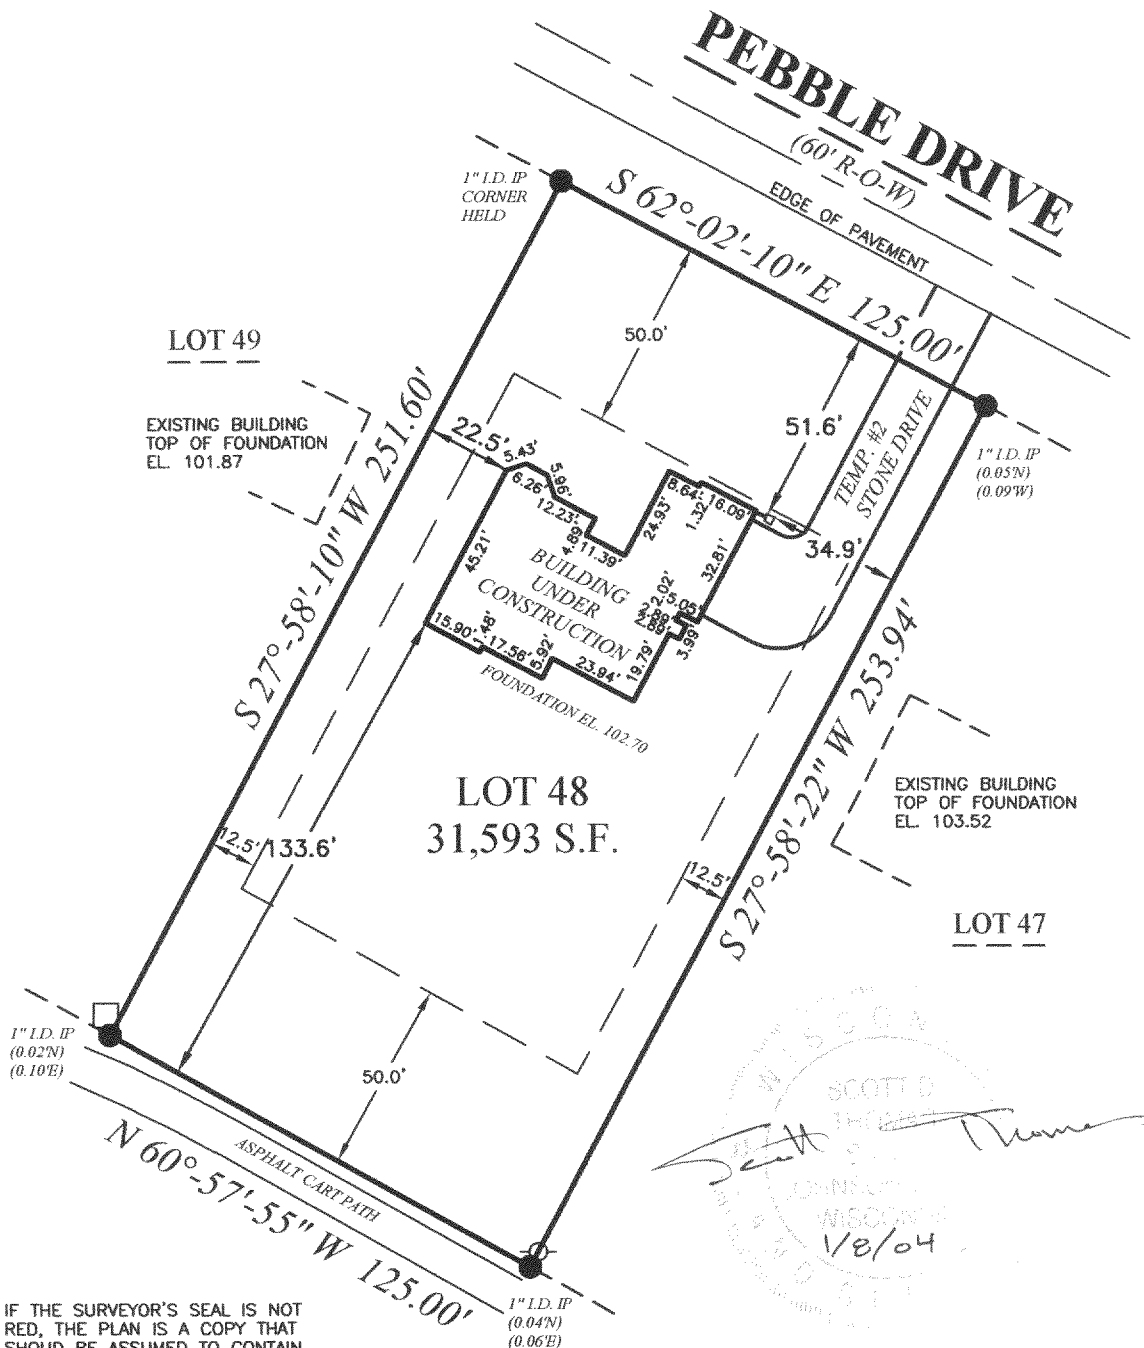

IF THE SURVEYOR'S SEAL IS NOT
RED, THE PLAN IS A COPY THAT
SHOULD BE ASSUMED TO CONTAIN
UNAUTHORIZED ALTERATIONS. THE
CERTIFICATION CONTAINED ON THIS
DOCUMENT DOES NOT APPLY TO
COPIES UNLESS THEY TOO HAVE A
RED STAMP OVER THE PHOTOCOPIED
STAMP BY SAME SURVEYOR.

BEARINGS ARE REFERENCED TO THE SOUTH LINE OF
THE NORTHWEST QUARTER OF SECTION 18-3-17,
WHICH IS ASSUMED TO BEAR S 89°-58'-05" W.



State of Wisconsin } SS.
County of Jefferson }

We, Holland & Thomas, L.L.C., do hereby certify that we have made this survey and that the information as shown on the above
Plat of Survey is a true and correct representation thereof.

LEGEND: These standard symbols may be found in the drawing.

- Lot Corner (Found) w/desc.
- ⊕ Man Hole
- ⊙ Fire Hydrant
- Utility Pedestal
- Elec. Trans. Box
- Easement Boundary
- - - Setback Line

OWNER: STEVE & DIANE YOUNG

BUILDER: ALLAN BUILDERS & DEVELOPERS
1833 EXECUTIVE DRIVE, #102
OCOMOWOC, WI 53066
PH: (262) 569-1000
FAX: (262) 569-1015
www.allanbuilders.com