

FARRIS, HANSEN & ASSOCIATES, INC.

ENGINEERING, ARCHITECTURE, SURVEYING
7 RIDGEWAY COURT – P.O. BOX 437, ELKHORN, WISCONSIN, 53121
PHONE: (414) 723-2098 FAX: (414) 723-5886


WORK ORDERED BY:
RON TANK
80 SPRUCE LANE
ELKHORN, WI. 53121

LEGAL DESCRIPTION

5. The land referred to in this policy is described as follows
Lot 80 in Evergreen Estates, a subdivision located in the Town of LaFayette, according to the recorded plat thereof, Walworth County, Wisconsin.

The following is for informational purposes only:
Address: N6090 Spruce Drive
Tax Key No. KE 00080

NOTE:
EASEMENT REC. AS DOC. 676864
DOES NOT AFFECT THE LOT SURVEYED

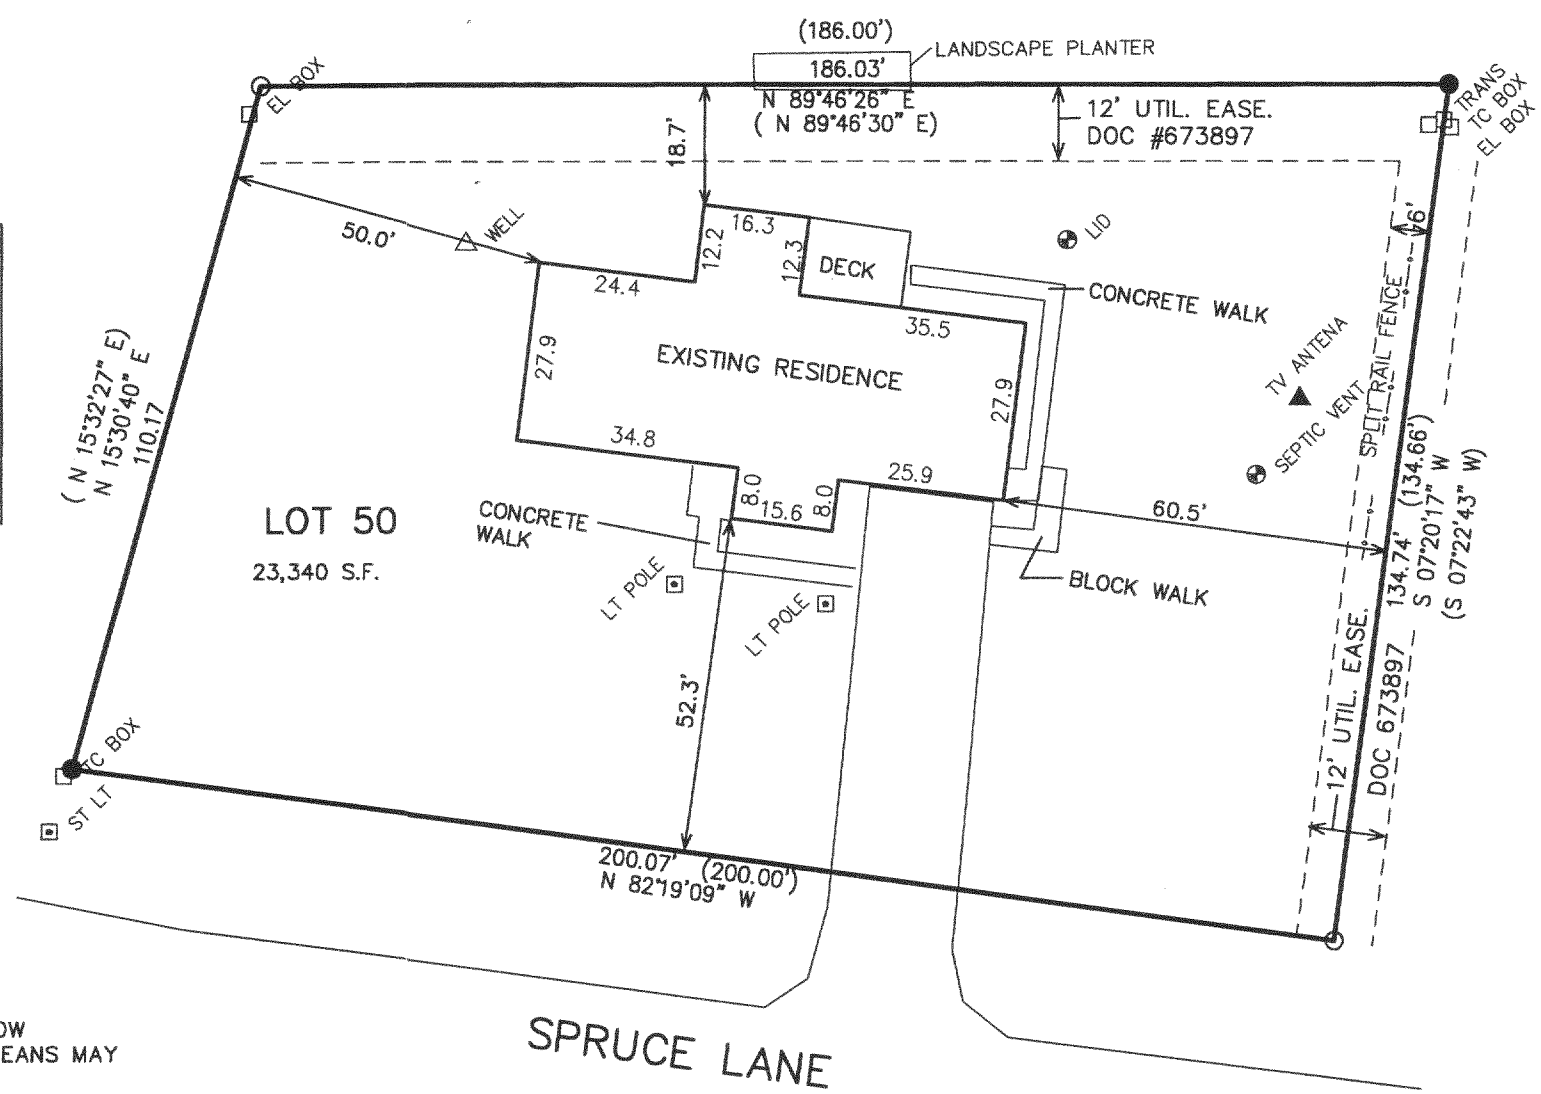

NOTE: COPIES OF THIS MAP TO WHICH THE FOLLOWING CERTIFICATE WILL APPLY SHOW SURVEYOR'S ORIGINAL SEAL AND SIGNATURE IN RED INK. COPIES BY ANY OTHER MEANS MAY HAVE ALTERATIONS WHICH DO NOT REPRESENT THE SURVEYOR'S WORK PRODUCT.


I HEREBY CERTIFY THAT THE ABOVE DESCRIBED PROPERTY HAS BEEN SURVEYED UNDER MY DIRECTION AND THAT THE ABOVE MAP IS A TRUE REPRESENTATION THEREOF AND SHOWS THE SIZE AND LOCATION OF THE PROPERTY, ITS EXTERIOR BOUNDARIES, THE LOCATION OF ALL VISIBLE STRUCTURES, AND DIMENSIONS OF ALL PRINCIPLE BUILDINGS THEREON, BOUNDARY FENCES, APPARENT EASEMENTS, ROADWAYS, AND VISIBLE ENCROACHMENTS, IF ANY. THIS SURVEY IS MADE FOR THE USE OF THE PRESENT OWNERS OF THE PROPERTY, AND ALSO THOSE WHO PURCHASE, MORTGAGE, OR GUARANTEE THE TITLE THERETO WITHIN ONE YEAR FROM THE DATE HEREOF.

DATED: JUNE 4, 2004

PETER S. GORDON R.L.S. 2101



LEGEND
○ = FOUND IRON PIPE STAKE
● = FOUND IRON BAR STAKE
(xxx) = RECORDED AS

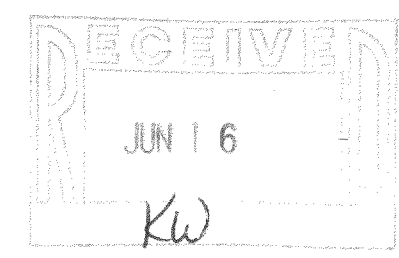

PROJECT 6576
01-05-2004
SHEET 1 OF 1

KE 00080

317-705