

ABERNATHY and ASSOCIATES


Kenneth B. Abernathy Jr.

Wisconsin Registered Land Surveyor S-1594

W4056 BRAY RD.
ELKHORN, WI. 53121
PHONE: (262) 723-4260 (OFFICE)
(262) 723-7209 (FAX)
Email: abernathy@elknet.net

PLAT OF SURVEY

LOT 2 OF CERTIFIED SURVEY MAP NO. 3159 AS RECORDED IN VOL. 17 OF CERTIFIED SURVEY MAPS AS PAGES 186-189 AS DOCUMENT NO. 431110, BEING PART OF THE SE 1/4 AND THE SW 1/4 AND THE NW 1/4 AND THE NE 1/4 OF THE NORTHWEST 1/4 OF SECTION 33, TOWN 3 NORTH, RANGE 17 EAST, TOWN OF LAFAYETTE, WALWORTH COUNTY, WISCONSIN.

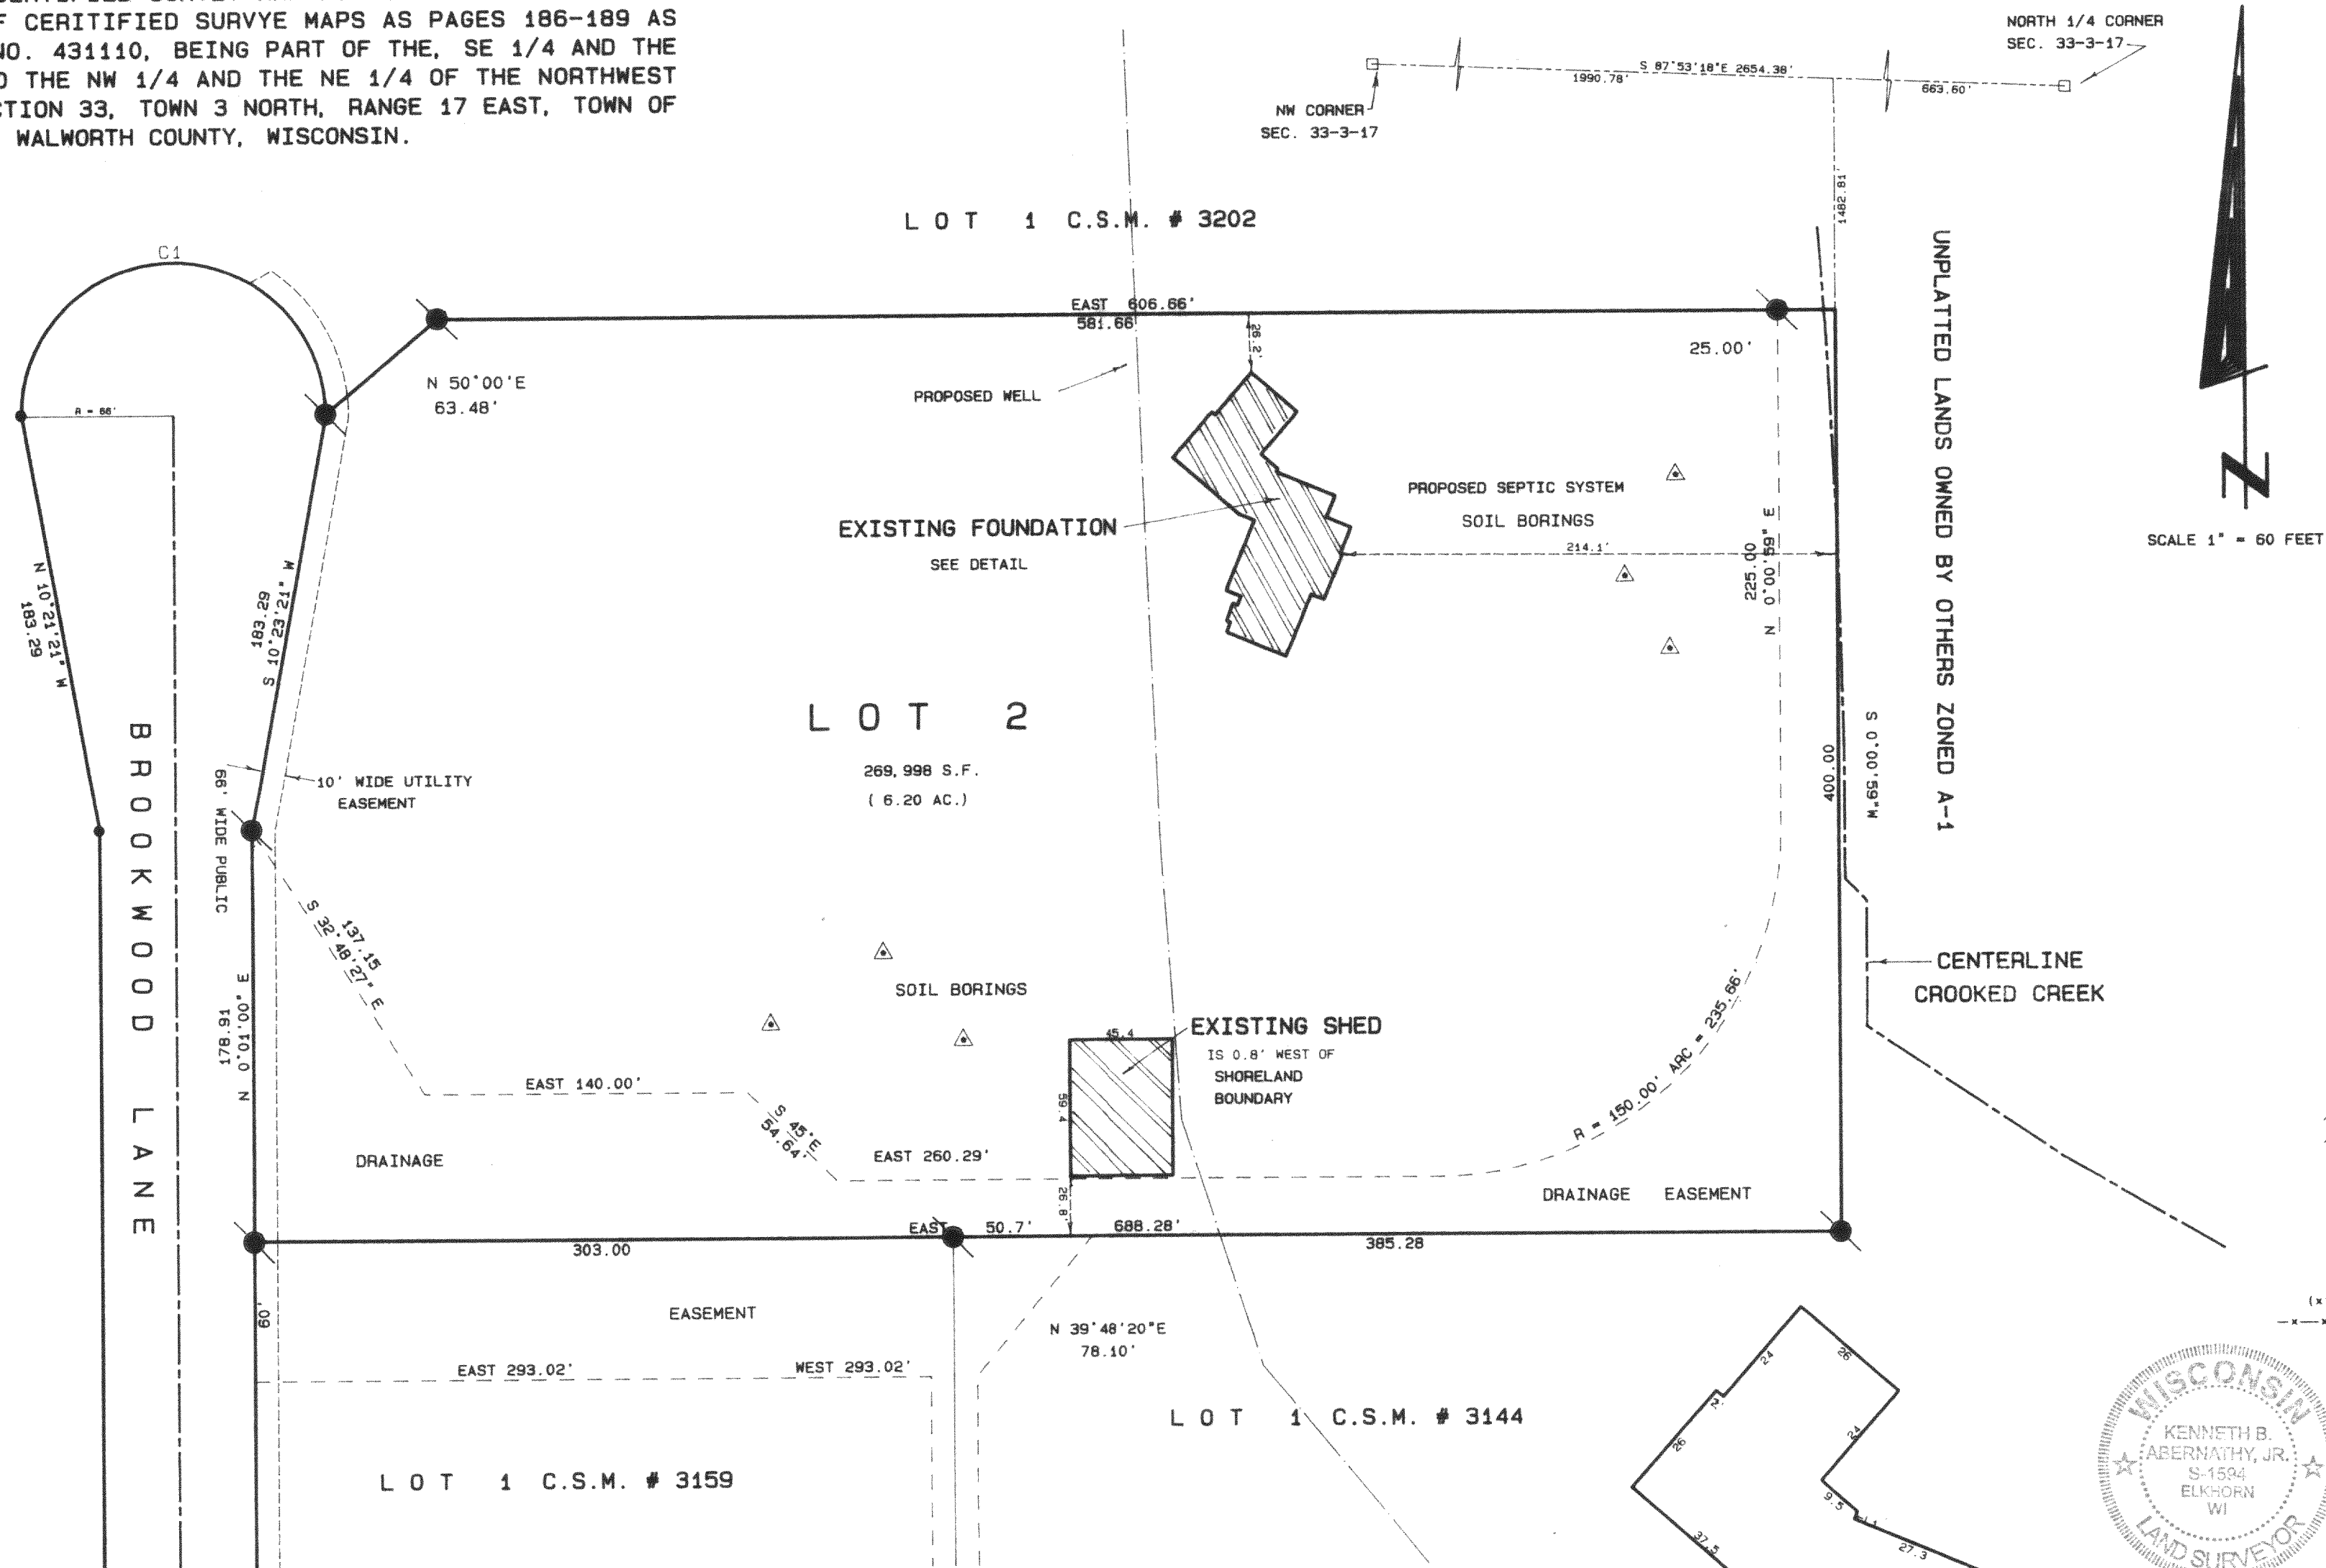

SCALE 1" = 60 FEET

Legend

- FOUND IRON PIPE
- FOUND IRON ROD
- FOUND BRASS CAPPED MONUMENT
- ⊕ FOUND CONCRETE MONUMENT
- + CHISEL CUT IN CONCRETE
- SET IRON ROD, 24" LONG, WEIGHING 1.5 LBS./LINEAL FT., 3/8" DIA.
- SET IRON ROD, 30" LONG, WEIGHING 4.5 LBS./LINEAL FT., 1-11/16" DIA.
- (xx) RECORDED AS DIMENSION
- - - EXISTING FENCE



SCALE: 1" = 60 FEET

I hereby certify that the above described property has been surveyed by me or under my direction and that the above map is a true representation thereof and shows the size and location of the property, its exterior boundaries, the location of all visible structures and dimensions of all principal buildings thereon, boundary fences, apparent easements, roadways and visible encroachments, if any. This survey is made for the use of the present owners of the property, and also those who purchase, mortgage or guarantee the title thereto within one year from date hereof.

Kenneth B. Abernathy, Jr.

KENNETH B. ABERNATHY, JR.
WISCONSIN REGISTERED LAND SURVEYOR,
S-1594

Date: SEPT. 10, 2001 Job No. 98210

REVISED 10/29/03 PROPOSED RESIDENCE AND SHED ADDED.

REVISED 12/04/2003 TO SHOW PROPOSED WELL & PROPOSED SHED

REVISED 12/15/2003 TO SHOW PROPOSED RESIDENCE & SHED


REVISED JUNE 22, 2004 TO SHOW EXISTING FOUNDATION & SHED "AS BUILT"

ORDERED BY: LAZZARONI BUILDERS.


N4236 COUNTY RD "NN"
ELKHORN, WI. 53121

OWNERS: ROBERT C. AND SUSAN E. LEIBSLE
C/O ATTY: ROBERT C. LEIBSLE
P.O. BOX 260
ELKHORN, WI. 53121

LINE	DISTANCE
L1	1.67
L2	4.67
L3	7.42

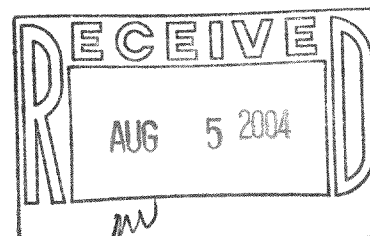

FOUNDATION DETAIL
(NO SCALE)

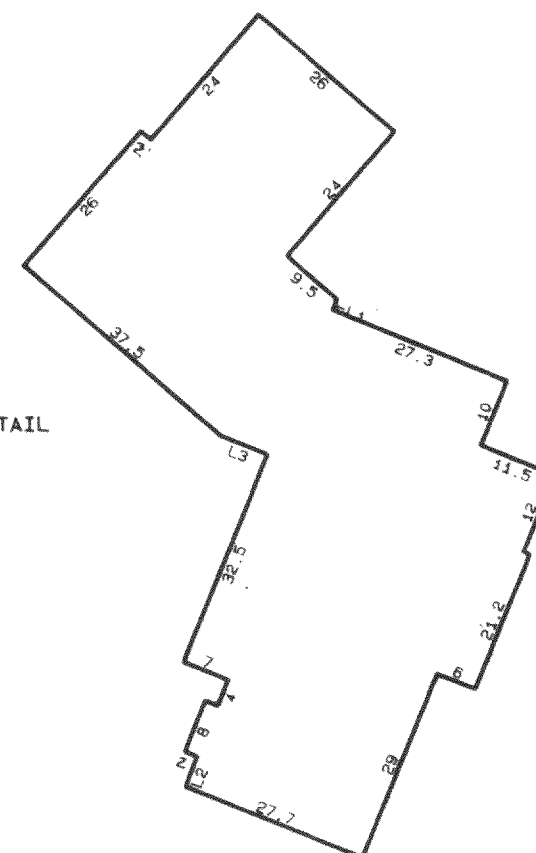

KA3159-2

317-716