


(57-8) 4

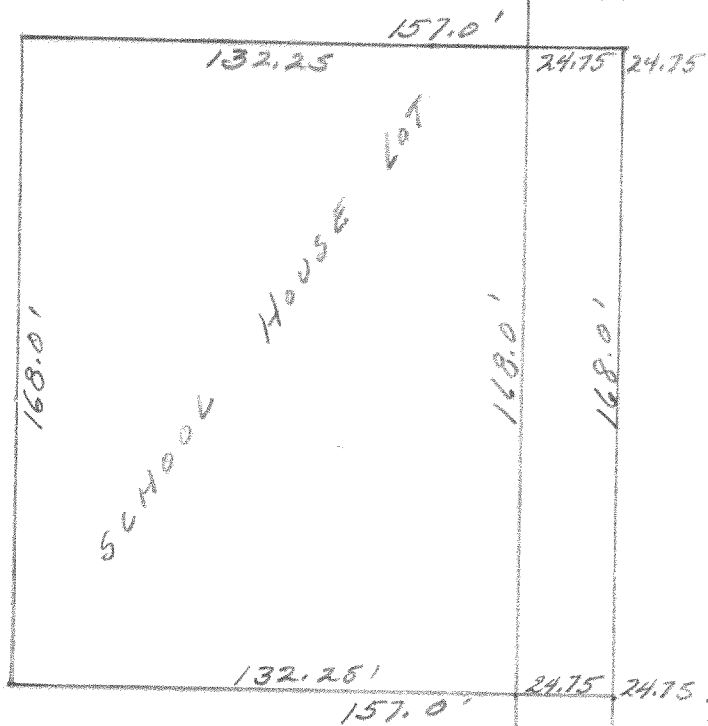

DESCRIPTION: Commencing at a point in the West; north and south 1/8 section line of Section 4, Town 3, north, Range 17 east of the 4th Principal Meridian, that is 422.0 feet north of the centerline of State Trunk Highway #15 (as of this day October 22, 1957) thence West 157.0 feet, thence North 168.0 feet, thence East 157.0 feet to a point in the aforesaid one eighth section line, thence South in said section line 168.0 feet to the place of beginning. Containing 0.60 acres more or less.

CERTIFICATE: I, hereby certify that I have on this the 22nd day of October 1957, surveyed the above described property, and find that no encroachments exist.

Joseph M. Biagi
Joseph M. Biagi, Registered Surveyor.
Elkhorn Wisconsin.

LF-9-6 (part of)

317-2 B