


DEGEN-FOAT SURVEYING LLC  
100 SOUTH SECOND STREET  
WATERFORD, WISCONSIN  
(262)534-5404 (FAX)534-2022

048112  
048112S1.DWG


# PLAT OF SURVEY

UNIT 23, PHASE 2 ROLLING GREEN COUNTRY ESTATES CONDOMINIUM A CONDOMINIUM  
LOCATED IN THE SOUTHEAST 1/4 AND SOUTHWEST 1/4 OF SECTION 18, TOWN 3 NORTH,  
RANGE 17 EAST, TOWN OF LAFAYETTE, WALWORTH COUNTY, WISCONSIN.

\* REFER TO CURRENT TITLE REPORT FOR EASEMENTS, RESTRICTIONS OR COVENANTS OF RECORD THAT MAY AFFECT THIS LAND \*  
\* ESPECIALLY THOSE NOT SHOWN ON THE RECORDED PLAT OF ROLLING GREEN ESTATES CONDOMINIUM \*

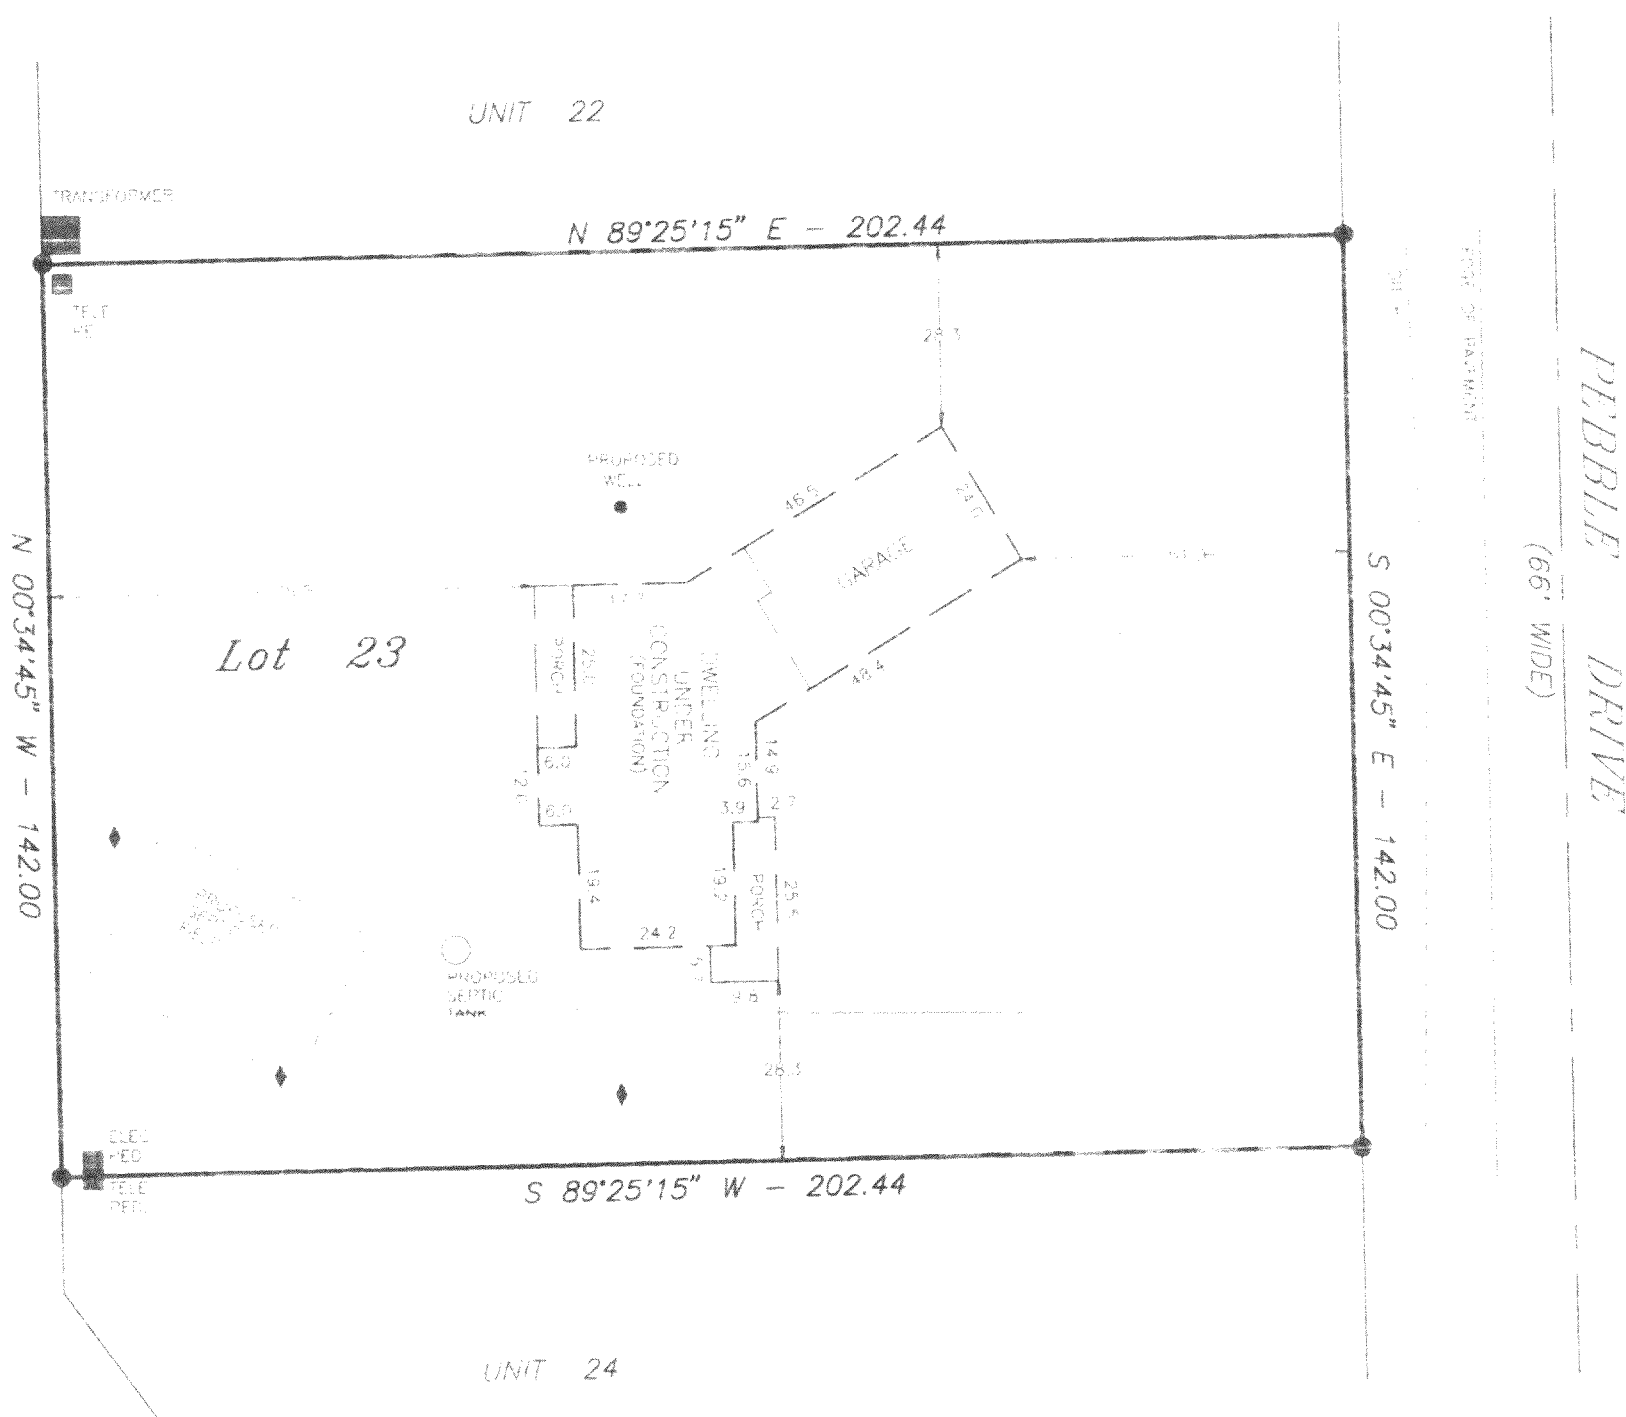

PREPARED FOR: BOB SOMERS BUILDERS  
10414 PINE RIDGE ROAD  
GREENFIELD, WI 53228

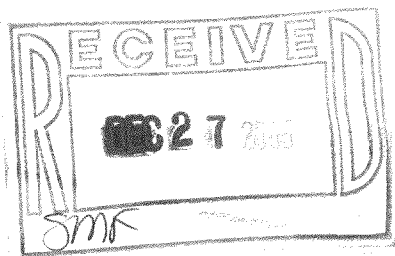

SCALE: 1" = 30'  
READING BASED AS RECORDED AS

## LEGEND

- FOUND IRON PIPE
- RECORDED AS
- ◆ SOIL BORING (SCALED FROM SOILS REPORT)

I HEREBY CERTIFY THAT I HAVE SURVEYED THE ABOVE DESCRIBED PROPERTY AND THE ABOVE MAP IS A TRUE REPRESENTATION THEREOF AND SHOWS THE SIZE AND LOCATION OF THE PROPERTY, THE LOCATION OF ALL BUILT STRUCTURES AND DIMENSIONS OF ALL PRINCIPAL BUILDINGS THEREON, BOUNDARY SERVICE LINES, EASEMENTS, ALLEYS, AND MOBILE ENCROACHMENTS, IF ANY.

THIS SURVEY IS MADE FOR THE PRESENT OWNER, IN THE KNOWLEDGE AND BELIEF THAT THERE WAS NO UNDISCOVERED INTEREST IN THE TITLE THERETO WITHIN (1) YEAR FROM THE DATE HEREOF.

DATED AT WATERFORD, WI JANUARY 05

RECORDED MARCH 31, 2005

REVISED JAN 27, 2005  
SET STAKES IN EXCAVATION  
FOR FOOTING CONTRACTOR

*Gary C. Foat*

KRG-23

317-830