


PLAT OF SURVEY

LOT 2 OF CERTIFIED SURVEY MAP NO. 3409

RECORDED IN VOL. 19 ON PG. 258 AS DOC. NO. 499638
LOCATED IN PART OF THE NW 1/4 OF THE SE 1/4 AND THE
SW 1/4 OF THE NE 1/4 OF SECTION 7, TOWN 3 NORTH,
RANGE 17 EAST, WALWORTH COUNTY, WISCONSIN

ASSIGNED WEST LINE OF THE
EAST 1/4 S 01°20'30" E

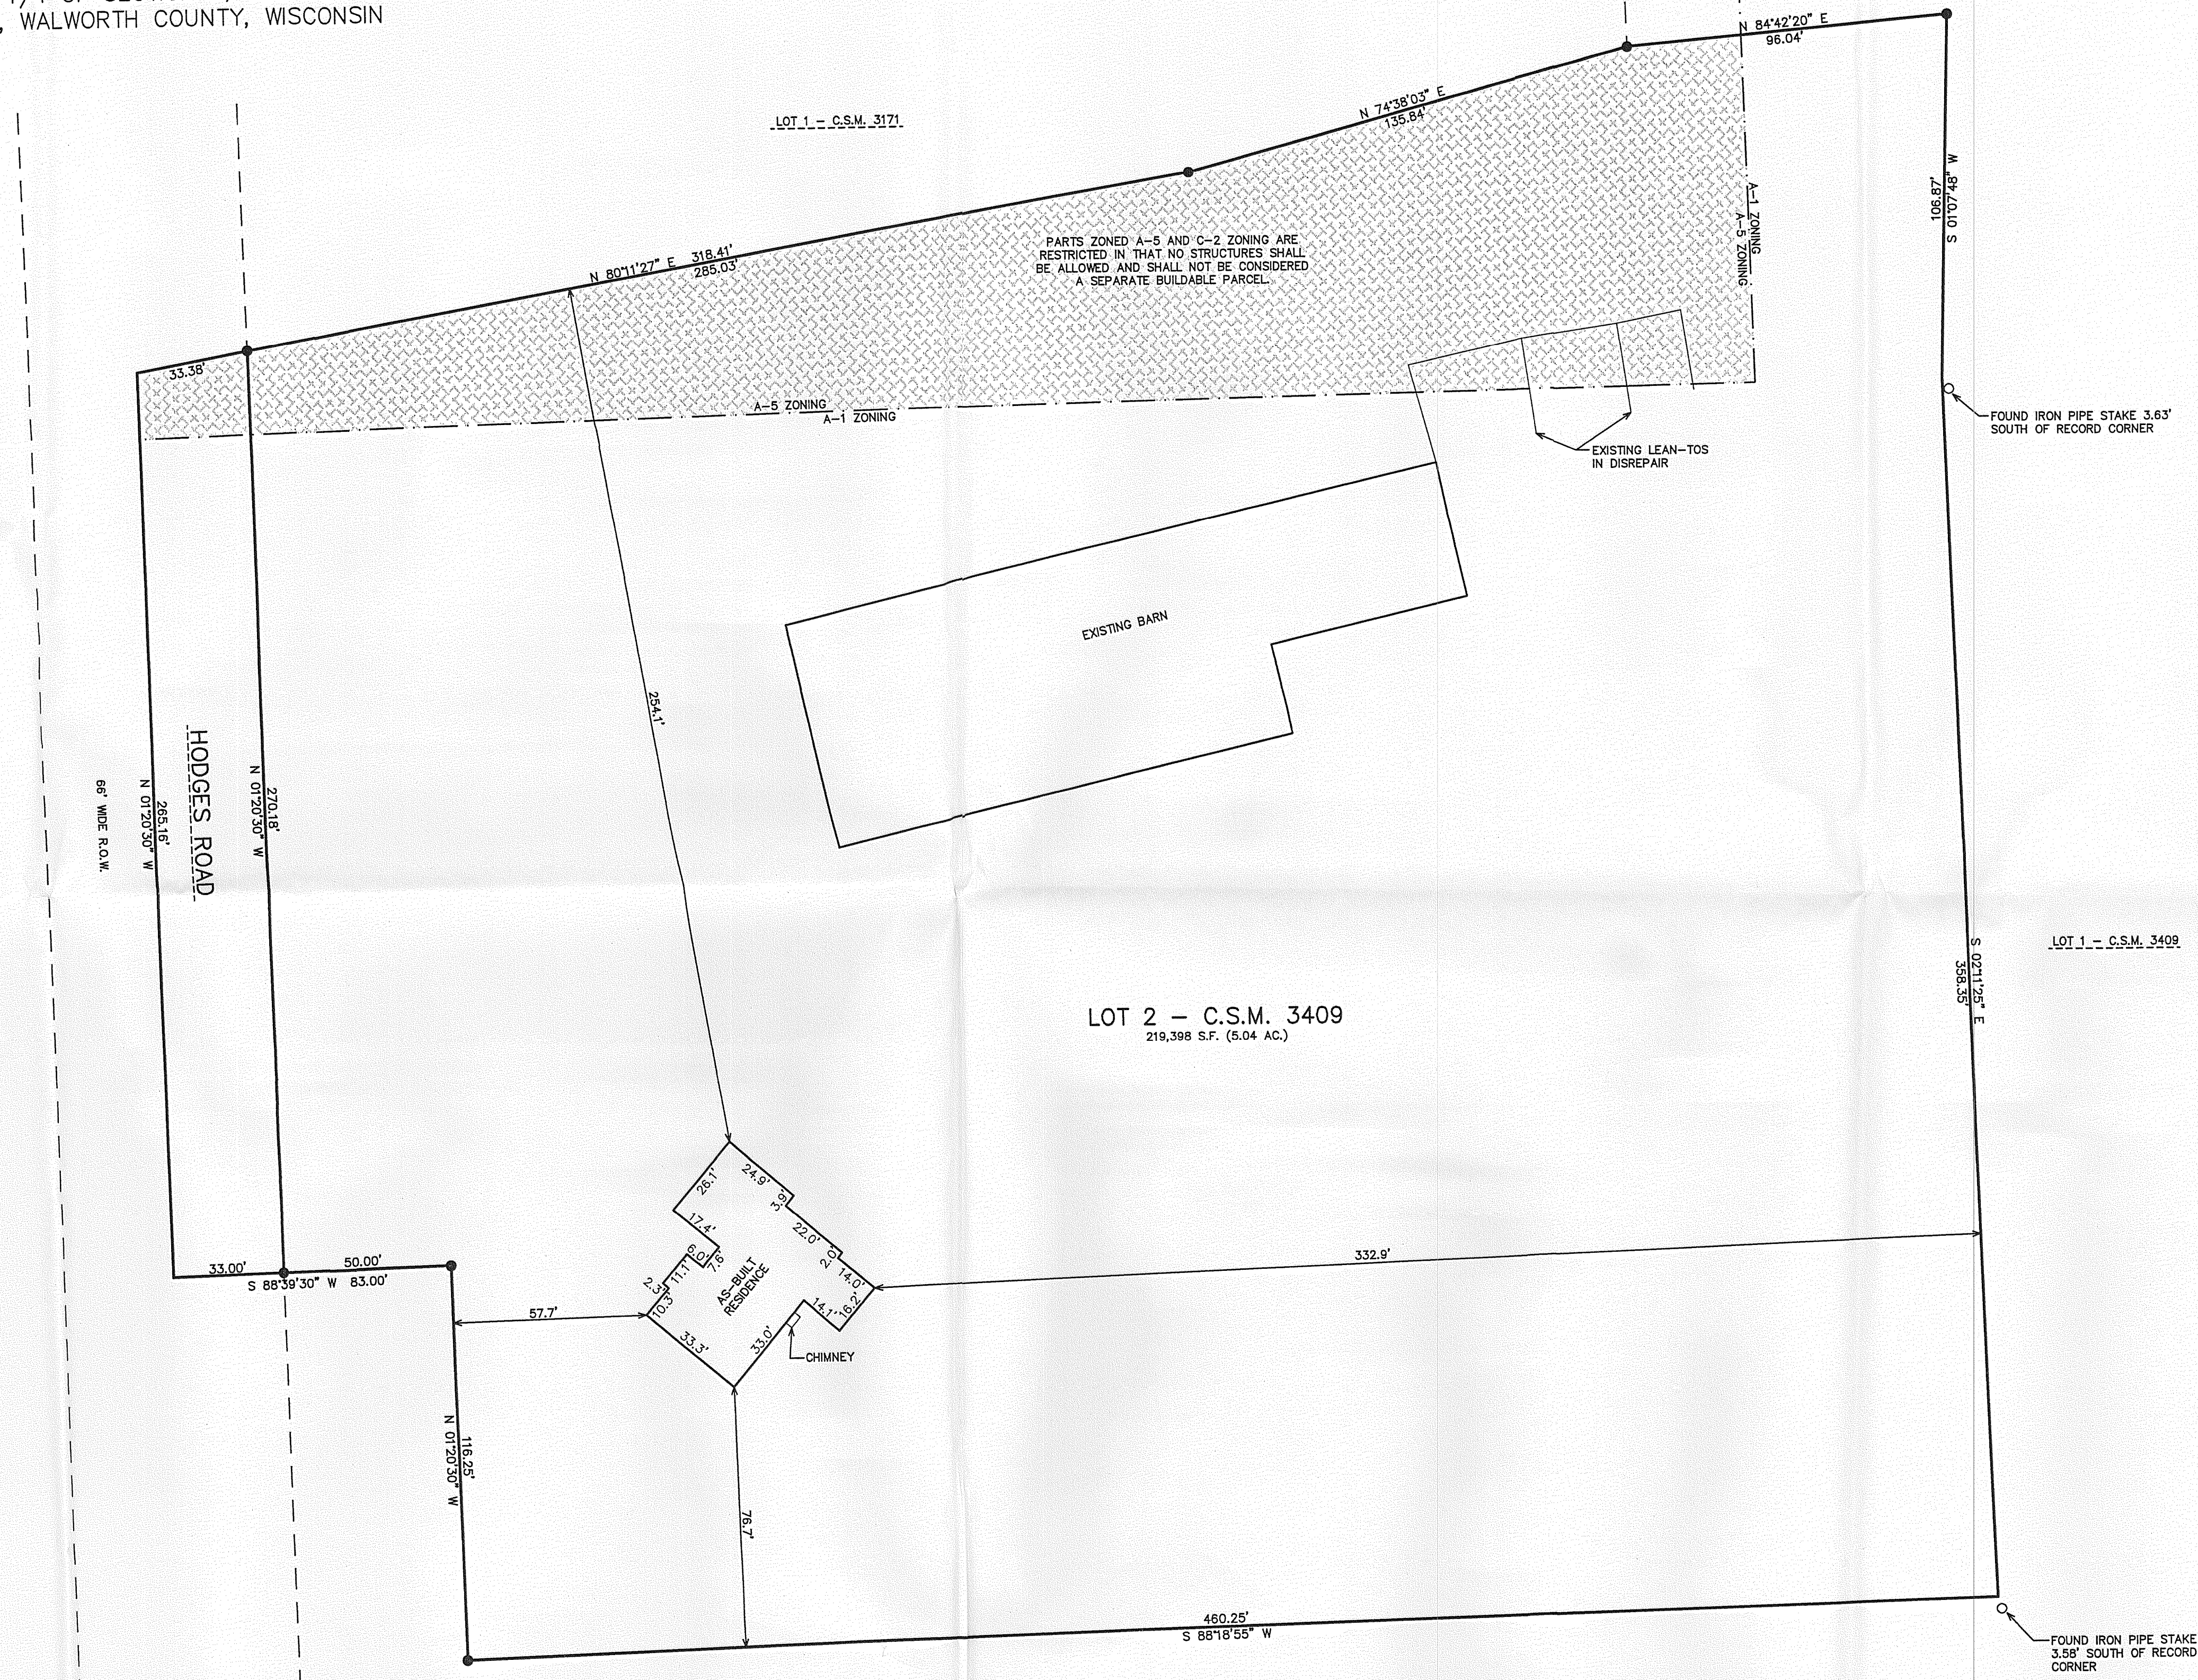

- LEGEND
- = FOUND IRON PIPE STAKE
 - = FOUND IRON REBAR STAKE
 - (XXX) = RECORDED AS

NOTE: COPIES OF THIS MAP TO WHICH THE FOLLOWING CERTIFICATE
WILL APPLY SHOW THE SURVEYOR'S ORIGINAL SEAL AND SIGNATURE
IN RED INK. COPIES BY ANY OTHER MEANS MAY HAVE ALTERATIONS
WHICH DO NOT REPRESENT THE SURVEYOR'S WORK PRODUCT.



I HEREBY CERTIFY THAT THE ABOVE DESCRIBED PROPERTY HAS BEEN
SURVEYED UNDER MY DIRECTION AND THAT THE ABOVE MAP IS A TRUE
REPRESENTATION THEREOF AND SHOWS THE SIZE AND LOCATION OF
THE PROPERTY AND ITS EXTERIOR BOUNDARIES. THIS SURVEY IS
MADE FOR THE USE OF THE PRESENT OWNERS OF THE PROPERTY, AND
ALSO THOSE WHO PURCHASE, MORTGAGE, OR GUARANTEE THE TITLE
THERE TO WITHIN ONE YEAR FROM THE DATE HEREOF.

DATED: SEPT. 12, 2001

REVISED 02-14-2008
TO SHOW SIZE & LOCATION OF
PROPOSED RESIDENCE

REVISED 10-04-2008
TO SHOW SIZE AND LOCATION OF
AS-BUILT RESIDENCE

PETER S. GORDON R.L.S. 2101

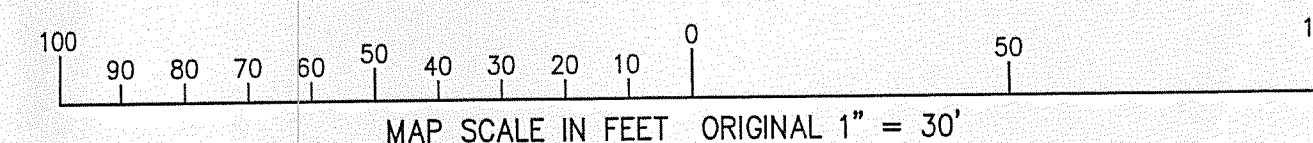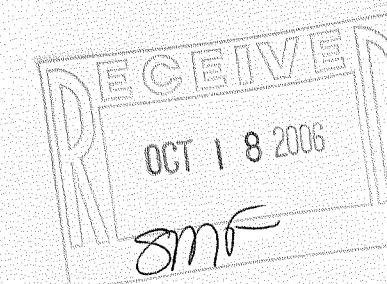

WORK ORDERED BY -
KEN MARKHAM
N6662 HODGES ROAD
ELKHORN, WI 53121

FARRIS, HANSEN & ASSOCIATES, INC.
ENGINEERING - ARCHITECTURE - SURVEYING
7 RIDGWAY COURT P.O. BOX 437
ELKHORN, WISCONSIN 53121
OFFICE: (262) 723-2098 FAX: (262) 723-5866

REVISIONS

PROJECT NO.
5358.06
DATE
02/14/2006
SHEET NO.
1 OF 1

KA3409-2

317-867