

**REGISTERED PROFESSIONAL LAND SURVEYOR
LAKE GENEVA, WISCONSIN**

1985.62

N 1° 23' 50" W 249.63'

33.02'

S 87° 55' 00" W 1333.81'

1300.79'

33.01'

417.43'

N 88° 49' 35" E 450.44'

(N 90° 00' W 444.00')

33.01'

N 1° 10' 25" W 983.83'

(N 0° 00' E 983.70')

40.48 ACRES

33.01'

(N 90° 00' E 444.00')

N 88° 49' 35" E 446.61'

413.60'

FOUND IRON PIPE 2.60' EAST

33.01'

N 1° 23' 50" W 412.48'

1299.28'

N 88° 23' 10" E 1332.29'

33.01'

N 1° 07' 10" W 999.04'

657.92'

N 1° 41' 35" W

312'

317'

FENCE

310'

PLAT OF SURVEY OF

40.48 ACRES

PLAT OF SURVEY OF

A parcel of land located in the Northeast $\frac{1}{4}$ and the Southeast $\frac{1}{4}$ of Section 7, T3N, R17E, Walworth County, Wisconsin described as follows:
Commencing at the North $\frac{1}{4}$ corner of said Section 7; thence S $1^{\circ}23'50''$ E 1983.62 feet to the place of beginning; thence N $87^{\circ}55'00''$ E 1333.37 feet; thence S $1^{\circ}41'35''$ E 657.92 feet; thence S $1^{\circ}07'10''$ E 999.04 feet; thence S $88^{\circ}23'10''$ W 1332.29 feet; thence N $1^{\circ}23'50''$ W 412.48 feet; thence N $88^{\circ}49'35''$ E 446.61 feet; thence N $1^{\circ}10'25''$ W 983.83 feet; thence S $88^{\circ}49'35''$ W 450.44 feet; thence N $1^{\circ}23'50''$ W 249.63 feet to the place of beginning. Containing 40.48 acres.

Note: The bearing of the West line of the East $\frac{1}{2}$ of Section 7 is assumed
N 1°23'50" W.

Owned by: David Fink
Rt. 4, Box 42
Elkhorn, WI.

Soil Types: Houghton muck, Matherton silt loam
Cascadia loam, Cascadia-Rodman complex,
Sebawa silt loam, Fox silt loam, Fox sandy loam,
Juncos silt loam, Boyer complex, Fox silt loam.


EUGENE BLOMQUIST DO HEREBY CERTIFY THAT I HAVE
SURVEYED THE PROPERTY HEREON DESCRIBED ACCORDING
TO THE OFFICIAL RECORDS, AND THAT THE PLAT HEREON
IS A CORRECT REPRESENTATION OF THE LOT LINES.

EUGENE A. BLOQUIST
WISCONSIN REGISTERED LAND SURVEYOR, S. 1279
DATE *Dec 27 1978*

SCALE: 1" = 200'

LEGEND

- φ — IRON PIPE FOUND
 O — IRON PIPE PLACED
 ● — CONCRETE MONUMENT
 x — SPIKE
 () — PLATTED AS

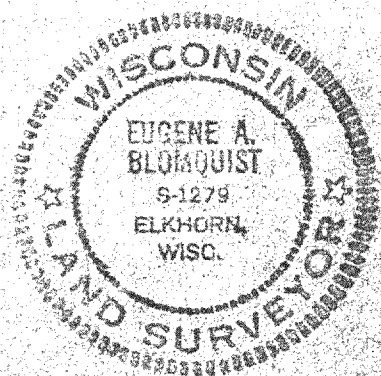


8-212

HAROLD H. KOLB

REGISTERED PROFESSIONAL LAND SURVEYOR
LAKE GENEVA, WISCONSIN

N 1/4 CORNER
SECTION 7-3-17

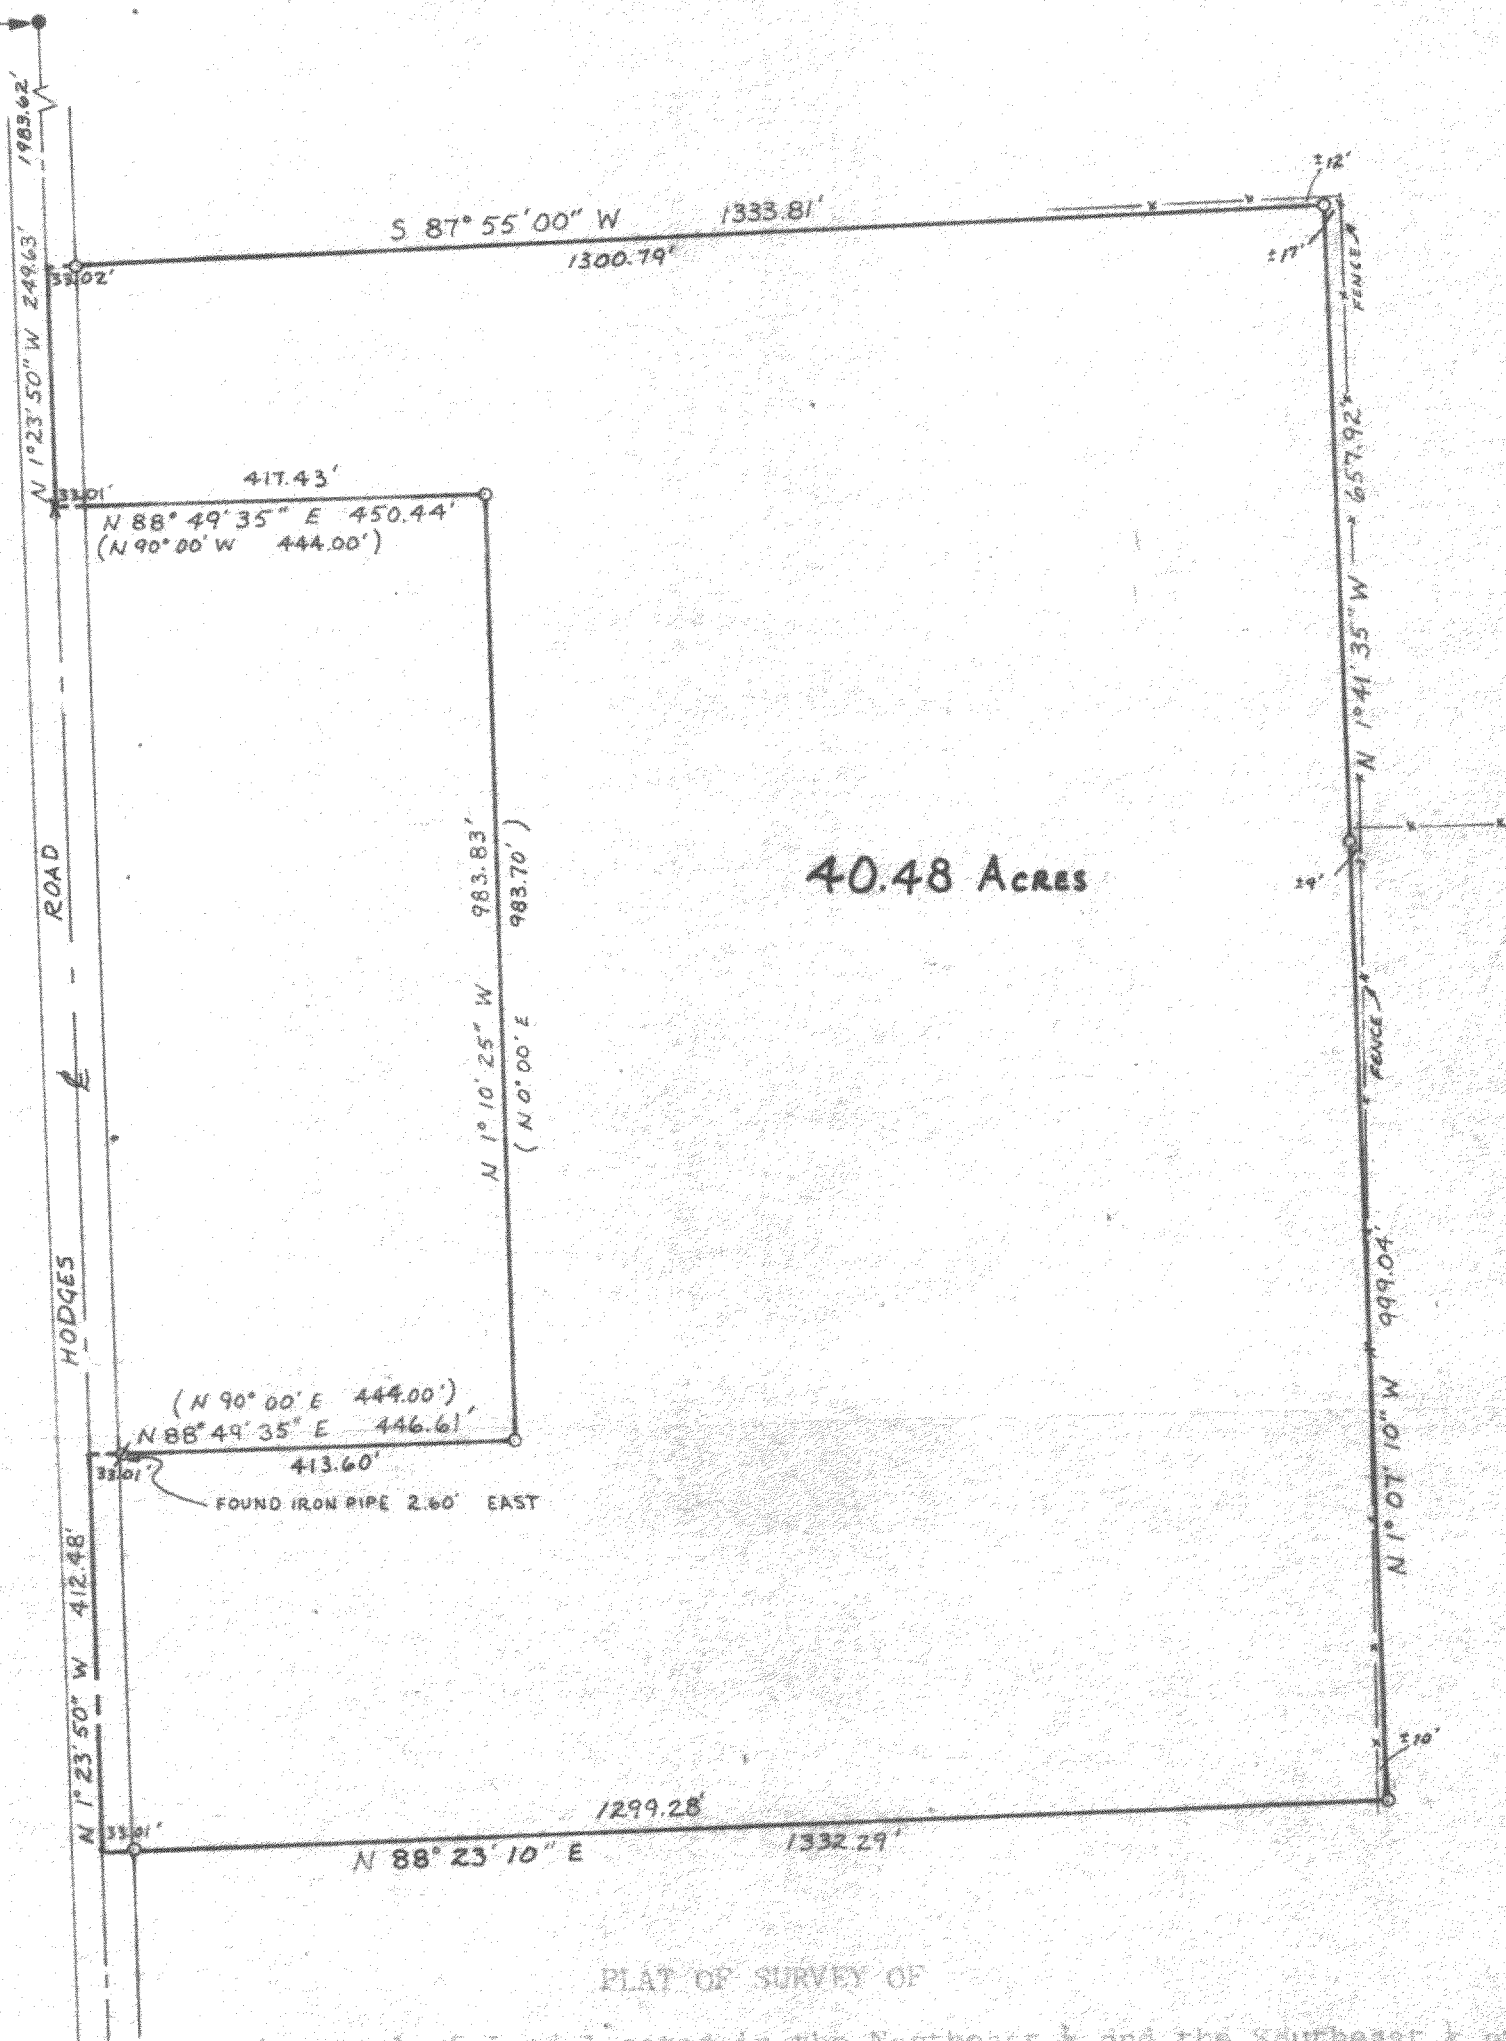

40.48 Acres



SCALE: 1" = 200'

LEGEND

- φ - IRON PIPE FOUND
- - IRON PIPE PLACED
- - CONCRETE MONUMENT
- x - SPIKE
- () - PLATTED AS


PLAT OF SURVEY OF

A parcel of land located in the Northeast 1/4 and the Southeast 1/4 of Section 7, T3N, R17E, Walworth County, Wisconsin described as follows: Commencing at the North 1/4 corner of said Section 7; thence S 1°23'50" E 1983.62 feet to the place of beginning; thence S 87°55'00" E 1333.81 feet; thence S 1°41'35" E 657.92 feet; thence S 1°07'10" E 999.04 feet; thence S 88°23'10" W 1332.29 feet; thence N 1°23'50" W 412.48 feet; thence N 88°49'35" E 446.61 feet; thence N 1°10'23" W 983.83 feet; thence S 88°49'35" W 430.44 feet; thence N 1°23'50" W 249.63 feet to the place of beginning. Containing 40.48 acres.

Note: The bearing of the West line of the East 1/2 of Section 7 is assumed N 1°23'50" W.

Owned by: David Fink
Rt. 4, Box 42
Elkhorn, WI.

Soil Types: Houghton muck, Matherton silt loam, Cassco loam, Ensco-Kodman complex, Sedawa silt loam, Fox silt loam, Fox sandy loam, Juneau silt loam, Boyer complex, Fox silt loam.

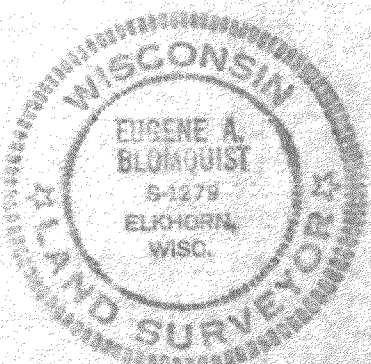

EUGENE A. BLOMQUIST DO HEREBY CERTIFY THAT I HAVE SURVEYED THE PROPERTY HEREON DESCRIBED ACCORDING TO THE OFFICIAL RECORDS, AND THAT THE PLAT HEREON IS A CORRECT REPRESENTATION OF THE LOT LINES.

Eugene A. Blomquist
EUGENE A. BLOMQUIST
WISCONSIN REGISTERED LAND SURVEYOR, S-1279
DATE Dec 27, 1978