



# Plat of Survey

**Lot 1 of Certified Survey Map No. 3979,**  
recorded in Vol. 24 of Certified Survey Maps of Walworth County  
on Page 253 and located in the Northwest 1/4 and the Northeast  
1/4 of the Southwest 1/4 of Section 22, Town 3 North, Range 17  
East, Town of LaFayette, Walworth County, Wisconsin.

Surveyed for: **Joe & Kelly Walbrandt**  
301-1/2 West Walworth Street  
Elkhorn, Wisconsin. 53121

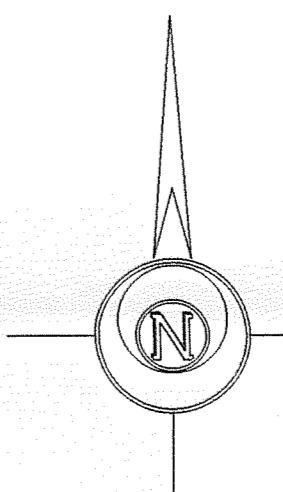

Plane Coordinate System, South Zone.

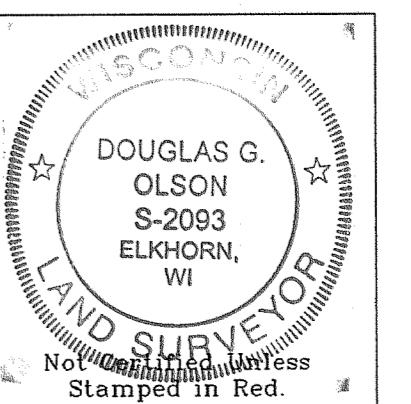

Notes: 1) This survey plat is not certified unless signed and sealed in red ink.

2) This survey is subject to Wisconsin lien laws.  
This Plat of Survey is the notice of intent  
to file lien. Lien waiver required.

Copyright © 2006 by Jensen & Olson Land Surveying, LLC.

All rights reserved. No part of this survey plat may be reproduced or transmitted in any form by any means - graphic, electronic, or mechanical, including photocopying, tracing, or information storage and retrieval systems - without permission in writing from Douglas G. Olson, Jensen & Olson Land Surveying, LLC.

I, Douglas G. Olson, Wisconsin Registered Land Surveyor, do hereby certify that this survey was performed by me or under my direction in full compliance with the owner's/agent's instructions and Chapter A-E 7 of the Wisconsin Administrative Code "Minimum Standards for Property Surveys"; and that this map is an accurate representation thereof to the best of my knowledge and belief.

Douglas G. Olson  
Wisconsin Registered Land Surveyor - 2093

Survey Date: April 20, 2006.  
Revisions: No. 1 - Proposed Hse  
No. 2 - Foundation

Scale in Feet  
 $1'' = 40'$

**Olson & Olson Land Surveying, LLC**

---

45 South Wisconsin Street      P.O. Box 322  
Elkhorn, Wisconsin      53121  
Telephone (262) 723-3434

Sheet 1 of 1 Sheets	Job Reference Number <b>20060013</b>
	<u>Legend</u>  <ul style="list-style-type: none"> <li>■ Found County Site</li> <li>● Set Iron Rod, 3/4"</li> <li>( ) Recorded Information</li> <li>☆ Soil Borings (locations from a soil evaluation)</li> <li>△ Aerial Surface</li> </ul>

2006.043

KA 3979-1