

PLAT OF SURVEY



LOCATION: N5937 Cobb Road, LaFayette, Wisconsin

LEGAL DESCRIPTION:

Lot 43 in **RIDGEVIEW ESTATES**, being a subdivision of a part of the Northwest 1/4 and Southwest 1/4 of the Northeast 1/4 of Section 19, Town 3 North, Range 17 East, in the Town of LaFayette, Walworth County, Wisconsin.

November 20, 2006

Survey No. 100121

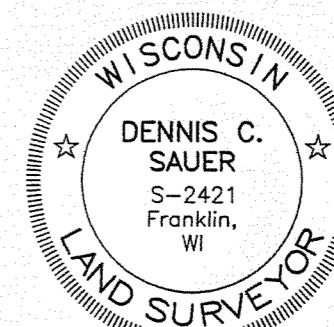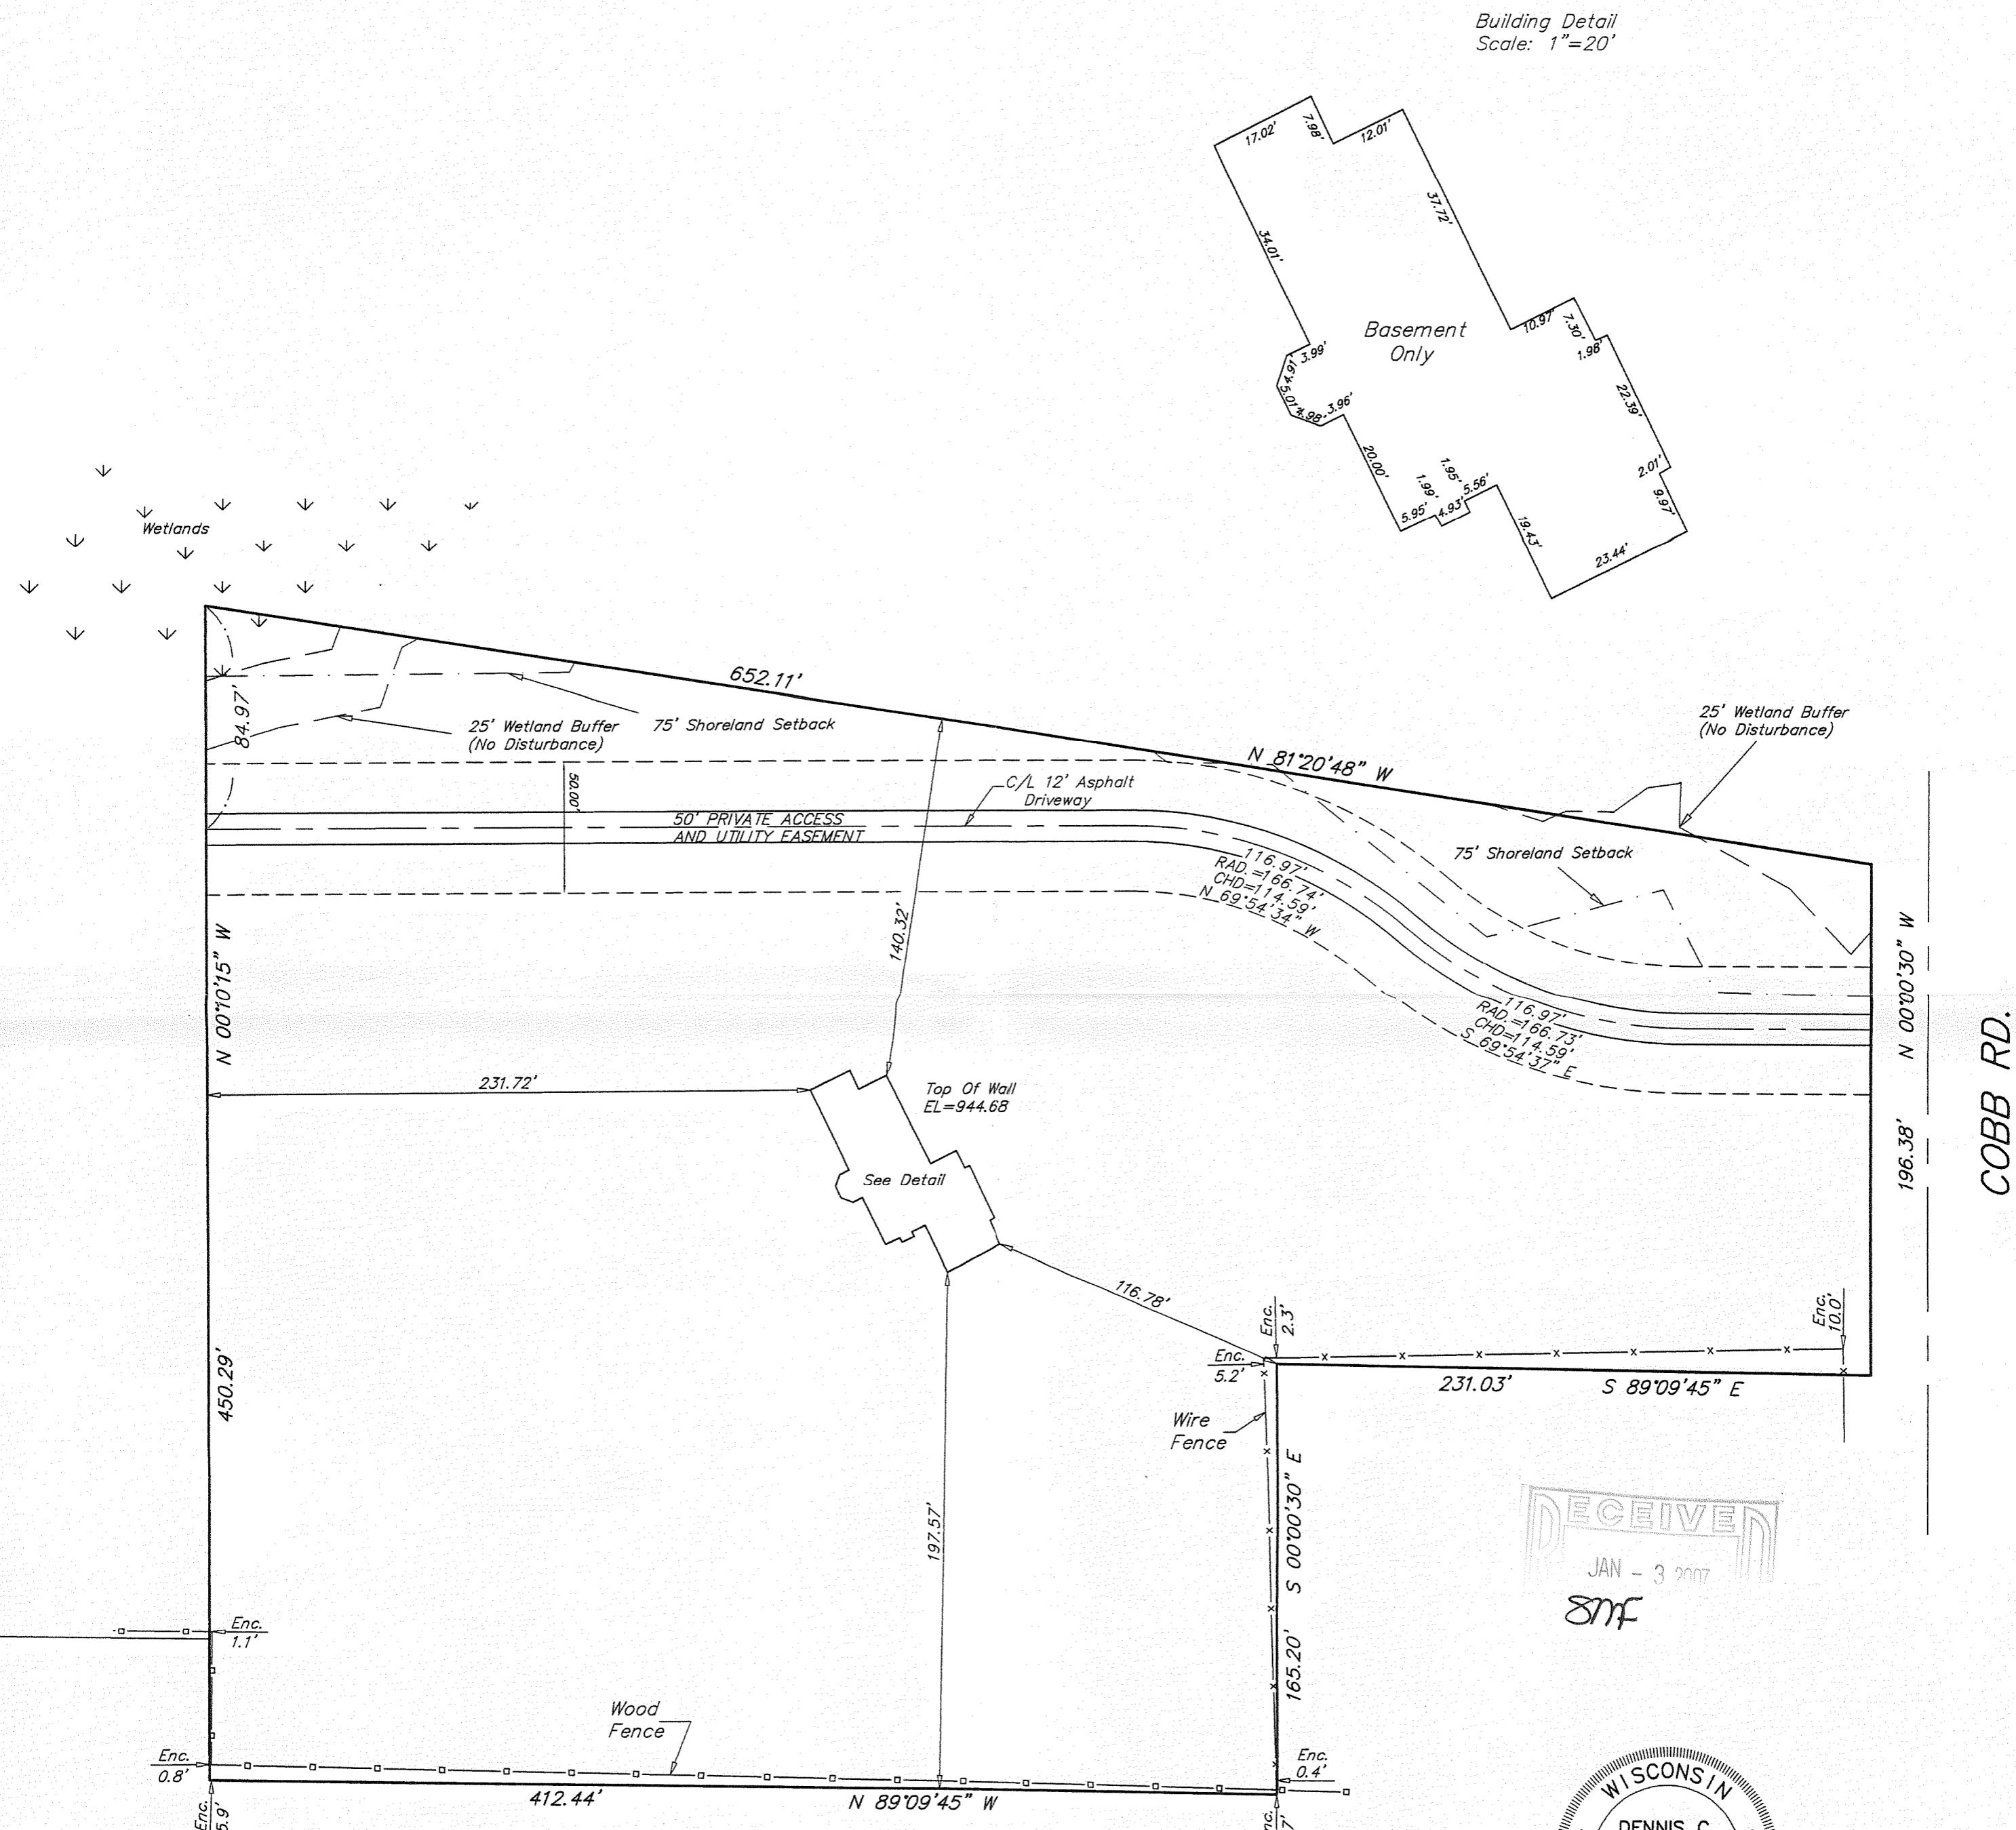

I HEREBY CERTIFY THAT I HAVE SURVEYED THE ABOVE DESCRIBED PROPERTY AND THAT THE ABOVE MAP IS A TRUE REPRESENTATION THEREOF AND SHOWS THE SIZE AND LOCATION OF THE PROPERTY, ITS EXTERIOR BOUNDARIES, THE LOCATION OF ALL VISIBLE STRUCTURES AND DIMENSIONS OF ALL PRINCIPAL BUILDINGS THEREON, BOUNDARY FENCES, APPARENT EASEMENTS AND ROADWAYS AND VISIBLE ENCROACHMENT, IF ANY.

**THIS SURVEY IS MADE FOR THE EXCLUSIVE USE OF THE PRESENT OWNERS OF THE PROPERTY,
AND ALSO THOSE WHO PURCHASE, MORTGAGE, OR GUARANTEE THE TITLE THERETO WITHIN
ONE (1) YEAR FROM THE DATE HEREOF.**

七言律詩

Dennis C. Sauer
Registered Land Surveyor S-2421

Survey No. 99933

METROPOLITAN SURVEY SERVICE, INC.

REGISTERED LAND SURVEYORS AND CIVIL ENGINEERS

REGISTERED LAND SURVEYORS AND CIVIL ENGINEERS
5200 W. LOOMIS ROAD, GREENDALE WI 53129

5200 W. LUOMIS RD.

PH. (414) 529-5380 FAX (414) 529-978

email address survey@bizwi.rr.com

GRAPHIC SCALE

50 0 25 50 100 200

(IN FEET)

A vertical decorative element consisting of a thin vertical line with a stylized scroll or knot motif at the top, resembling a traditional East Asian ornament.

KRID-43

317-875