

PLAT OF SURVEY -OF-

UNIT 25, ROLLING GREEN COUNTRY ESTATES, LOCATED IN THE SOUTHEAST 1/4
AND THE SOUTHWEST 1/4 OF SECTION 18, TOWNSHIP 3 NORTH, RANGE 17 EAST,
TOWN OF LAFAYETTE, WALWORTH COUNTY, WISCONSIN.

PREPARED FOR: MIKE ESSMAN
SITE PLAN LOCATION: PEBBLE DRIVE


I HEREBY CERTIFY THAT THE EXISTING FOUNDATION AS SHOWN BY THIS
PLAT OF SURVEY IS LOCATED AS SHOWN THUS (). DATED THIS 23RD
DAY OF MAY, 2008.

Robert J. Wetzel
ROBERT J. WETZEL S-1778

SCALE:
1" = 30'



LEGEND

○ FOUND IRON PIPE

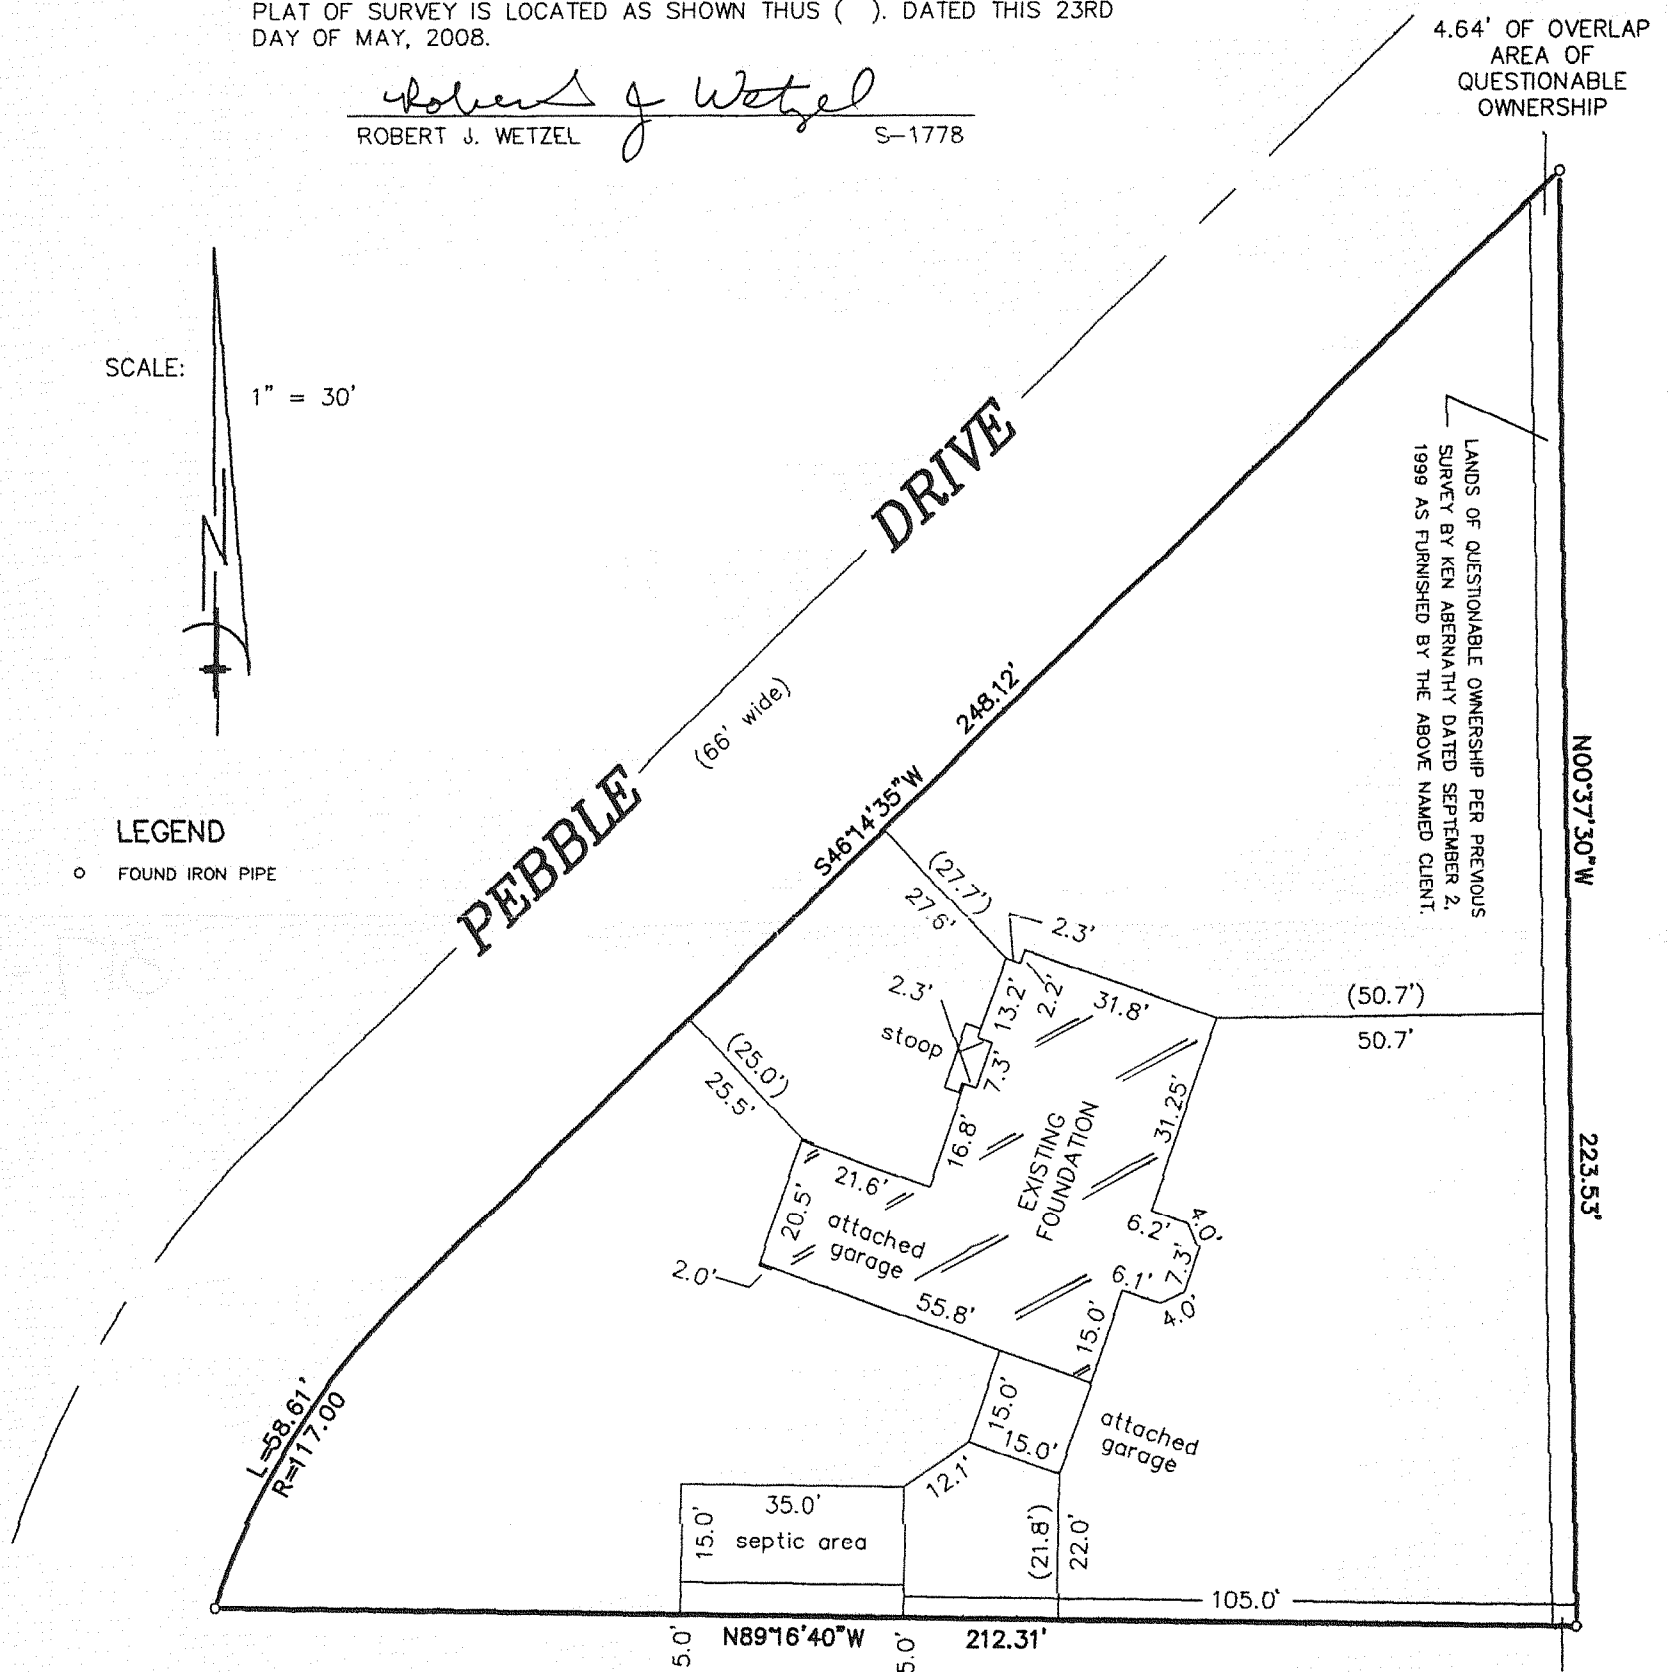


"I hereby certify that I have surveyed the above described property and that the above map is a correct representation thereof and shows the size and location of the property, its exterior boundaries, the location of all visible structures and dimensions of all principal buildings thereon, boundary fences, apparent easements, roadways and encroachments, if any."

"This survey is made for the use of the present owners of the property, and those who purchase, mortgage, or guarantee the title thereto within one year from date hereof."

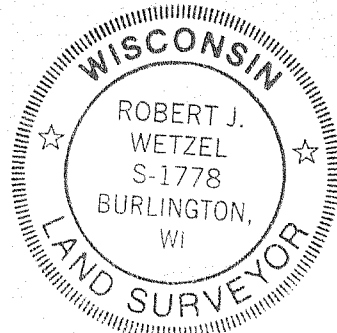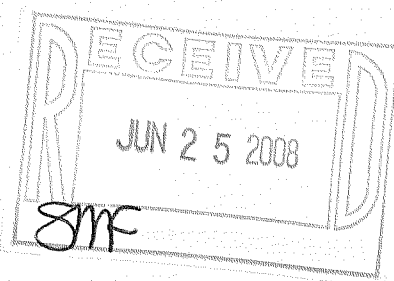

THIS IS NOT AN ORIGINAL PRINT
UNLESS THIS SEAL IS RED.

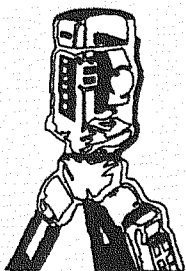

B.W. SURVEYING, INC.

LAND SURVEYS
MAPPING AND PLANNING
412 N. PINE STREET
BURLINGTON, WI 53105
(262)-767-0225

Robert J. Wetzel
ROBERT J. WETZEL S-1778

REVISED: MARCH 18, 2008
REVISED: OCTOBER 23, 2007
REVISED: OCTOBER 5, 2007

SEPTEMBER 18, 2007
DATE

7699
JOB NUMBER

KRG -25

317-897