


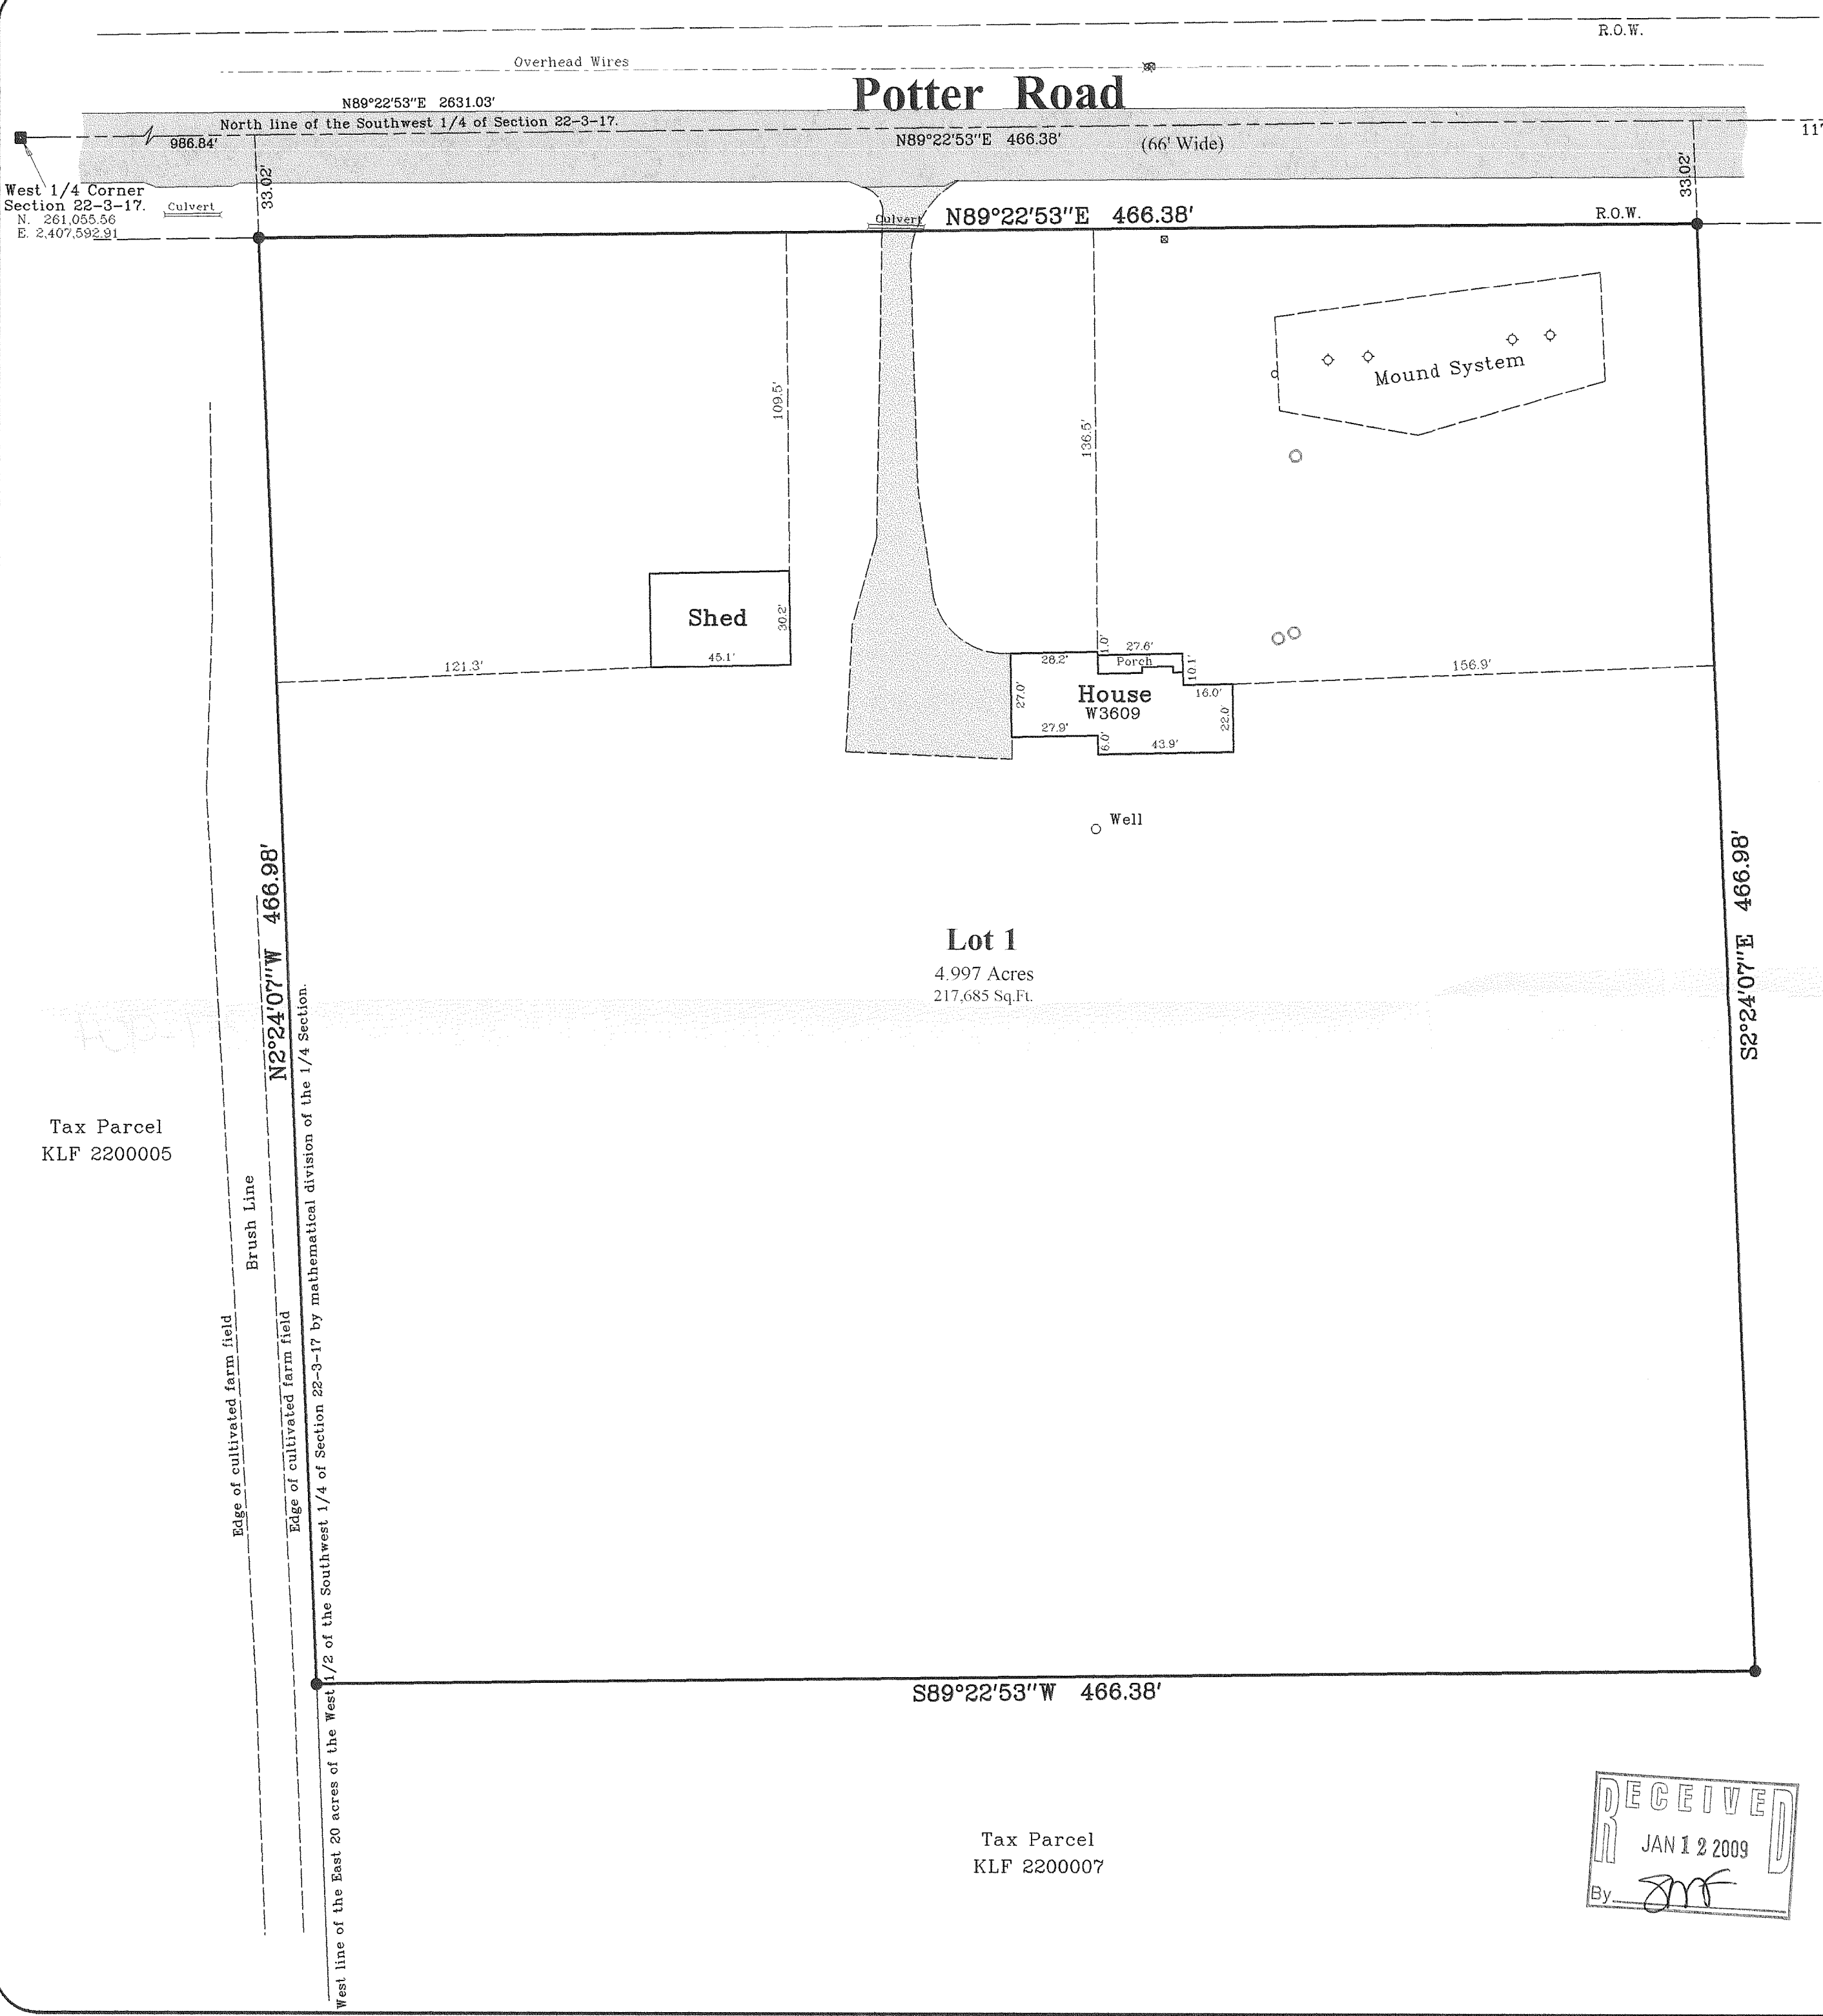


Plat of Survey

Lot 1 of Certified Survey Map No. 3979,


recorded in Vol. 24 of Certified Survey Maps of Walworth County on Page 253 and located in the Northwest 1/4 and the Northeast 1/4 of the Southwest 1/4 of Section 22, Town 3 North, Range 17 East, Town of LaFayette, Walworth County, Wisconsin.

Surveyed for: **Joe & Kelly Walbrandt**

W3609 Potter Road
Elkhorn, Wisconsin. 53121

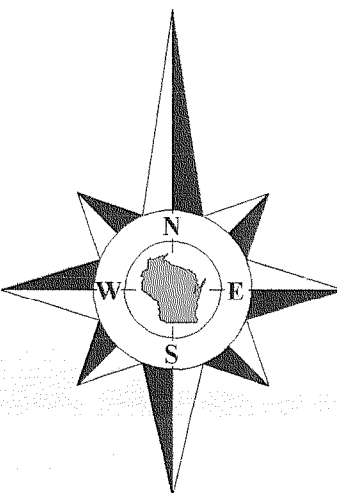

Bearings reference to the Wisconsin State Plane Coordinate System, South Zone.

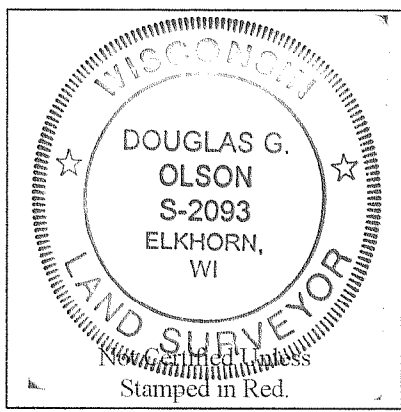

- Notes:**
- 1) This survey plat is not certified unless signed and sealed in red ink.
 - 2) This survey is subject to Wisconsin lien laws. This Plat of Survey is the notice of intent to file lien. Lien waiver required.

Copyright 2008 by Jensen & Olson Land Surveying, LLC.

All rights reserved. No part of this survey plat may be reproduced or transmitted in any form by any means - graphic, electronic, or mechanical, including photocopying, tracing, or information storage and retrieval systems - without permission in writing from Douglas G. Olson, Jensen & Olson Land Surveying, LLC.

I, Douglas G. Olson, Wisconsin Registered Land Surveyor, do hereby certify that this survey was performed by me, or under my direction in full compliance with the owner's/agent's instructions and Chapter A-E 7 of the Wisconsin Administrative Code "Minimum Standards for Property Surveys"; and that this map is an accurate representation thereof to the best of my knowledge and belief.

Douglas G. Olson
Wisconsin Registered Land Surveyor - 2093

Survey Date: April 20, 2006.
Revisions: No. 1 - Proposed Hse.
No. 2 - Foundation
No. 3 - Shed location

Scale in Feet
1" = 40'
0' 20' 40' 80'

Jensen & Olson Land Surveying, LLC
45 South Wisconsin Street * P.O. Box 322 * Elkhorn, Wisconsin. 53121
Telephone: (262) 723-3434 * Facsimile: (262) 723-8044
Email: jensen.olson@elknet.net

Legend
■ Found County Section Corner
● Set Iron Rod, 3/4" dia.
○ Recorded Information
○ Concrete Cover
○ Utility Pole
x Gravel Surface
x Gravel Surface

Sheet 1 of 1 Sheets
Job Reference Number
2006.043

2006.043

KA3979-1

317-904