

TOPOGRAPHICAL MAPPING & PERMIT PLAT

PART OF LOT 1 OF CERTIFIED SURVEY MAP NO. 4304

LOCATED IN PART OF THE NW 1/4 AND SW 1/4 OF THE SW 1/4 OF SECTION 16, TOWN 3 NORTH, RANGE 17 EAST, WALWORTH COUNTY, WISCONSIN



LUEPTOW RESIDENCE

- WORK ORDERED BY -
FRANK & STEPHANIE LUEPTOW
4001 COUNTRY ROAD ES
ELKHORN, WISCONSIN 53121

FARRIS, HANSEN & ASSOCIATES, INC.
ENGINEERING - ARCHITECTURE - SURVEYING
7 ELKHORN COURT P.O. BOX 437
ELKHORN, WISCONSIN 53121
OFFICE: (262) 723-2098 FAX: (262) 723-5886

REVISIONS
6/2/2010-AB
TO SHOW SIZE & LOCATION
OF PROPOSED RESIDENCE

PROJECT NO.
8031.01
DATE
6/10/2010
SHEET NO.
1 OF 1

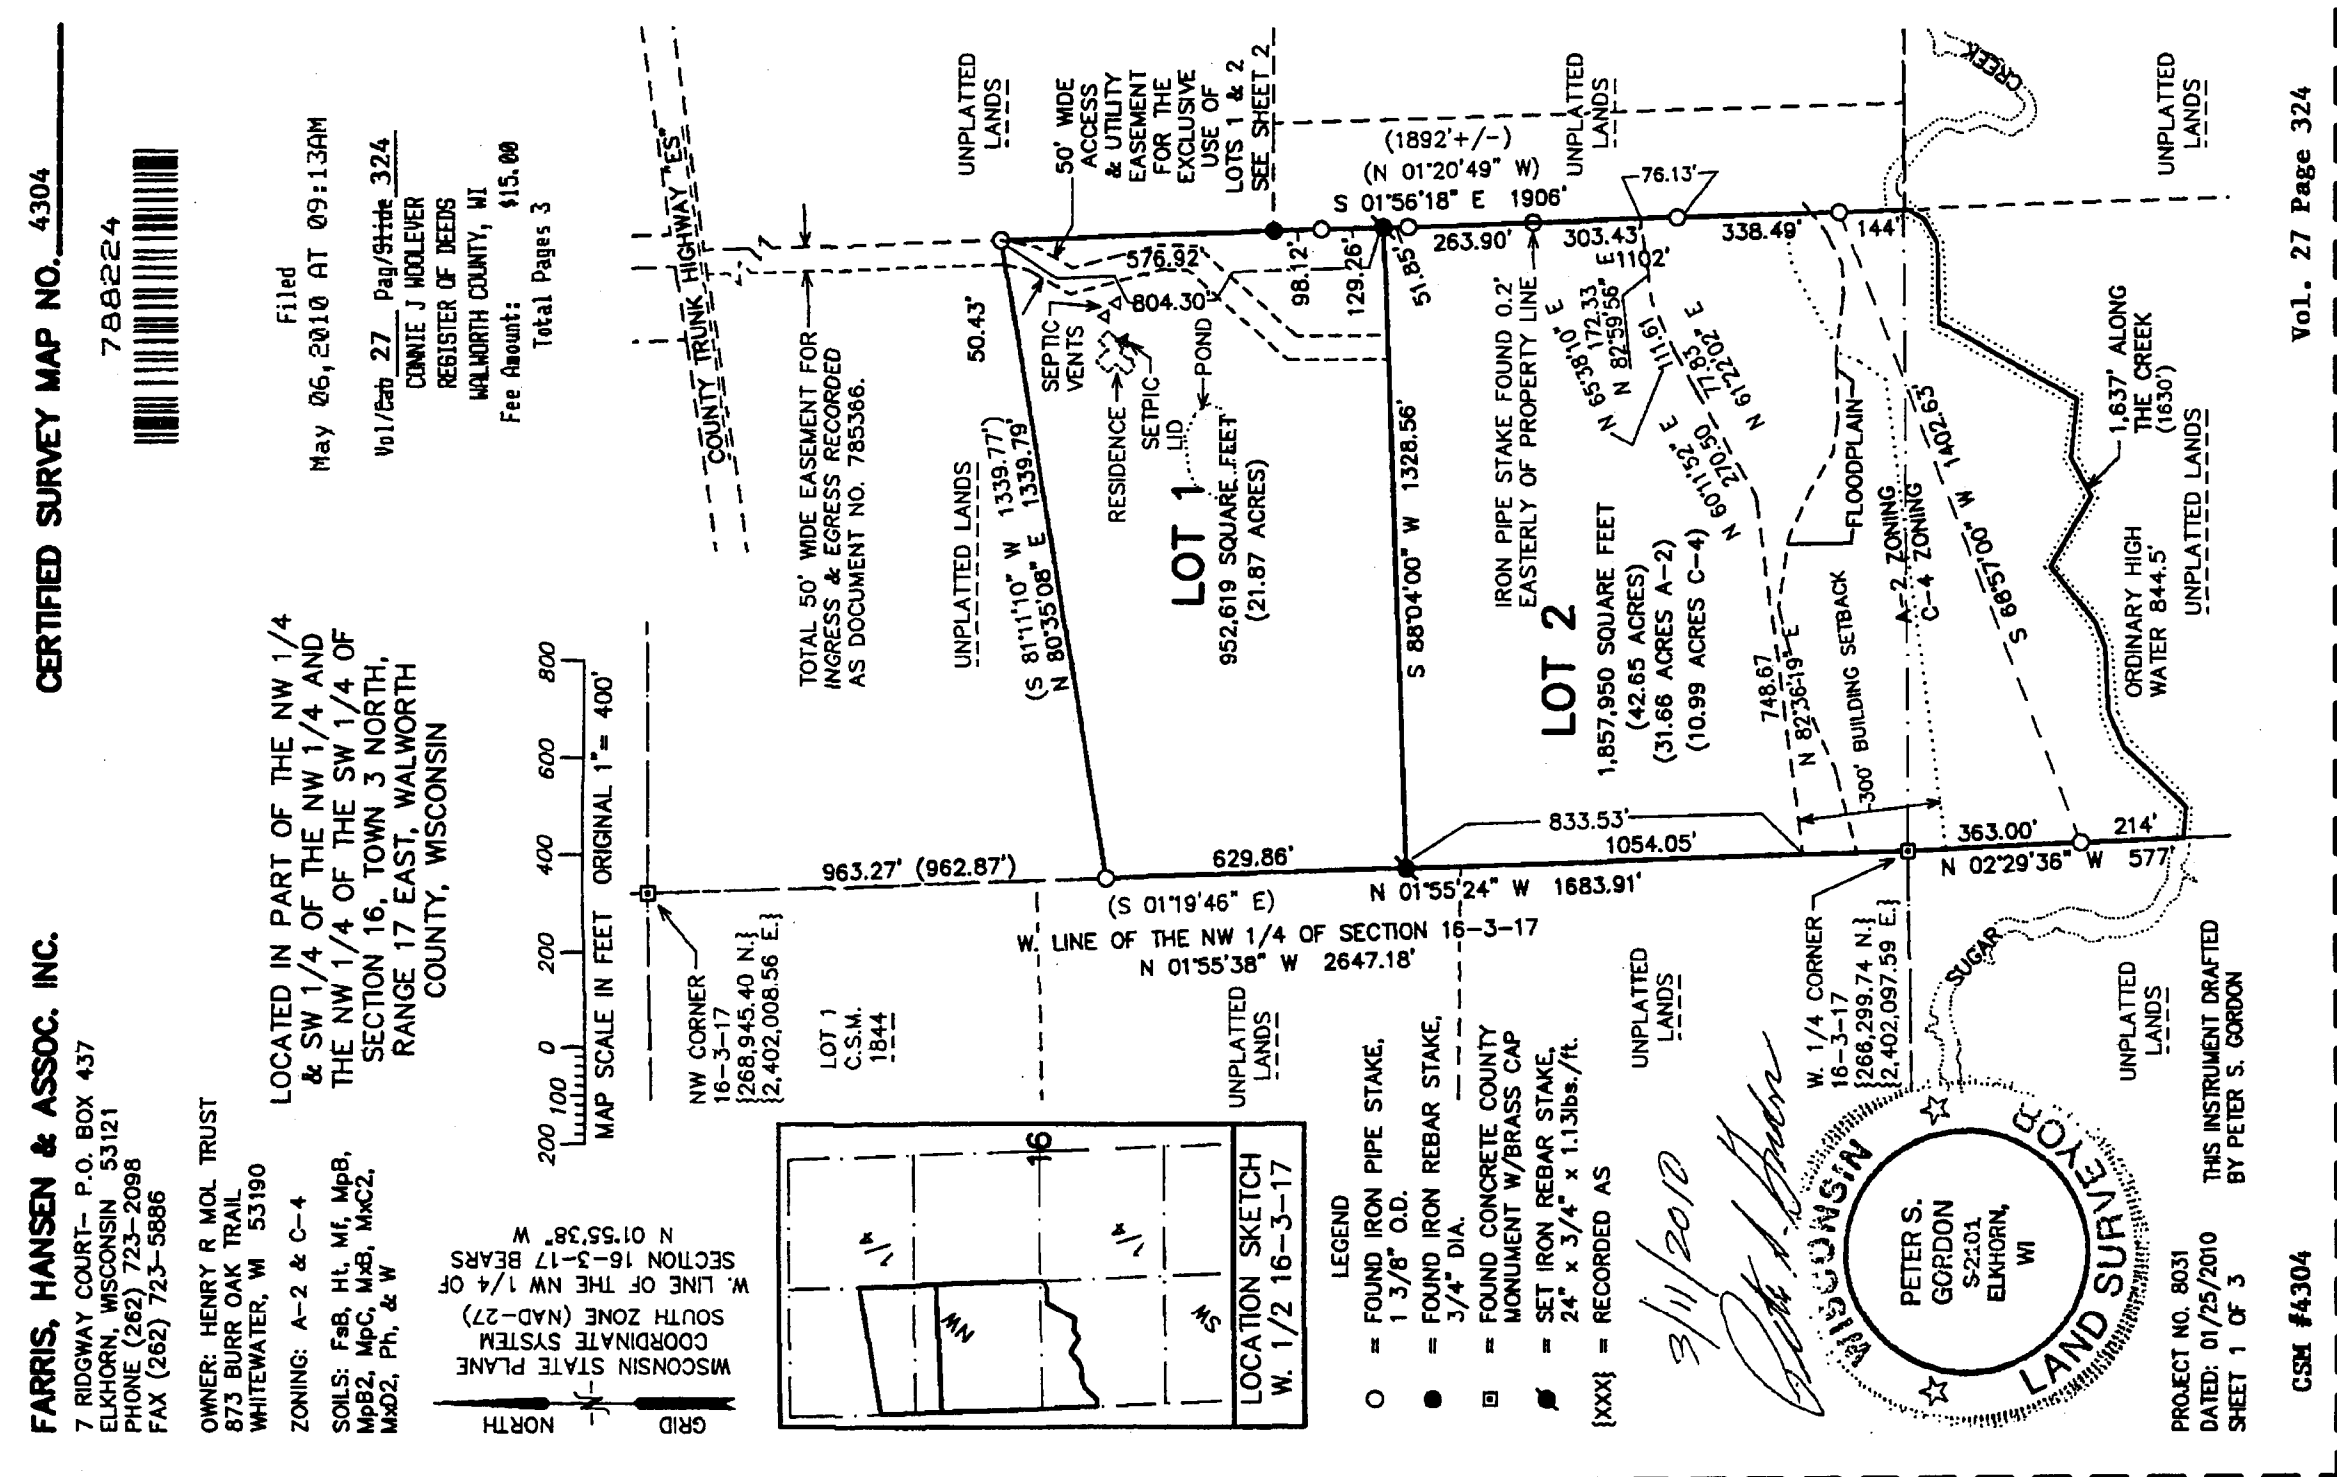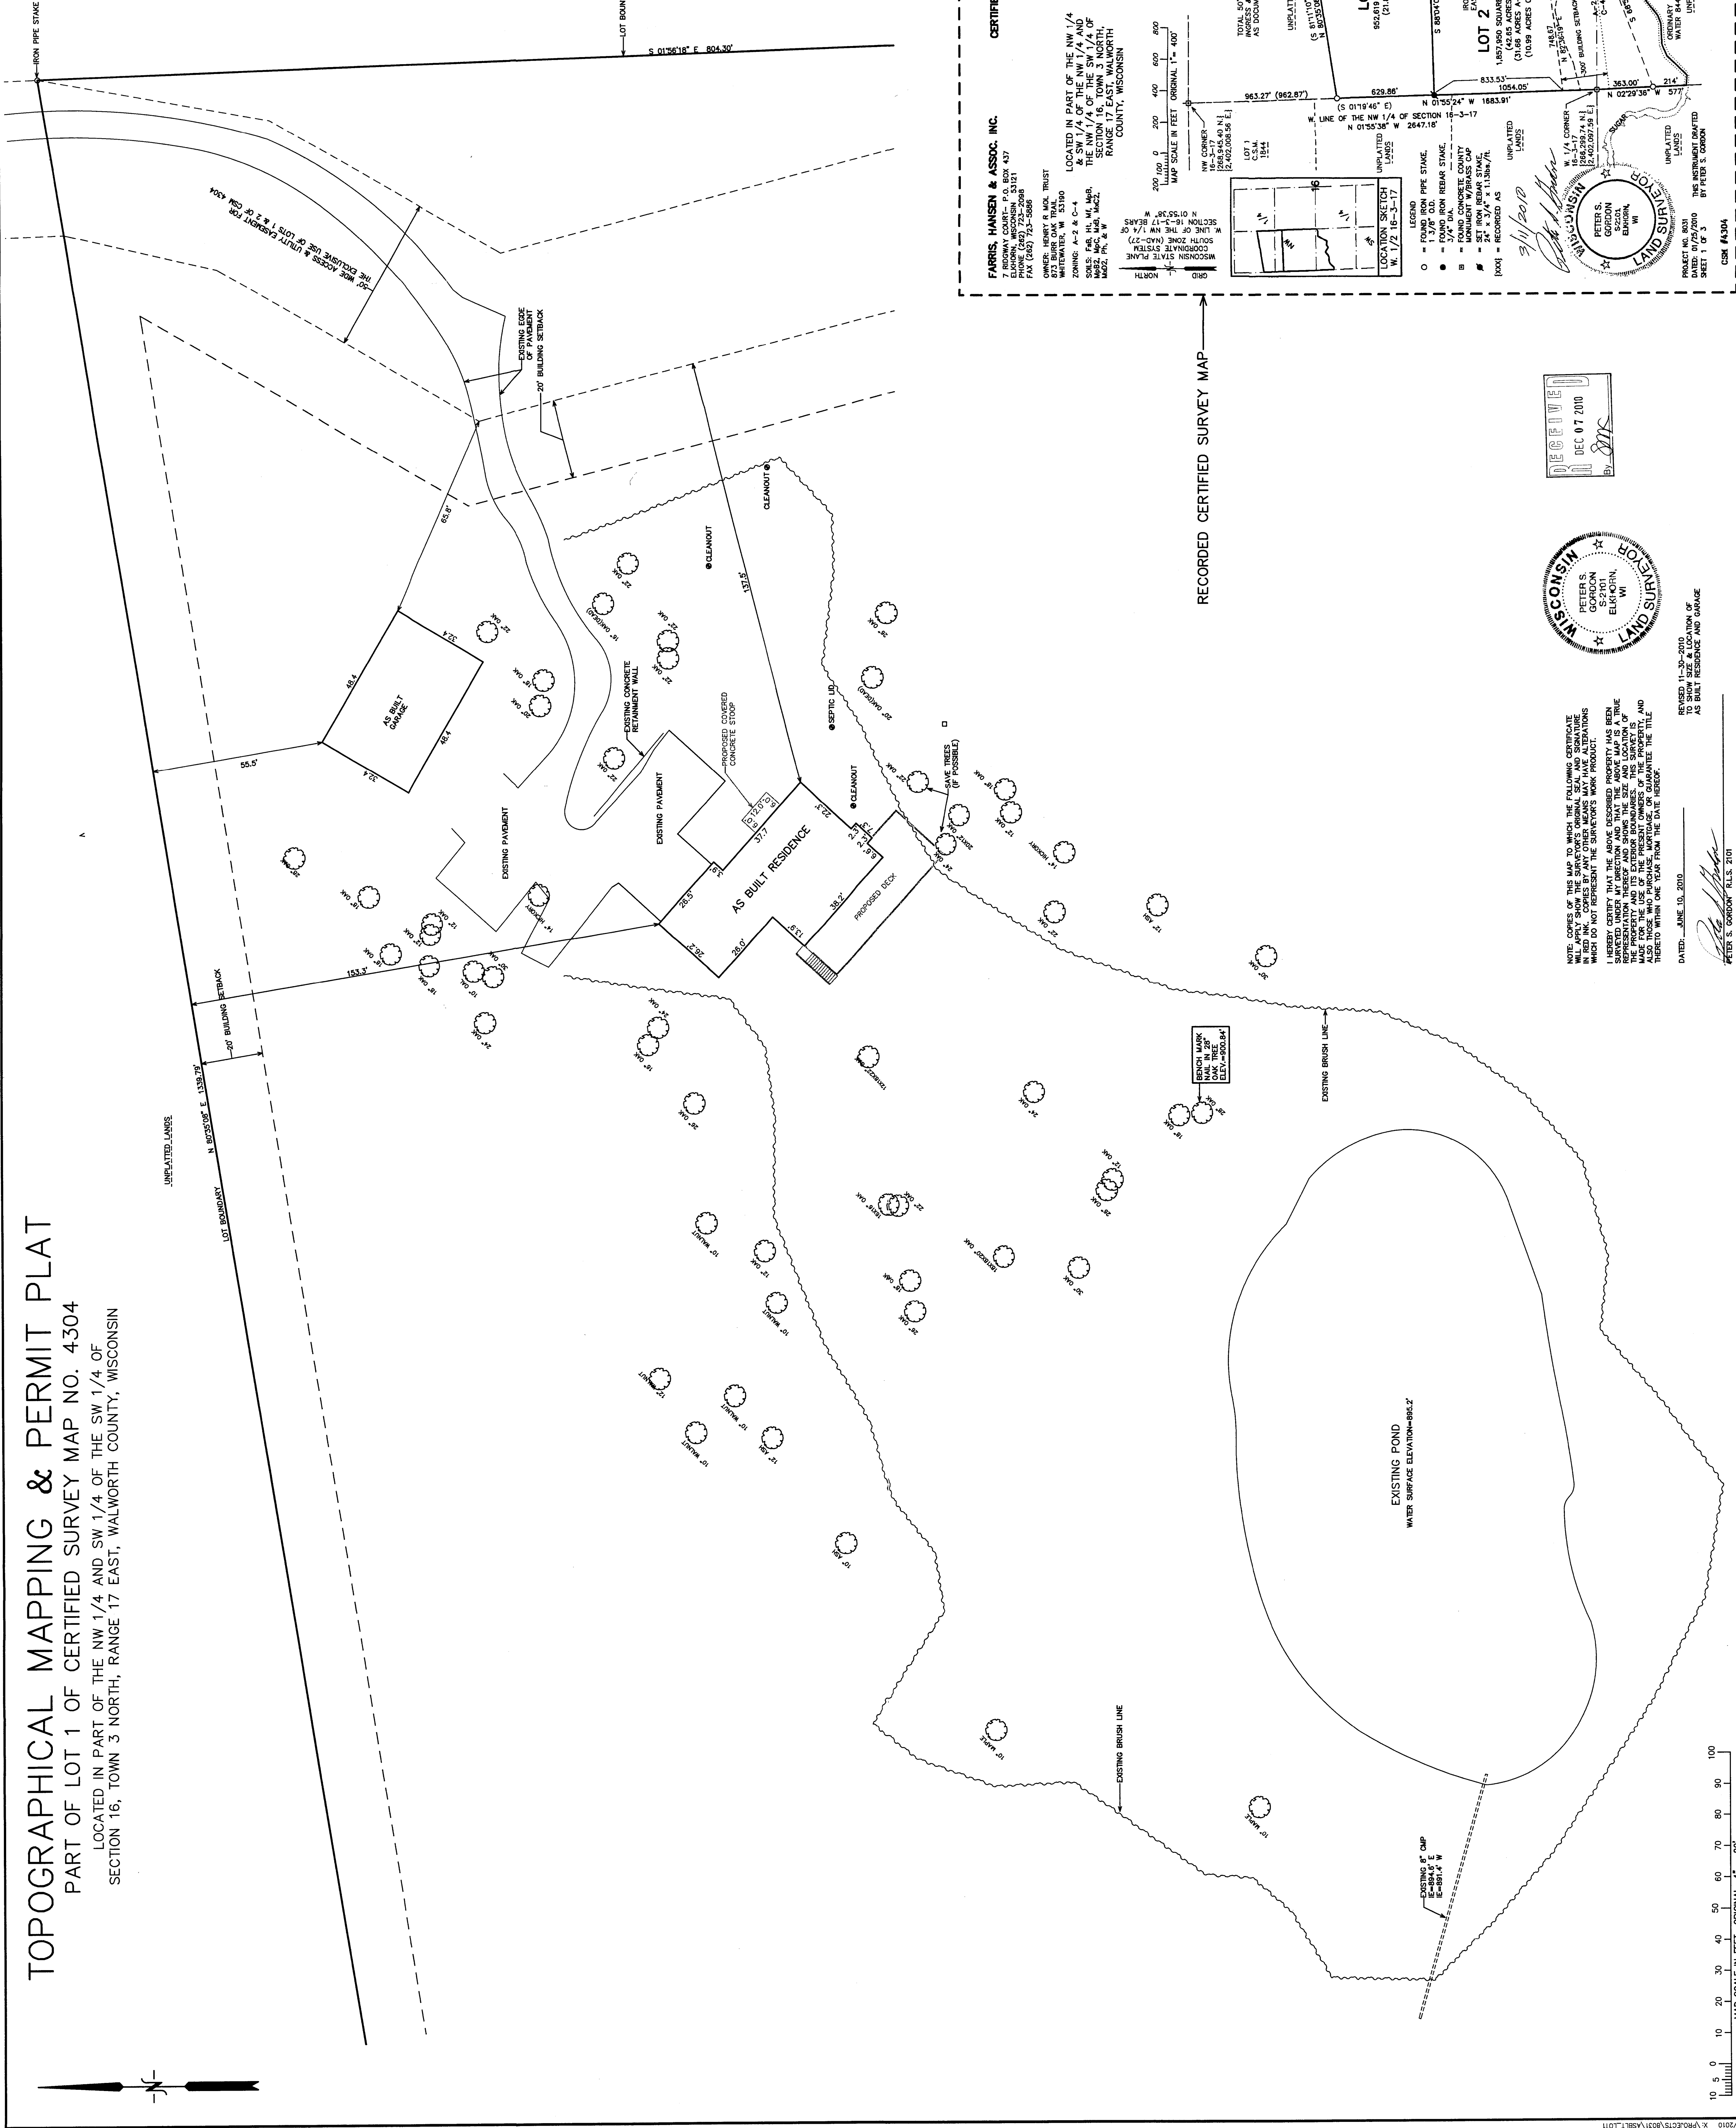

RECEIVED
DEC 07 2010
BY: [Signature]

WISCONSIN
PETER S. GORDON
LAND SURVEYOR
ELKHORN, WI

NOTE: COPIES OF THIS MAP TO WHICH THE FOLLOWING CERTIFICATE WILL APPLY SHOW THE SURVEYOR'S ORIGINAL SURVEY AND SURVEYING WHICH DO NOT REPRESENT THE SURVEYOR'S WORK PRODUCT.
I HEREBY CERTIFY THAT THE ABOVE DESCRIBED PROPERTY HAS BEEN SURVEYED AND THE SURVEYOR HAS BEEN LICENSED AND IN GOOD STANDING WITH THE WISCONSIN DEPARTMENT OF REVENUE AND LAND SURVEYING. THE SURVEYOR HAS ALSO THOSE WHO PURCHASE, MORTGAGE, OR GUARANTEE THE TITLE THEREIN WITHIN ONE YEAR FROM THE DATE HEREOF.
DATED: JUNE 10, 2010
PETER S. GORDON
REVISION 11-30-2010
AS BUILT RESIDENCE AND GARAGE

317-920

KA4304-1