



PLAT OF SURVEY
OF LOT III OF EVERGREEN ESTATES SUBDIVISION
LOCATED IN THE S.W. 1/4 OF SECTION 18, T3N, R17E
TOWN OF LA FAYETTE, WALWORTH CO. WISCONSIN

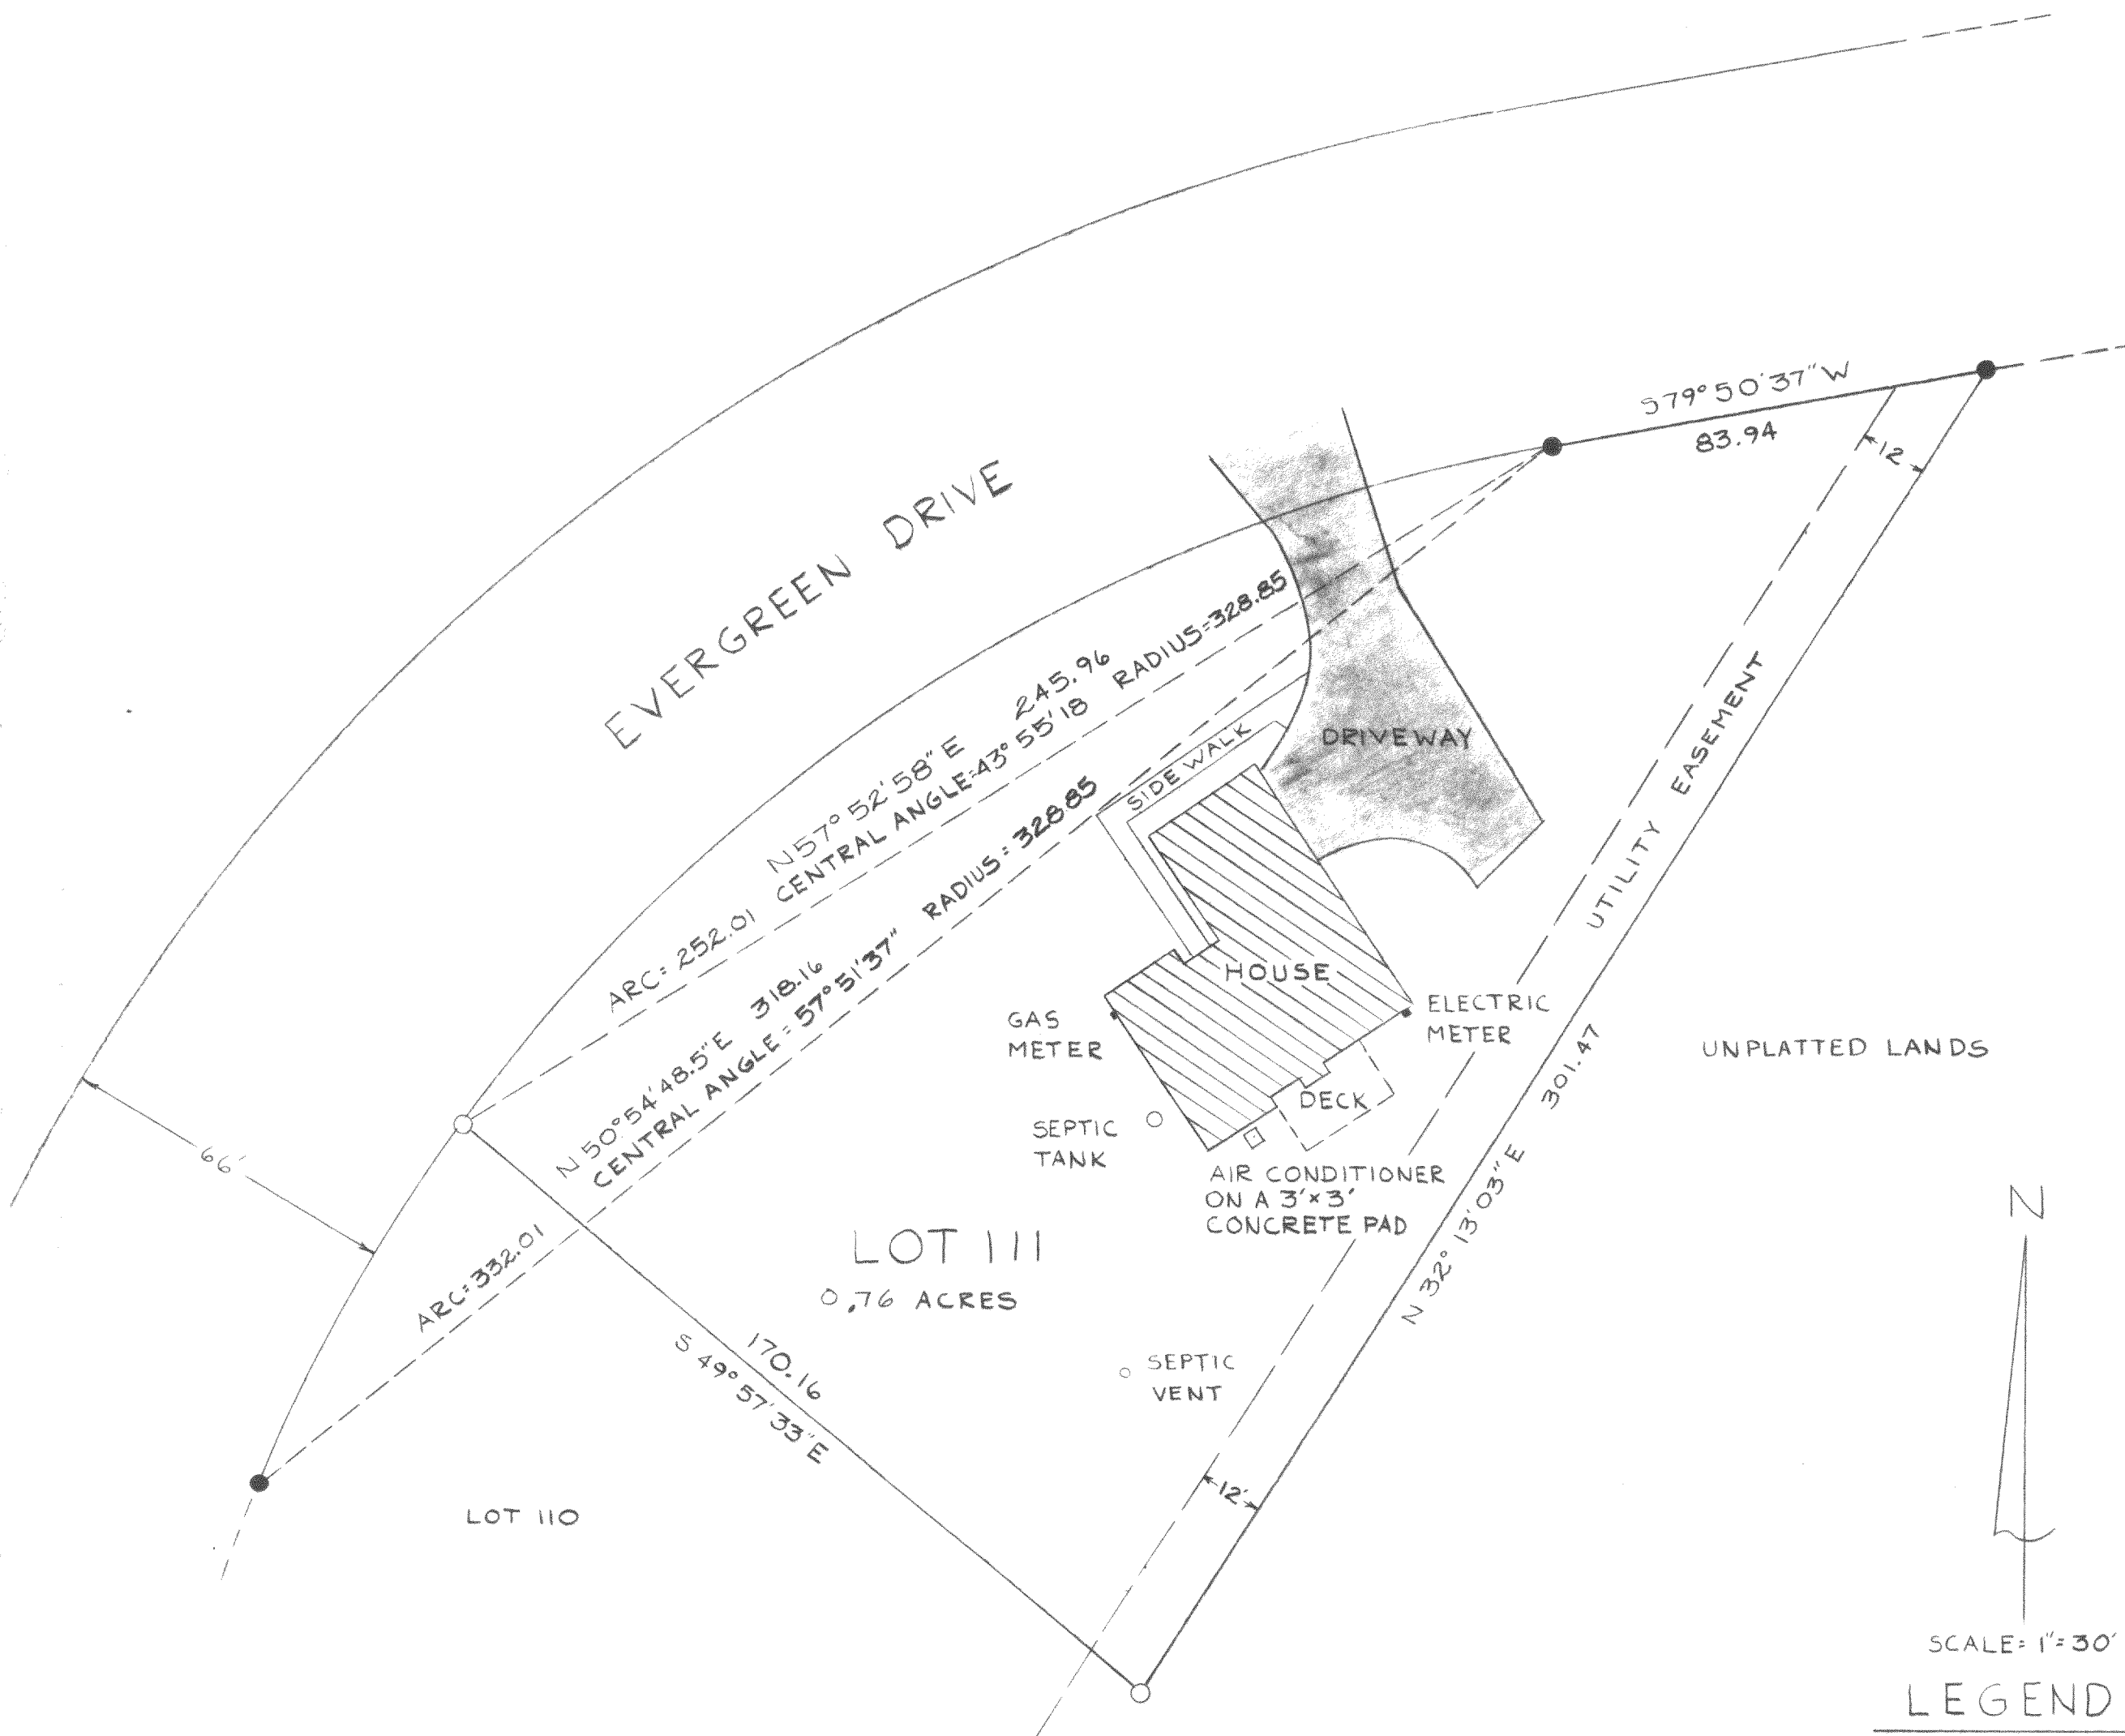

I HEREBY CERTIFY THAT I HAVE SURVEYED THE ABOVE DESCRIBED PROPERTY AND THAT THE PLAT HEREON DRAWN IS AN ACCURATE SURVEY AND A TRUE REPRESENTATION THEREOF AND CORRECTLY SHOWS THE BOUNDARY LINES OF SAID PROPERTY AND ALL BUILDINGS AND IMPROVEMENTS THEREON

● ~1 1/16" IRON BAR FOUND
○ ~1 1/2" IRON PIPE FOUND

SURVEYED FOR: VITO P. CALI
SURVEYED BY: THOMAS P.A. JENSEN S-1084
DRAFTED BY: R.L. MEADOWS
APRIL 14, 1981

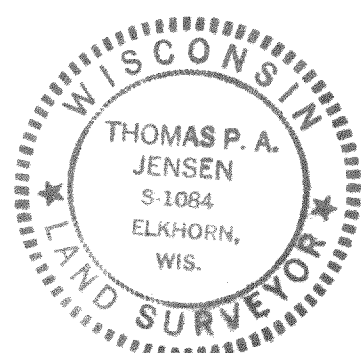

JENSEN SURVEYING & MAPPING S.C.
P.O. BOX 322
ELKHORN WISC 53121

Thomas P.A. Jensen