


DEC 05 2013

X:\Projects\7241\Dead\Survey\LOT1CSM2520

PLAT OF SURVEY  
LOT 1 OF CSM 2570  
LOCATED IN PART OF THE SW 1/4 OF  
THE SW 1/4 OF SECTION 7  
TOWN 3 NORTH, RANGE 17 EAST, TOWN OF LAFAYETTE,  
WALWORTH COUNTY, WISCONSIN

GRID NORTH  
WISCONSIN COORDINATE SYSTEM  
SOUTH ZONE  
ASSIGNED S. LINE OF THE SW 1/4  
SECTION 7, T.3N, R.17E  
S 88°02'09" W  
NAD 1983

LEGEND  
● = FOUND IRON PIPE STAKE  
⦿ = SET IRON REBAR STAKE  
(XXX) = RECORDED AS

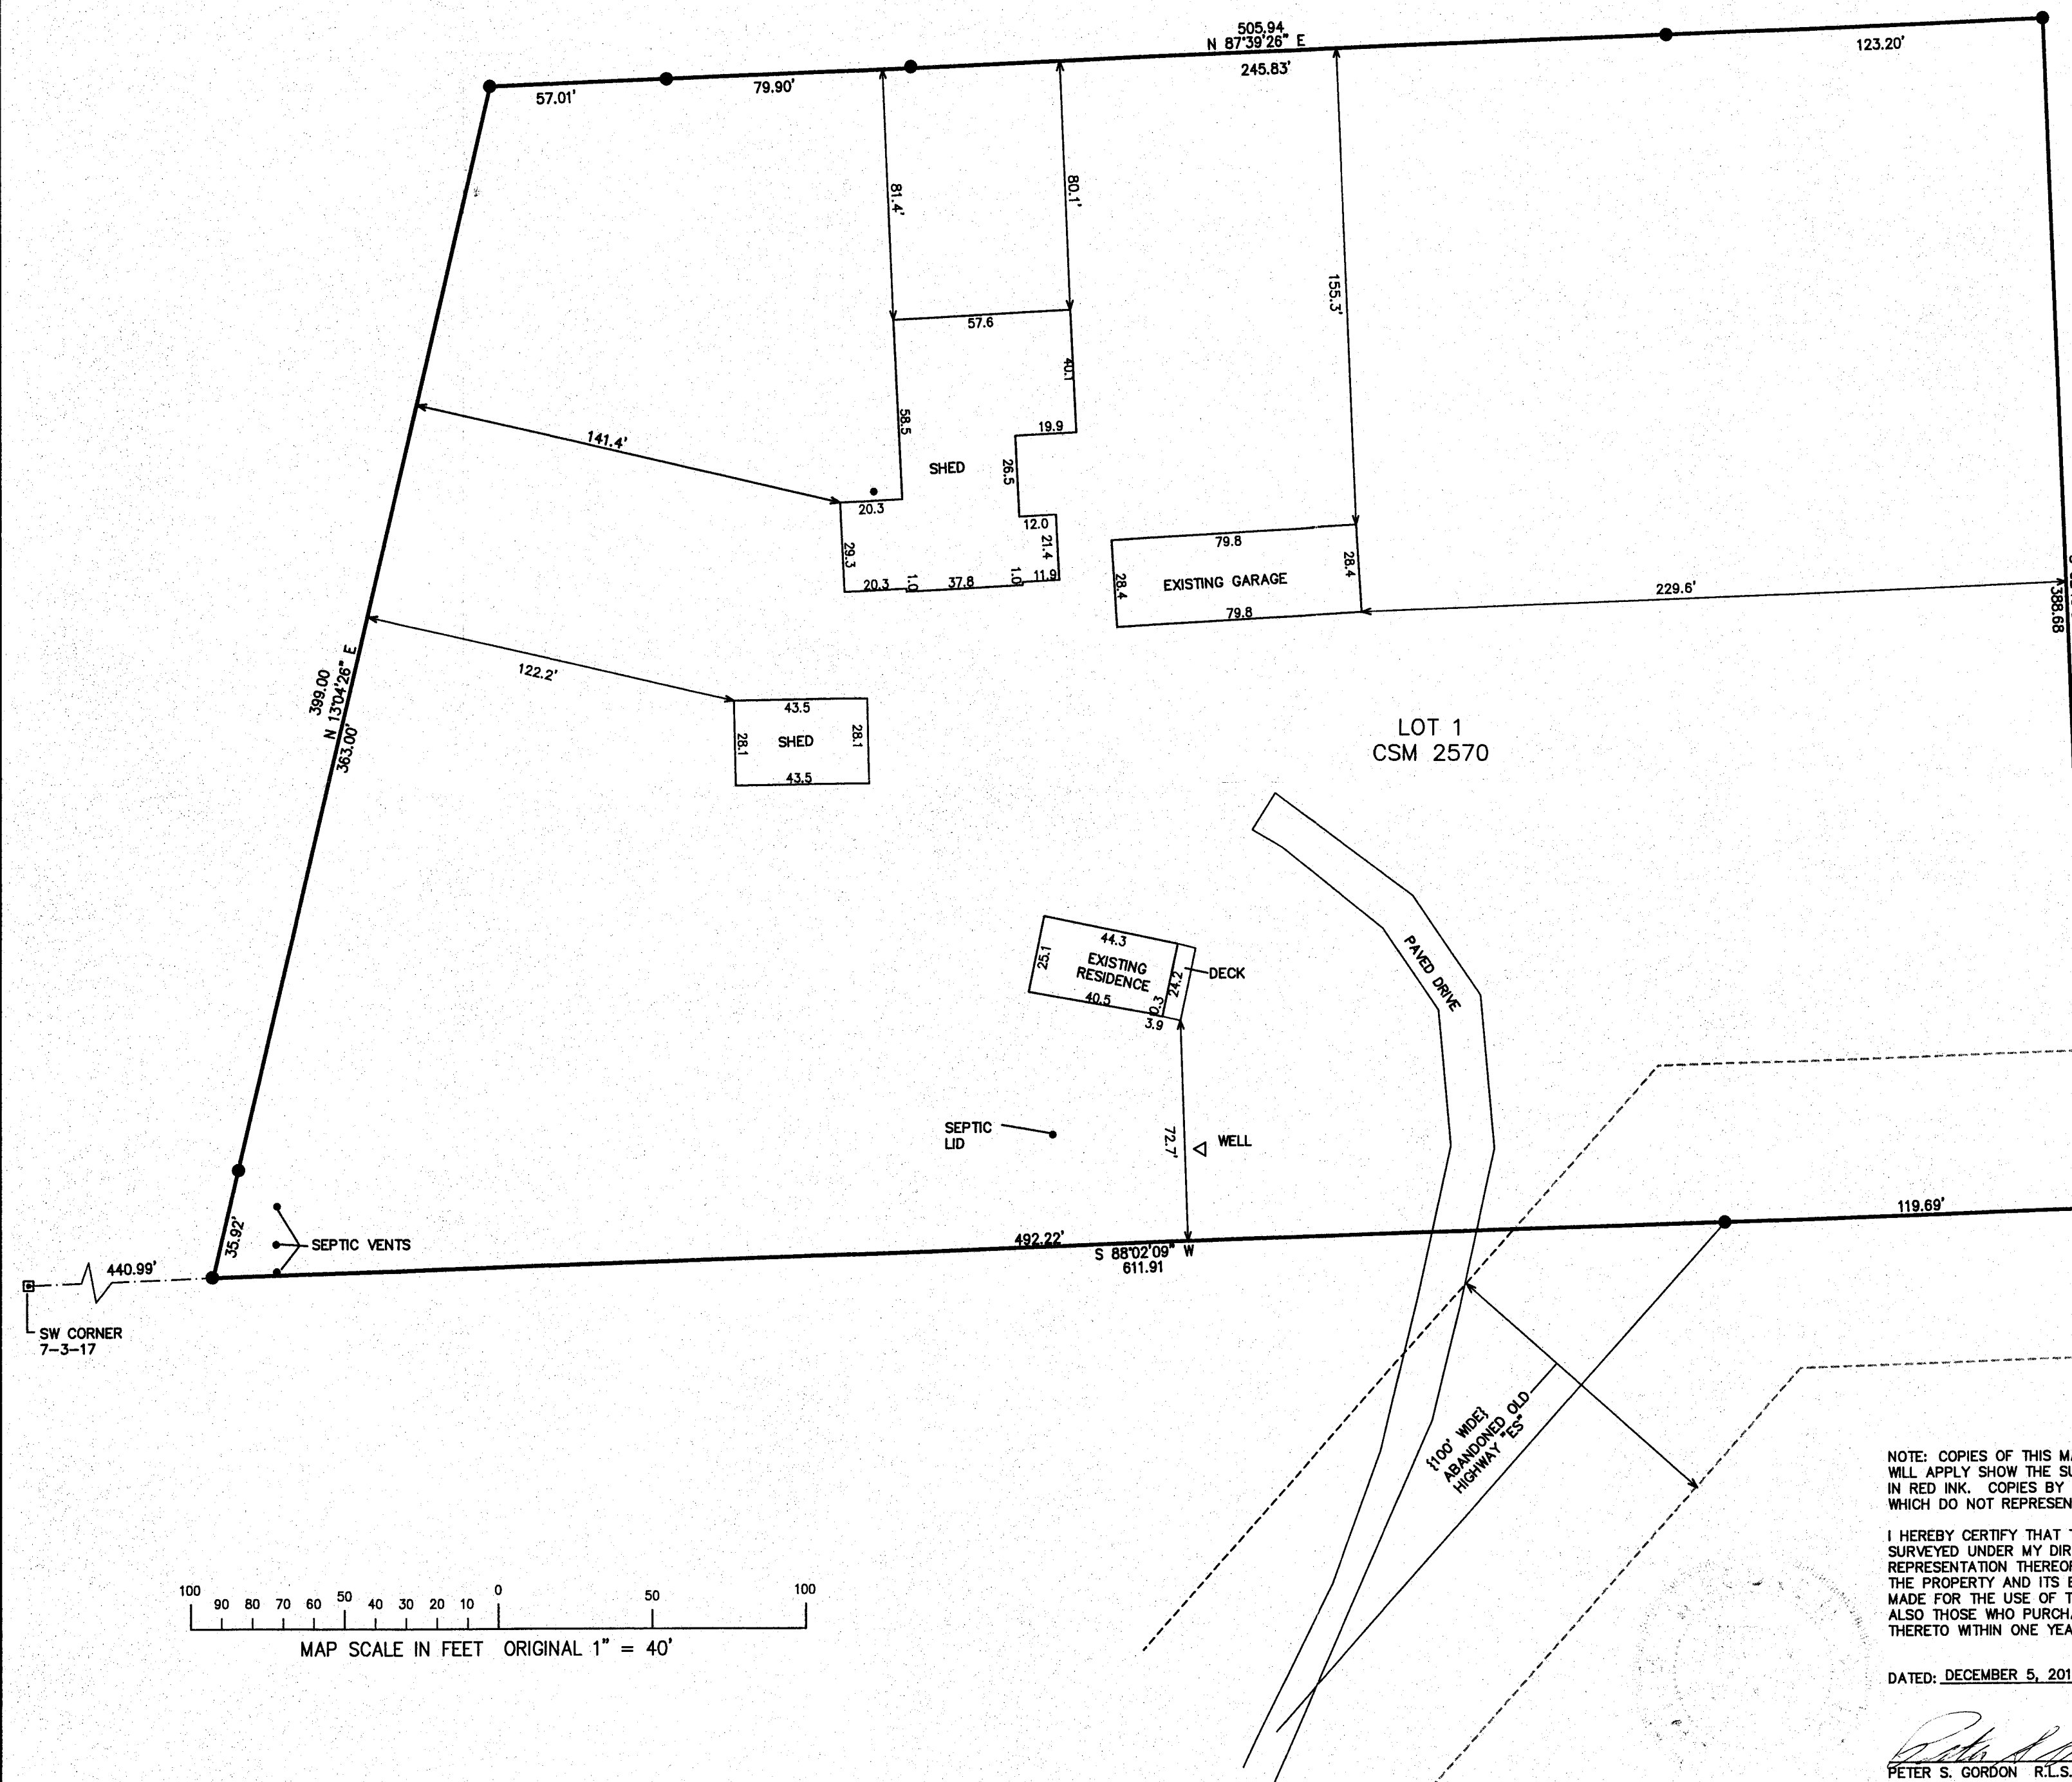

MAP SCALE IN FEET ORIGINAL 1" = 40'

NOTE: COPIES OF THIS MAP TO WHICH THE FOLLOWING CERTIFICATE  
WILL APPLY SHOW THE SURVEYOR'S ORIGINAL SEAL AND SIGNATURE  
IN RED INK. COPIES BY ANY OTHER MEANS MAY HAVE ALTERATIONS  
WHICH DO NOT REPRESENT THE SURVEYOR'S WORK PRODUCT.

I HEREBY CERTIFY THAT THE ABOVE DESCRIBED PROPERTY HAS BEEN  
SURVEYED UNDER MY DIRECTION AND THAT THE ABOVE MAP IS A TRUE  
REPRESENTATION THEREOF AND SHOWS THE SIZE AND LOCATION OF  
THE PROPERTY AND ITS EXTERIOR BOUNDARIES. THIS SURVEY IS  
MADE FOR THE USE OF THE PRESENT OWNERS OF THE PROPERTY, AND  
ALSO THOSE WHO PURCHASE, MORTGAGE, OR GUARANTEE THE  
THERE TO WITHIN ONE YEAR FROM THE DATE HEREOF.

DATED: DECEMBER 5, 2013

PETER S. GORDON R.L.S. 2101

RECEIVED  
JAN 14 2014  
By *jc*

WORK ORDERED BY:  
RICHARD HOWARTH  
820 W. WALWORTH ST.  
ELKHORN, WI. 53121

FARRIS, HANSEN & ASSOCIATES, INC.  
ENGINEERING - ARCHITECTURE - SURVEYING  
7 RIDGWAY COURT P.O. BOX 437  
ELKHORN, WISCONSIN 53121  
OFFICE: (262) 723-2098 FAX: (262) 723-5886

REVISIONS

PROJECT NO.  
7241.13  
DATE:  
12-02-2013  
SHEET NO.  
1 OF 1

KA2570-1 317-977