


CENTER
SECTION 24-3-18

N89°22'54"E

853.54'

found iron pipe
0.98' Northeast
of actual corner

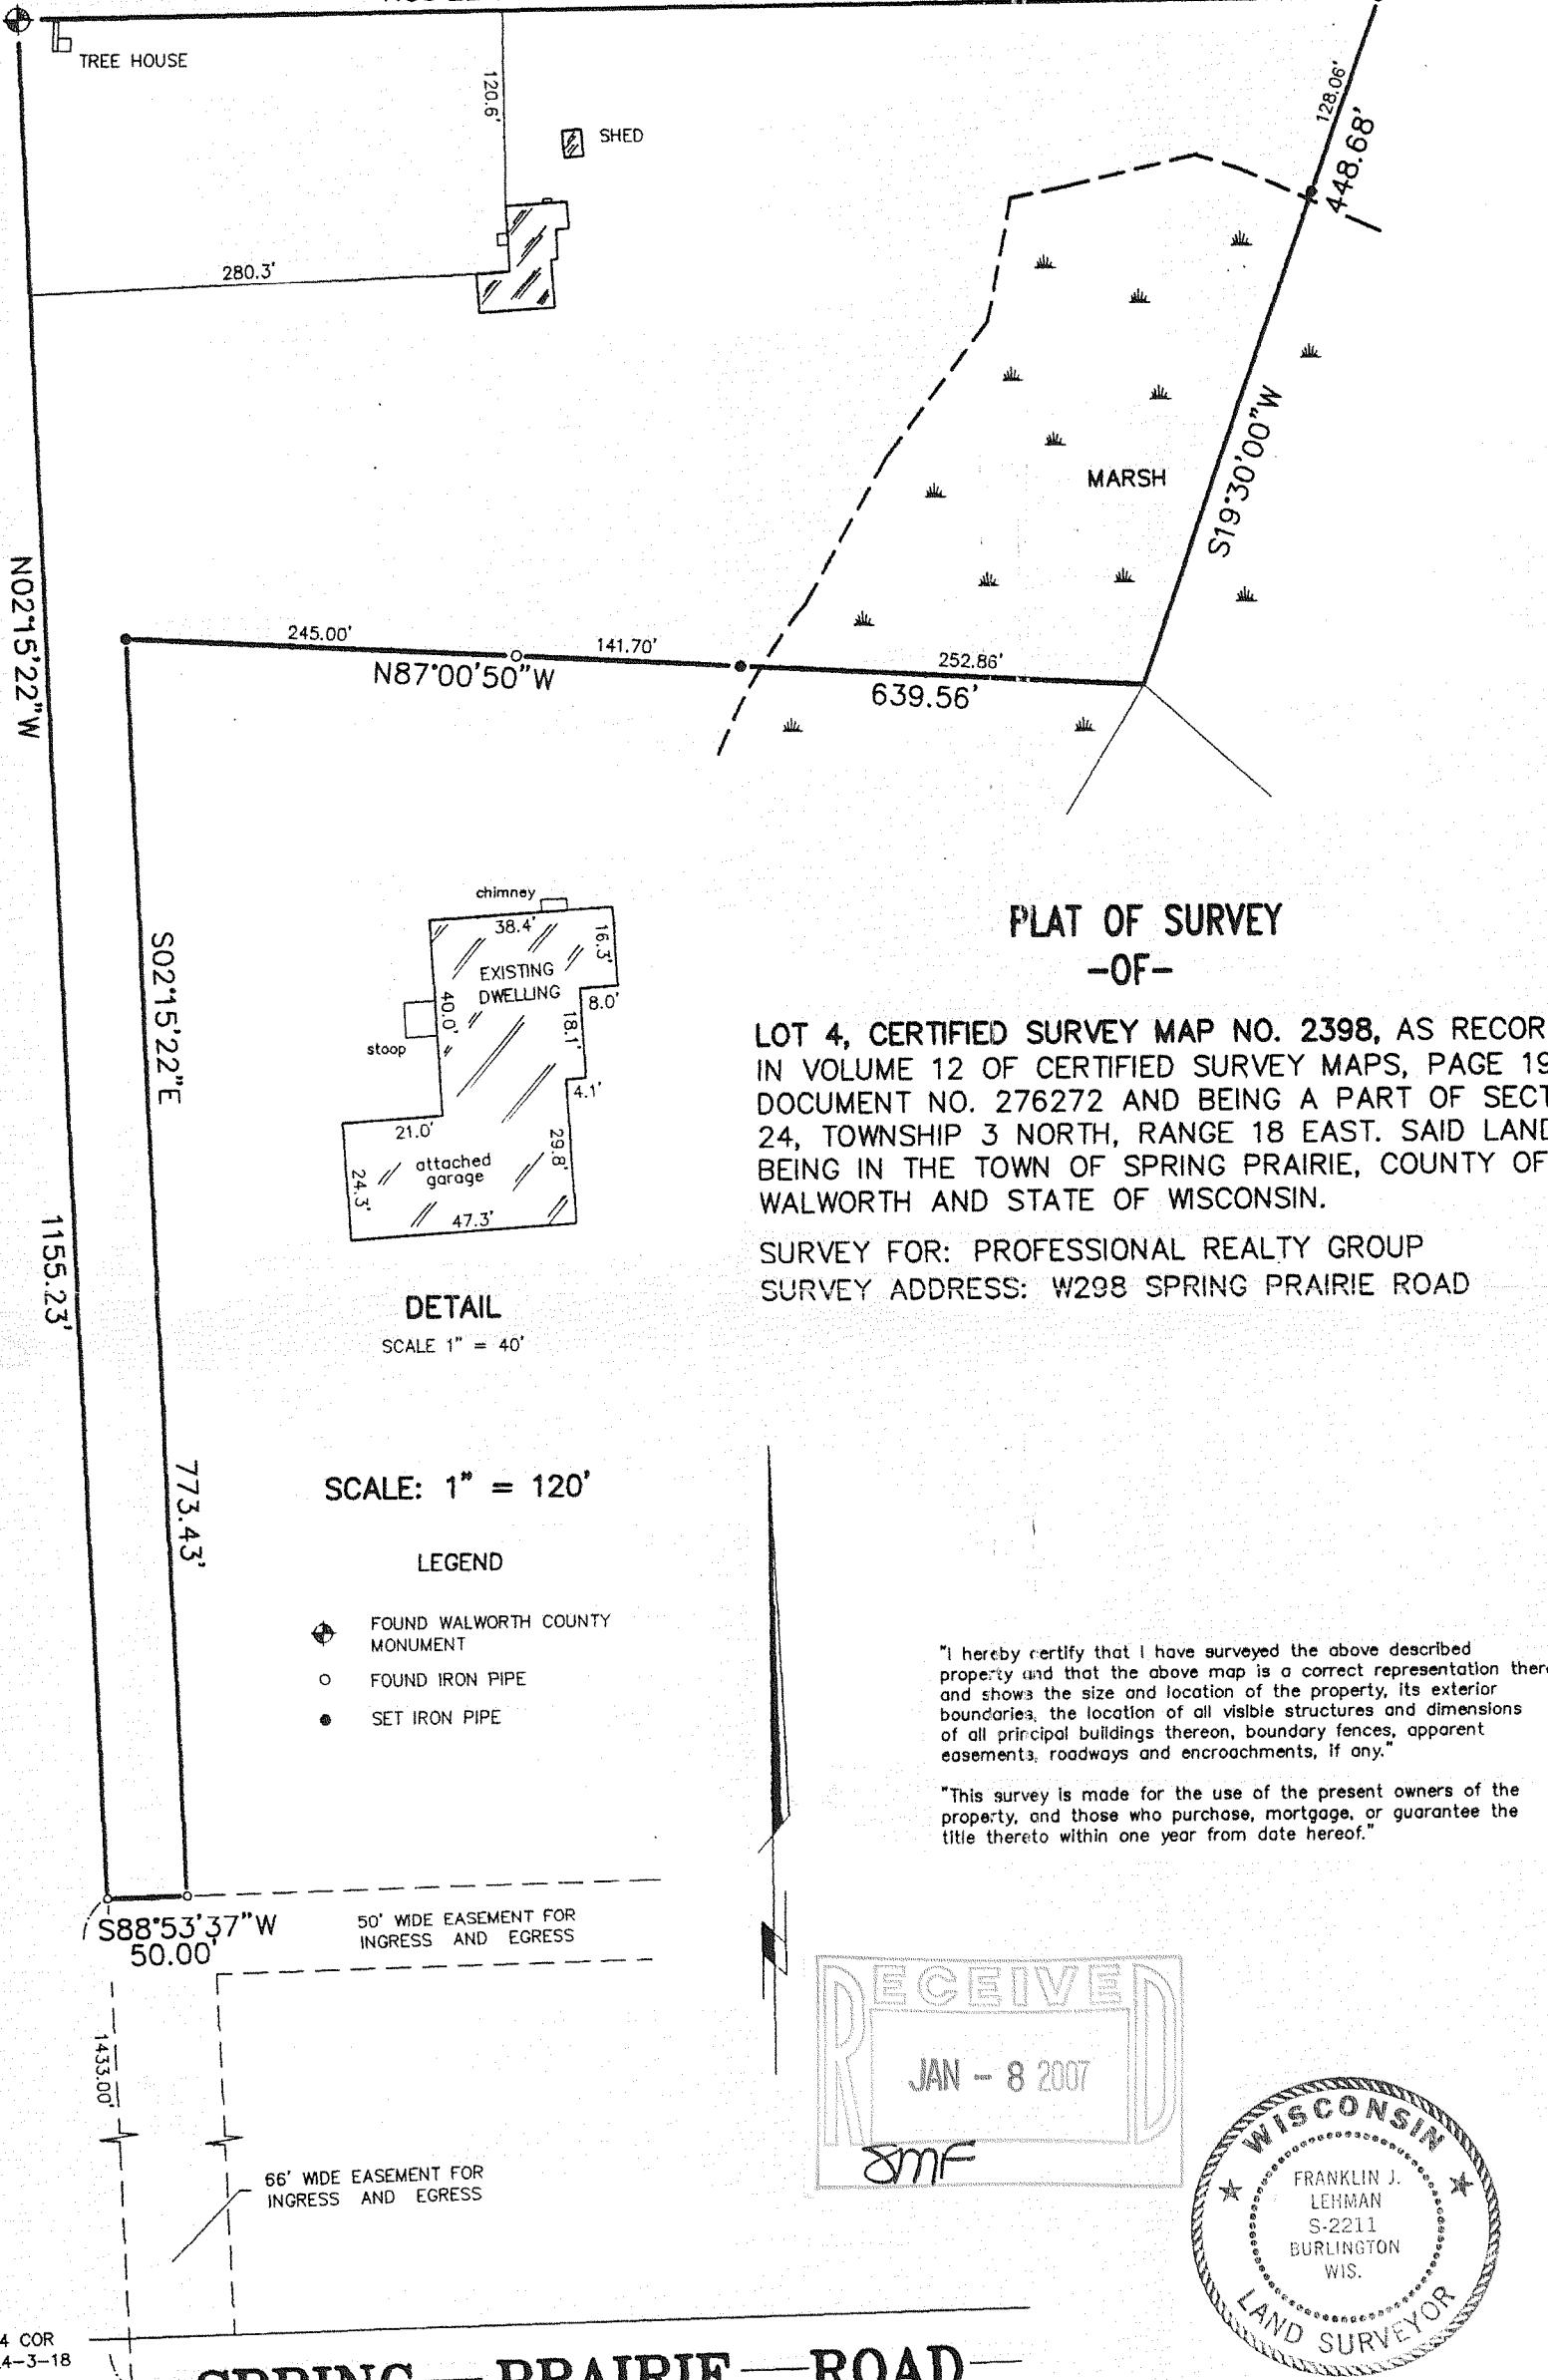


SOUTH 1/4 COR
SECTION 24-3-18

SPRING PRAIRIE ROAD

B.W. SURVEYING, INC.

LAND SURVEYS
MAPPING AND PLANNING
412 N. PINE STREET
BURLINGTON, WI 53105
(262)-767-0225

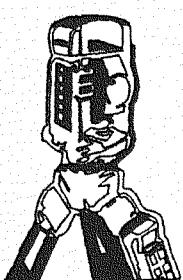

Franklin J. Lehman
FRANKLIN J. LEHMAN

S-2211

DEC. 19, 2005

7123

DATE

JOB NUMBER

0A2398-4

318-1003