



PLAT OF SURVEY OF

PHONE 262-637-4874
FAX 262-637-4221

Lot 2 of WALWORTH COUNTY CERTIFIED SURVEY MAP NUMBER 2516, according to the recorded plat thereof on file and of record in the office of the Register of Deeds, Walworth County, Wisconsin, as Document Number 295497, recorded October 27, 1994 in Volume 12 of Certified Survey Maps, page 261, and being part of the Southwest Quarter of the Southwest Quarter and the Northwest Quarter of the Southwest Quarter of Section 13, Township 3 North, Range 18 East of the 4th Principal Meridian, Town of Spring Prairie, County of Walworth and State of Wisconsin.

PERSONAL IDENTIFICATION NUMBER: OA251600002

HOUSE DETAIL
SCALE: 1 inch = 30 feet

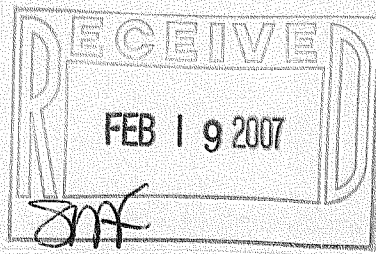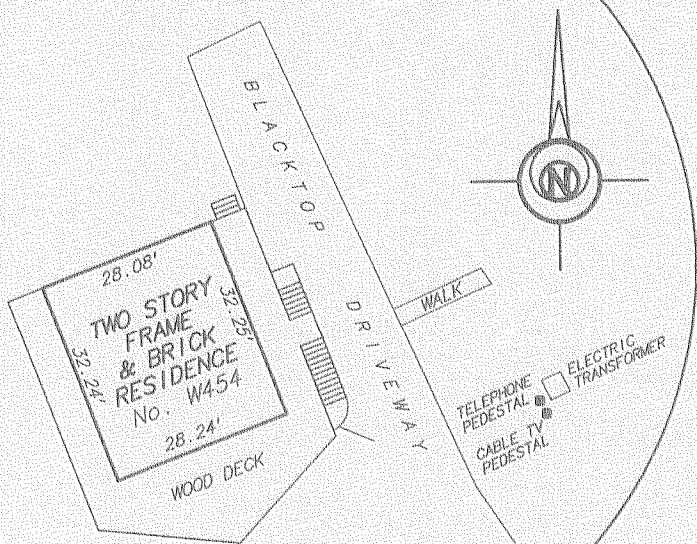

I hereby certify that I have surveyed the above described property and the above plat is a true representation thereof, and shows the size and location of the property, its exterior boundaries, the location and dimensions of all visible structures thereon, boundary fences, apparent easements and roadways and visible encroachments, if any.

This survey is made for the exclusive use of the present owners of the property, and also those who purchase, mortgage or guarantee the title thereto within ONE YEAR from the date hereof.

Dated at Bassett, Wisconsin this _____ day of _____ 2007.

Mark A. Bolender
Wisconsin Registered Land Surveyor S - 1784

SCALE: 1 inch = 80 feet

ORDERED BY: S. Baker

JOB NO. 07005

OA2516-2

318-1007