


PLAT OF SURVEY -OF-

LOT 2 OF CERTIFIED SURVEY MAP NO. 2931, TOWN OF SPRING PRAIRIE, AS RECORDED IN THE OFFICE OF THE REGISTER OF DEEDS FOR WALWORTH COUNTY, WISCONSIN ON DECEMBER 10, 1997 IN VOLUME 15 OF CERTIFIED SURVEY MAPS ON PAGES 198-200 AS DOCUMENT NO. 370007, SUBJECT TO THE JOINT DRIVEWAY EASEMENT DATED MAY 23, 2001, RECORDED JUNE 4, 2001 IN VOLUME 681 OF RECORDS, PAGES 5784-5787, WALWORTH COUNTY RECORDS. TOGETHER WITH A NON-EXCLUSIVE PERPETUAL EASEMENT FOR INGRESS AND EGRESS OVER OUTLOT 2 AS SHOWN ON SAID CERTIFIED SURVEY MAP NO. 2931.


SURVEY FOR: MATT SAUTBINE

SURVEY ADDRESS: W2154 C.T.H. "D"
ELKHORN

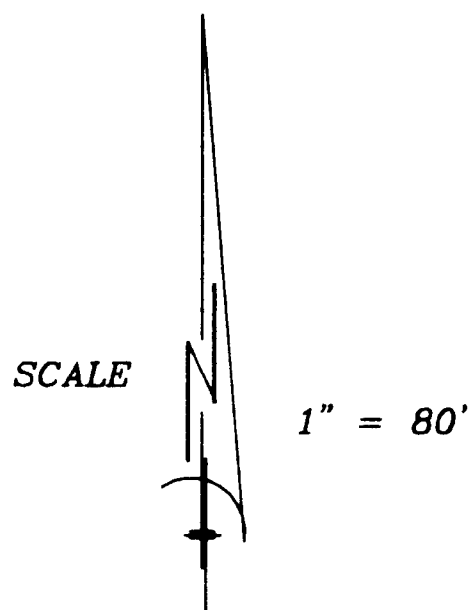



PROPOSED POLE BARN WAS STAKED ON ACTUAL CORNERS WITH 7 FOOT CONTROL ON THE SOUTH LINE. IT IS THE CONTRACTORS RESPONSIBILITY TO FIELD VERIFY ALL STAKES FOR DIMENSION AND LOCATION PRIOR TO CONSTRUCTION. IF ANY DISCREPANCIES OCCUR NOTIFY THIS OFFICE AT ONCE.

DETAIL SCALE 1" = 2'

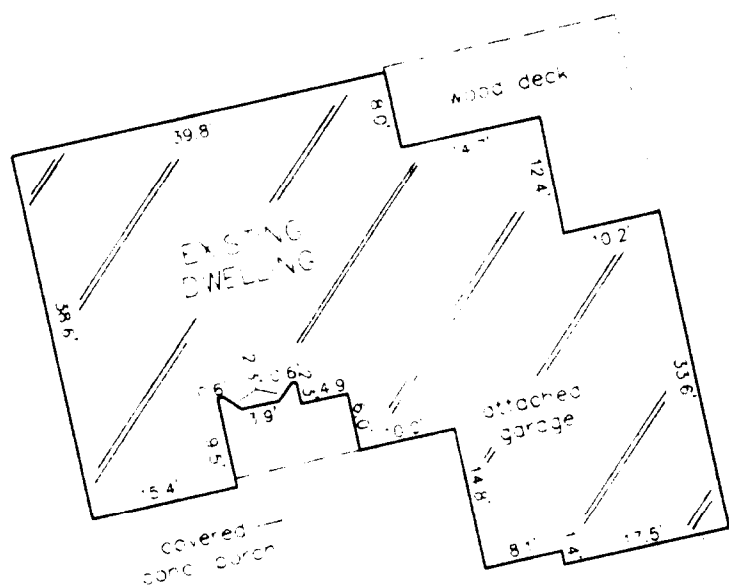


LEGEND

- FOUND IRON PIPE
- SET IRON PIPE
- ⊙ WELL
- ⊕ FOUND WALWORTH COUNTY STANDARD MONUMENT

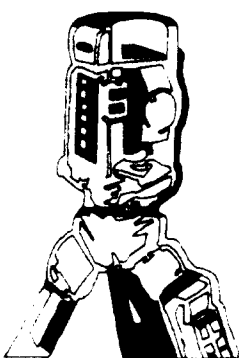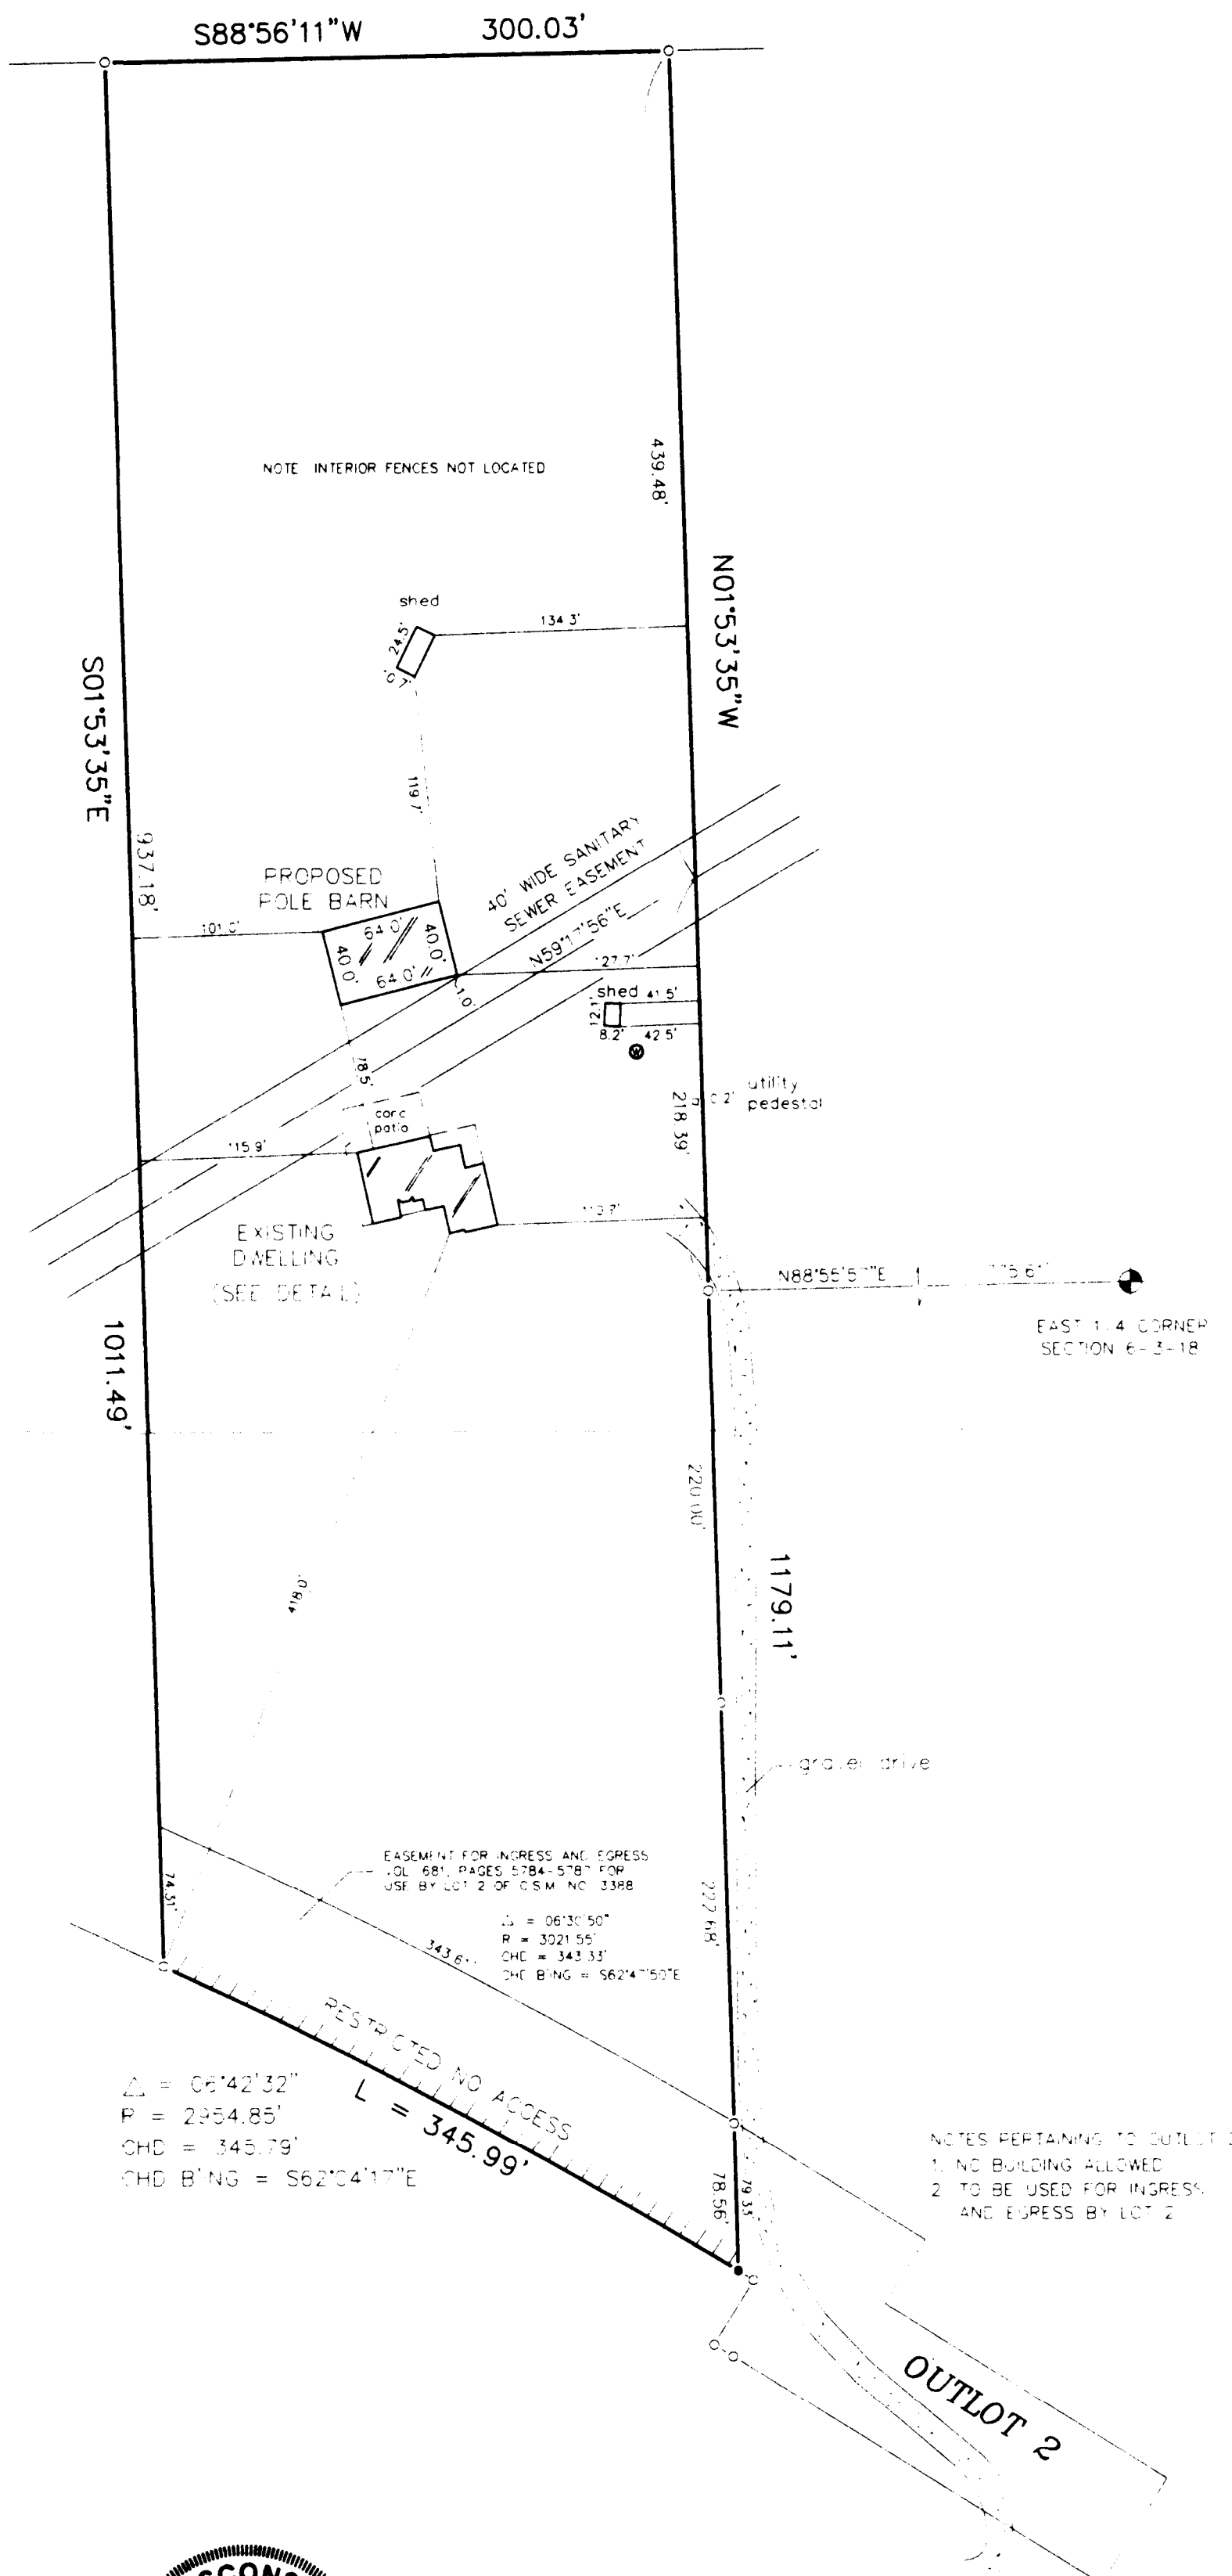


B.W. SURVEYING, INC.

412 N. PINE STREET
BURLINGTON, WI 53105
(262)-767-0225

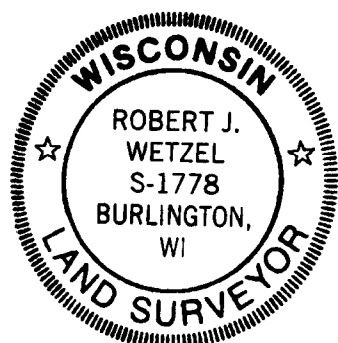

THIS IS NOT AN ORIGINAL PRINT UNLESS
THIS SEAL IS RED

ROBERT J. WETZEL S-1778

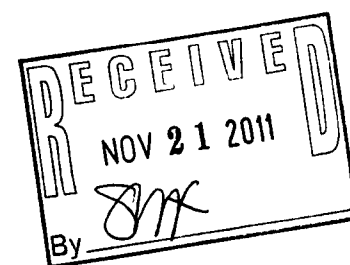

DRAWN BY: RW	DATE: 10/5/2010
CHECKED BY: BW	DRAWING NO.: 8250D1
JOB NO.: 8250	SHEET 1 OF 1

CA2931-2

318-1117