

Tax Parcel
OSP 1600008

Plat of Survey


of

Lot 1 of Certified Survey Map No. 4361,
recorded in Vol. 28 of Certified Survey Maps of Walworth County on Page 143
and located in the Southeast 1/4 and the Northeast 1/4 of Section 16, Town 3
North, Range 18 East, Town of Spring Prairie, Walworth County, Wisconsin.

Surveyed for: **Yuppie Hill Poultry**
W1384 Potter Road
Burlington, Wisconsin. 53105

S89°01'30"W 1481.10'
South line of the Northeast 1/4 of Section 16-3-18.

East 1/4 Corner
Section 16-3-18.
N 266.709.84
E 2,439.125.84

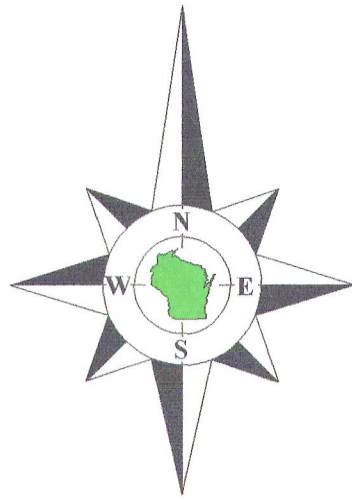

Bearings reference to the Wisconsin State
Plane Coordinate System, South Zone.


Lot 1 Tax Parcel OA436100001

7.188 Acres
313,119 Sq.Ft.
7.139 Acres
310,962 Sq.Ft.
Exclusive of R.O.W.

Silo
Height = 60'

Tax Parcel
OSP 1600008

Tax Parcel
OSP 1600008

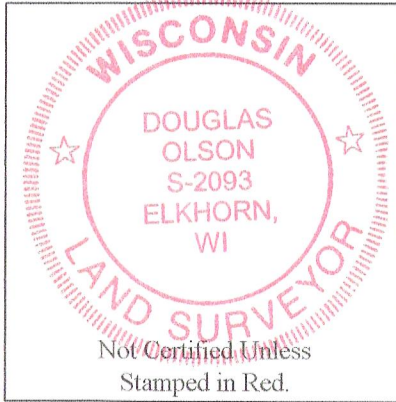

Notes:

- 1) This survey plat is not certified unless signed and sealed in red ink.
- 2) This survey is subject to Wisconsin lien laws. This Plat of Survey is the notice of intent to file lien. Lien waiver required.

Copyright 2008 by Jensen & Olson Land Surveying, LLC.

All rights reserved. No part of this survey plat may be reproduced or transmitted in any form by any means - graphic, electronic, or mechanical, including photocopying, tracing, or information storage and retrieval systems - without permission in writing from Douglas G. Olson, Jensen & Olson Land Surveying, LLC.

I, Douglas G. Olson, Wisconsin Registered Land Surveyor, do hereby certify that this survey was performed by me, or under my direction in full compliance with the owner's/agent's instructions and Chapter A-E 7 of the Wisconsin Administrative Code "Minimum Standards for Property Surveys"; and that this map is an accurate representation thereof to the best of my knowledge and belief.

Douglas G. Olson
Wisconsin Registered Land Surveyor - 2093



Sheet 1 of 1 Sheets

Drawing Name: 12w18e-2010089-2010089PlatRev3.dwg

Job Reference Number

2010.089

Legend

- Found Iron Rod
- Set Iron Rod, 3/4" dia.
- Set Wood Stake
- Recorded Information
- ✕ Utility Pole
- ▨ Asphalt Surface
- ▨ Concrete Surface
- ▨ Gravel Surface



Jensen & Olson Land Surveying, LLC

45 South Wisconsin Street * P.O. Box 322 * Elkhorn, Wisconsin. 53121
Telephone: (262) 723-3434 * Facsimile: (262) 723-8044
Email: jensen.olson@elknet.net

Scale in Feet

1" = 40'



Survey date: April 1, 2008.

Revisions: No. 3 - Lot Line Adj.
No. 4 - Proposed Building
Size and location
No. 5 - Recorded C.S.M.
No. 6 - As-Built location

2010.089

OA4361-1

318-1122