

PLAT OF SURVEY -OF-


LOT 1 OF CERTIFIED SURVEY MAP NO. 3237, BEING PART OF THE NORTHEAST 1/4 AND THE SOUTHEAST 1/4 OF THE SOUTHEAST 1/4 OF SECTION 27, AND PART OF THE NORTHEAST 1/4 OF THE NORTHEAST 1/4 OF SECTION 34, ALL IN TOWNSHIP 3 NORTH, RANGE 18 EAST OF THE FOURTH PRINCIPAL MERIDIAN, IN THE TOWNSHIP OF SPRING PRAIRIE, WALWORTH COUNTY WISCONSIN.

SURVEY FOR: ROSS MARTIN

SURVEY ADDRESS: W976 STATE ROAD 11

DETAIL

SCALE 1" = 30'

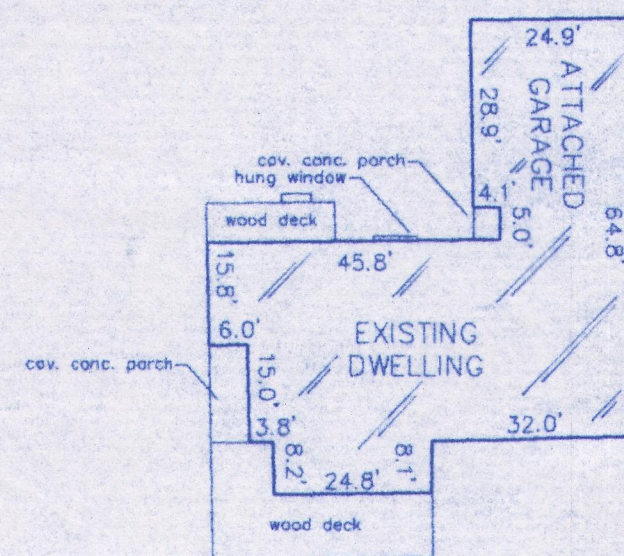

LEGEND


- FOUND IRON PIPE
- SET IRON PIPE

"I hereby certify that I have surveyed the above described property and that the above map is a correct representation thereof and shows the size and location of the property, its exterior boundaries, the location of all visible structures and dimensions of all principal buildings thereon, boundary fences, apparent easements, roadways and encroachments, if any."

"This survey is made for the use of the present owners of the property, and those who purchase, mortgage, or guarantee the title thereto within one year from date hereof."

SCALE


1" = 100'

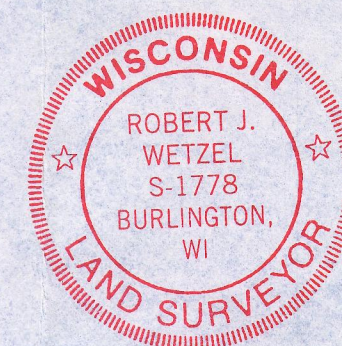

Robert J. Wetzel
ROBERT J. WETZEL S-1778

CURVE DATA

RADIUS = 60.00'
LENGTH = 70.58'
CHORD = 66.58'
BEARING = S89°34'40"W

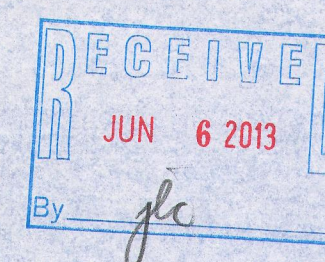

REVISED: MAY 2, 2013
REVISED: APRIL 9, 2013

DRAWN BY: RW	DATE: 08/08/2011
CHECKED BY: BW	DRAWING NO.: 8354D1
JOB NO.: 8354	SHEET 1 OF 1

OA3237-1

318-1143