


LOT 4 OF CERTIFIED SURVEY MAP NO. 3237, BEING PART OF THE NORTHEAST 1/4 AND THE SOUTHEAST 1/4 OF THE SOUTHEAST 1/4 OF SECTION 27, AND PART OF THE NORTHEAST 1/4 OF THE NORTHEAST 1/4 OF SECTION 34, ALL IN TOWNSHIP 3 NORTH, RANGE 18 EAST OF THE FOURTH PRINCIPAL MERIDIAN, IN THE TOWNSHIP OF SPRING PRAIRIE, WALWORTH COUNTY WISCONSIN.

SURVEY ADDRESS: W958 HIGHWAY "11"

NOTE: BEARINGS HEREON RELATE TO
CERTIFIED SURVEY MAP NO. 3237.


MONUMENTATION BY WRITTEN AGREEMENT.
WITH THE ABOVE NAMED CLIENT HAS BEEN
WAIVED IN ACCORDANCE WITH A-E 7.01(2)
OF THE WISCONSIN ADMINISTRATIVE CODE.

DETAIL
SCALE 1" = 30'

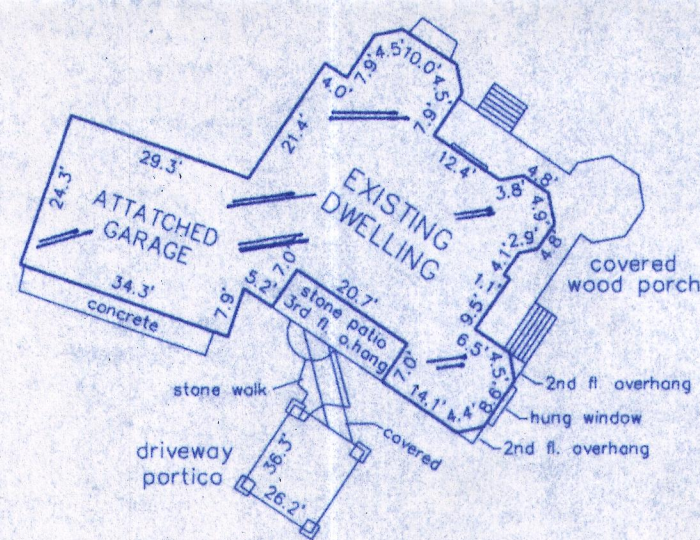

"I hereby certify that I have surveyed the above described property and that the above map is a correct representation thereof and shows the size and location of the property, its exterior boundaries, the location of all visible structures and dimensions of all principal buildings thereon, boundary fences, apparent easements, roadways and encroachments, if any."


"This survey is made for the use of the present owners of the property, and those who purchase, mortgage, or guarantee the title thereto within one year from date hereof."

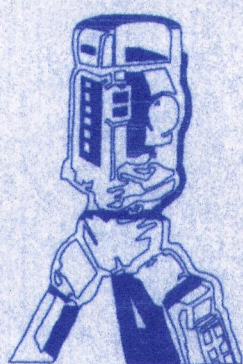


412 N. PINE STREET
BURLINGTON, WI 53105
(262)-767-0225



S.T.H.

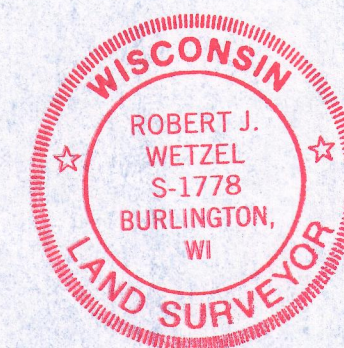

Robert J. Wetzel
ROBERT J. WETZEL S-1778

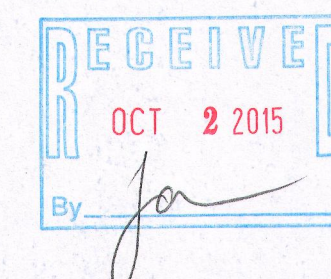

DRAWN BY: RW	DATE: 07/13/2015
CHECKED BY: BW, DW	DRAWING NO.: 8941D1
JOB NO.: 8941	SHEET 1 OF 1