

LAND-MARK SURVEYING

Mark L. Miritz


Wisconsin Professional Land Surveyor S-2582

N9330 Knuteson Drive
Whitewater, WI 53190
Phone: (262) 495-3284
MARKMIRITZ@
LAND-MARKSURVEYING.COM

PLAT OF SURVEY

LOT 1 OF CERTIFIED SURVEY MAP NO. 3797,
LOCATED IN PART OF THE SOUTHEAST 1/4 OF
THE SOUTHWEST 1/4 OF SECTION 18, TOWN
3 NORTH, RANGE 18 EAST, SPRING PRAIRIE
TOWNSHIP, WALWORTH COUNTY, WISCONSIN

ORDERED BY: BOB & CAROLYN HANIZESKI
2504 HONEY CREEK CIRCLE
APARTMENT 720
EAST TROY, WI 53120

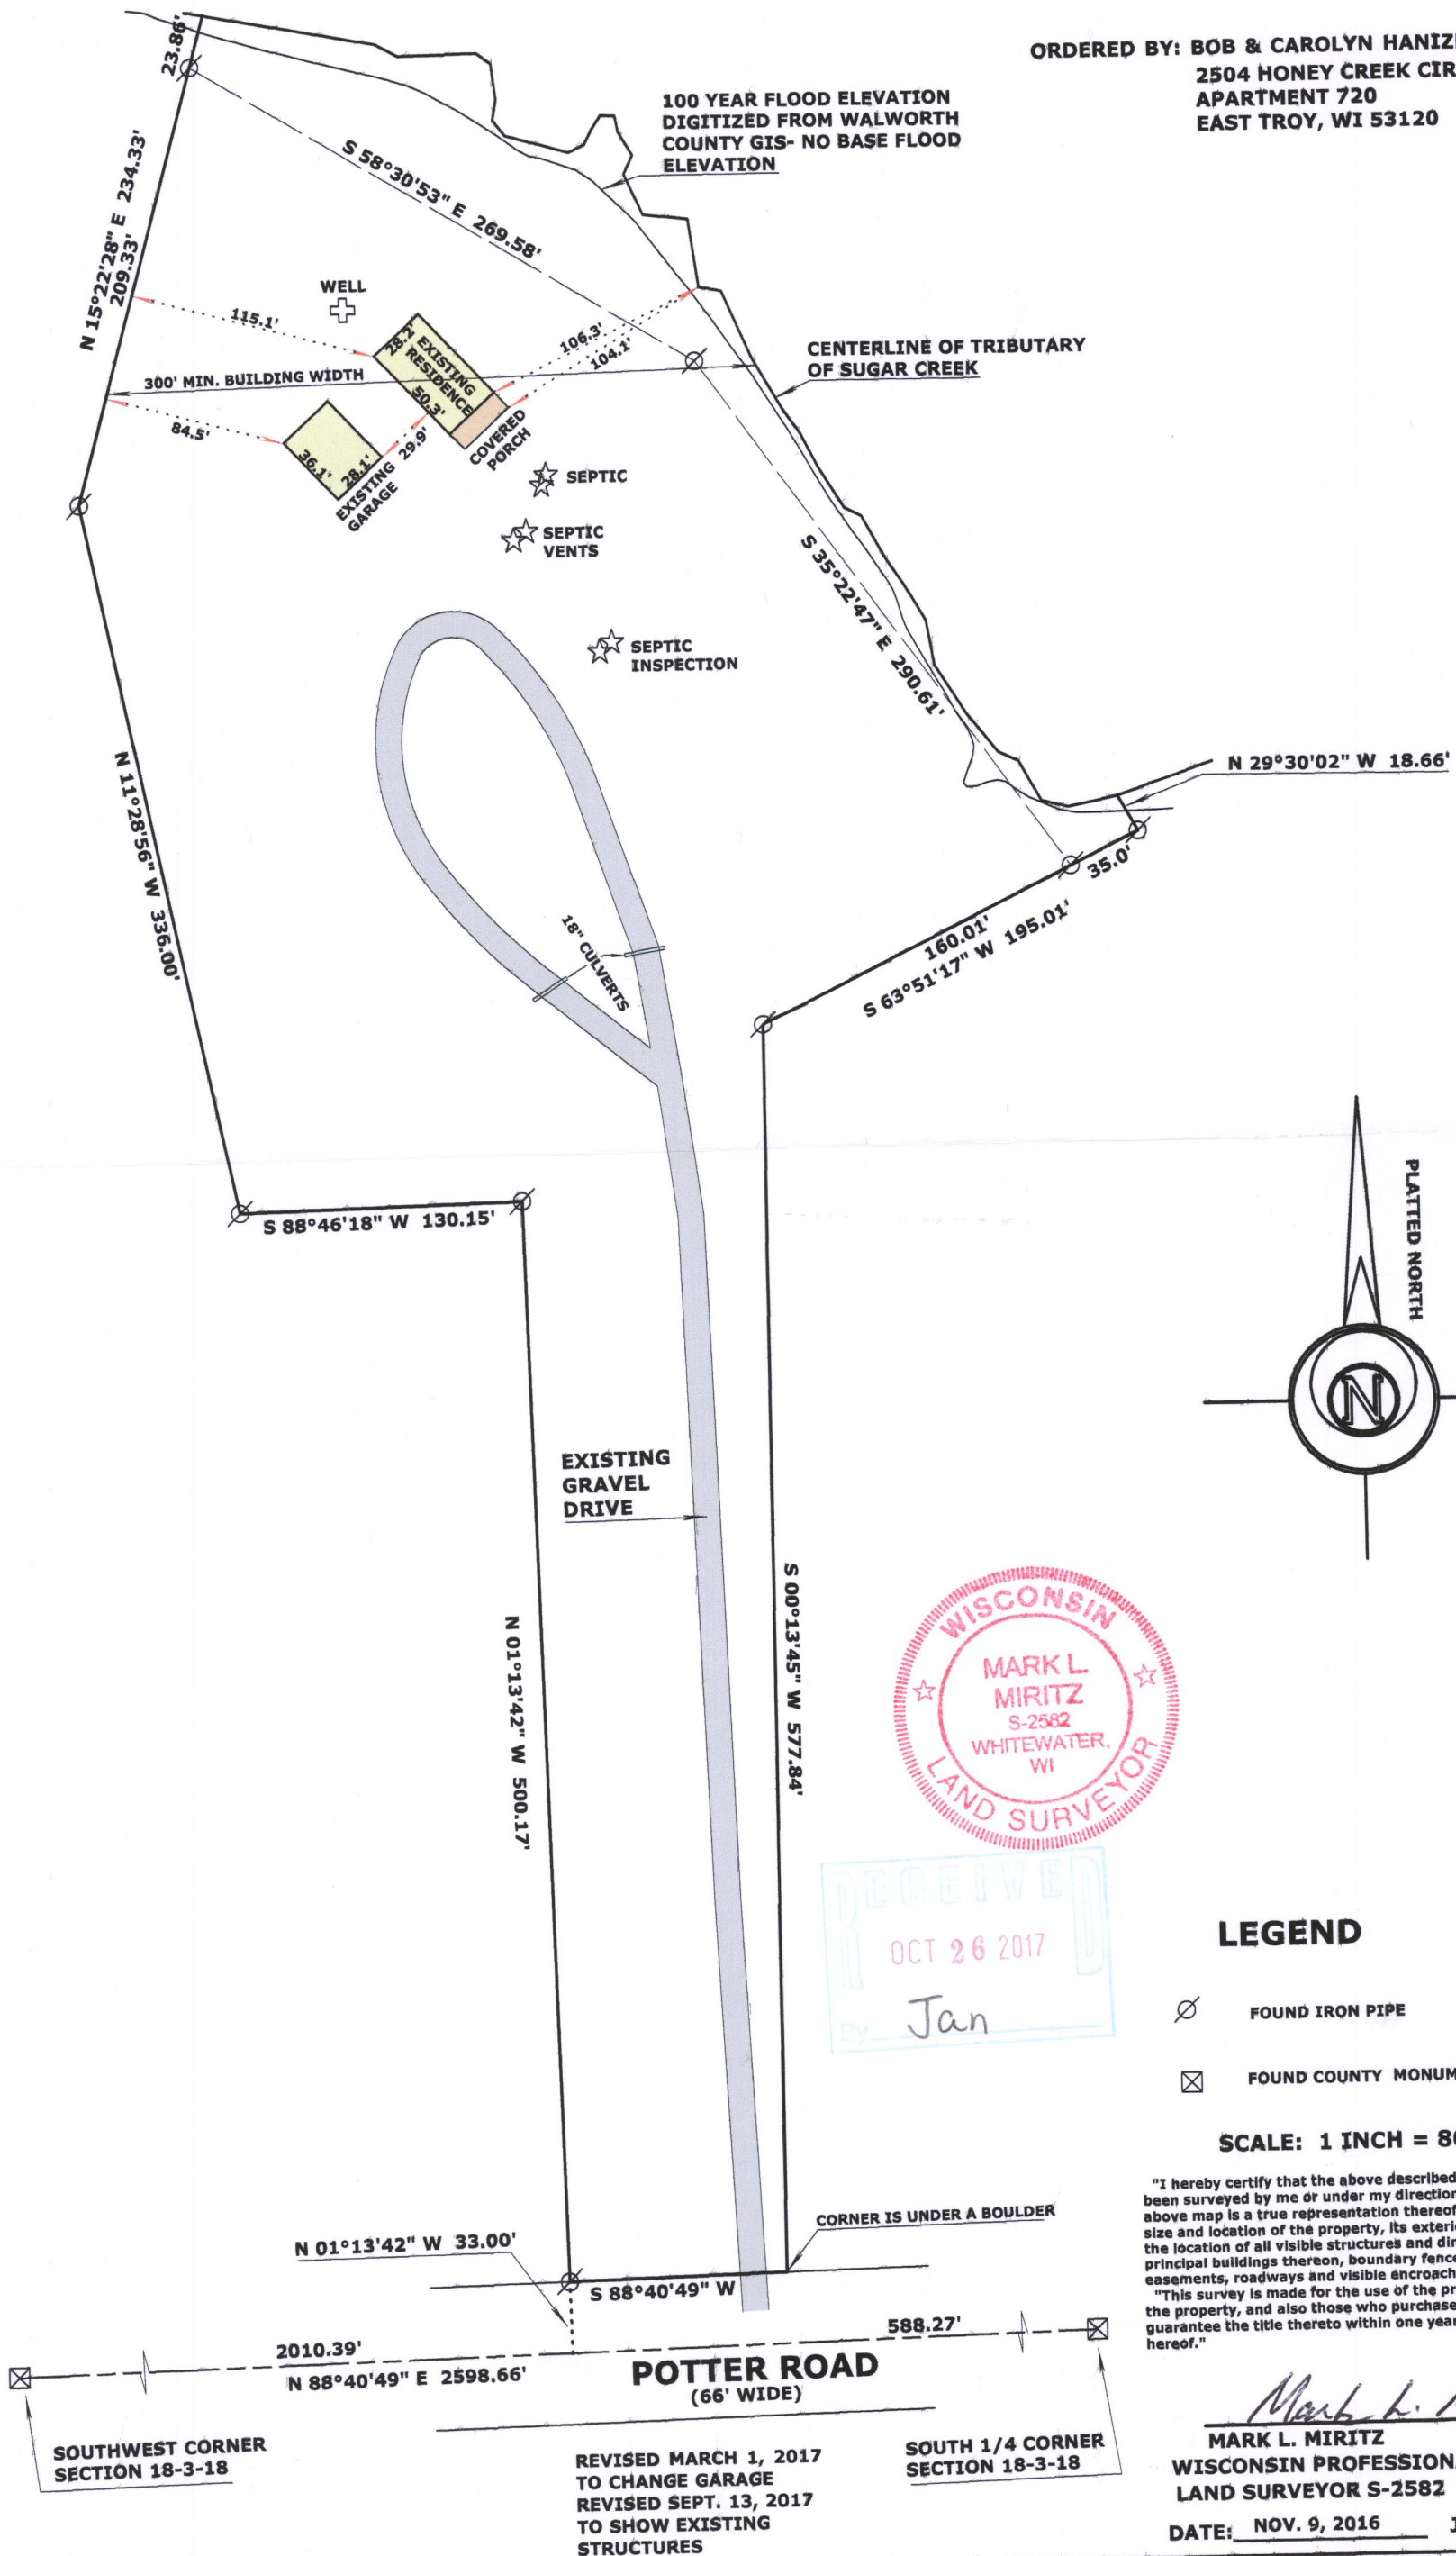

0A3797-1

318-1241