


CERTIFIED SURVEY MAP NO. _____

PART OF THE SOUTHWEST 1/4 OF SECTION 13, T. 3 N., R. 18 E. OF THE 4TH P.M., TOWNSHIP OF SPRING PRAIRIE, COUNTY OF WALWORTH, STATE OF WISCONSIN AND MORE PARTICULARLY DESCRIBED AS FOLLOWS: COMMENCE AT A CONCRETE MONUMENT AT THE SOUTHWEST CORNER OF LOT 1, BLOCK 22, OF THE FIRST ADDITION TO HONEY LAKE, A PLAT OF RECORD, RUN THENCE S. 85°55'10" W., 509.79 FEET TO THE PLACE OF BEGINNING OF PARCEL OF LAND HEREINAFTER DESCRIBED: RUN THENCE S. 0°04'40" W., 150.42 FEET; THENCE S. 89°55'20" E., 51.01 FEET; THENCE S. 3°18'50" E., 172.75 FEET TO THE CENTER LINE OF THE POTTER ROAD; THENCE S. 83°25'20" W., ALONG THE CENTER LINE OF SAID ROAD, 196.31 FEET; THENCE N. 3°18'50" W., 199.21 FEET; THENCE N. 0°11'50" W., 197.23 FEET; THENCE S. 89°55'20" E., 146.43 FEET; THENCE S. 0°04'40" W., 50.60 FEET TO THE PLACE OF BEGINNING. CONTAINING 1.501 ACRES OF LAND. SUBJECT TO THE RIGHTS OF THE PUBLIC OVER THE SOUTH SIDE FOR HIGHWAY PURPOSES. CONTAINING 1.352 ACRES OF LAND EXCLUSIVE OF HIGHWAY.

I HEREBY CERTIFY THAT I HAVE SURVEYED THE LAND DESCRIBED ABOVE AND THAT THE PLAT DRAWN HEREON IS A CORRECT REPRESENTATION OF SAID SURVEY. I FURTHER CERTIFY THAT THE BUILDINGS ON SAID LAND ARE LOCATED AS SHOWN ON THIS PLAT. I FURTHER CERTIFY THAT I HAVE COMPLIED WITH THE REQUIREMENTS OF SECTION 236.34 OF THE WISCONSIN STATUTES ON CERTIFIED SURVEYS AND SECTION 6.0 OF THE WALWORTH COUNTY SUBDIVISION CONTROL ORDINANCE.

JOHN F. DEGEN, LAND SURVEYOR #242
589 N. PINE ST., BURLINGTON, WISCONSIN.

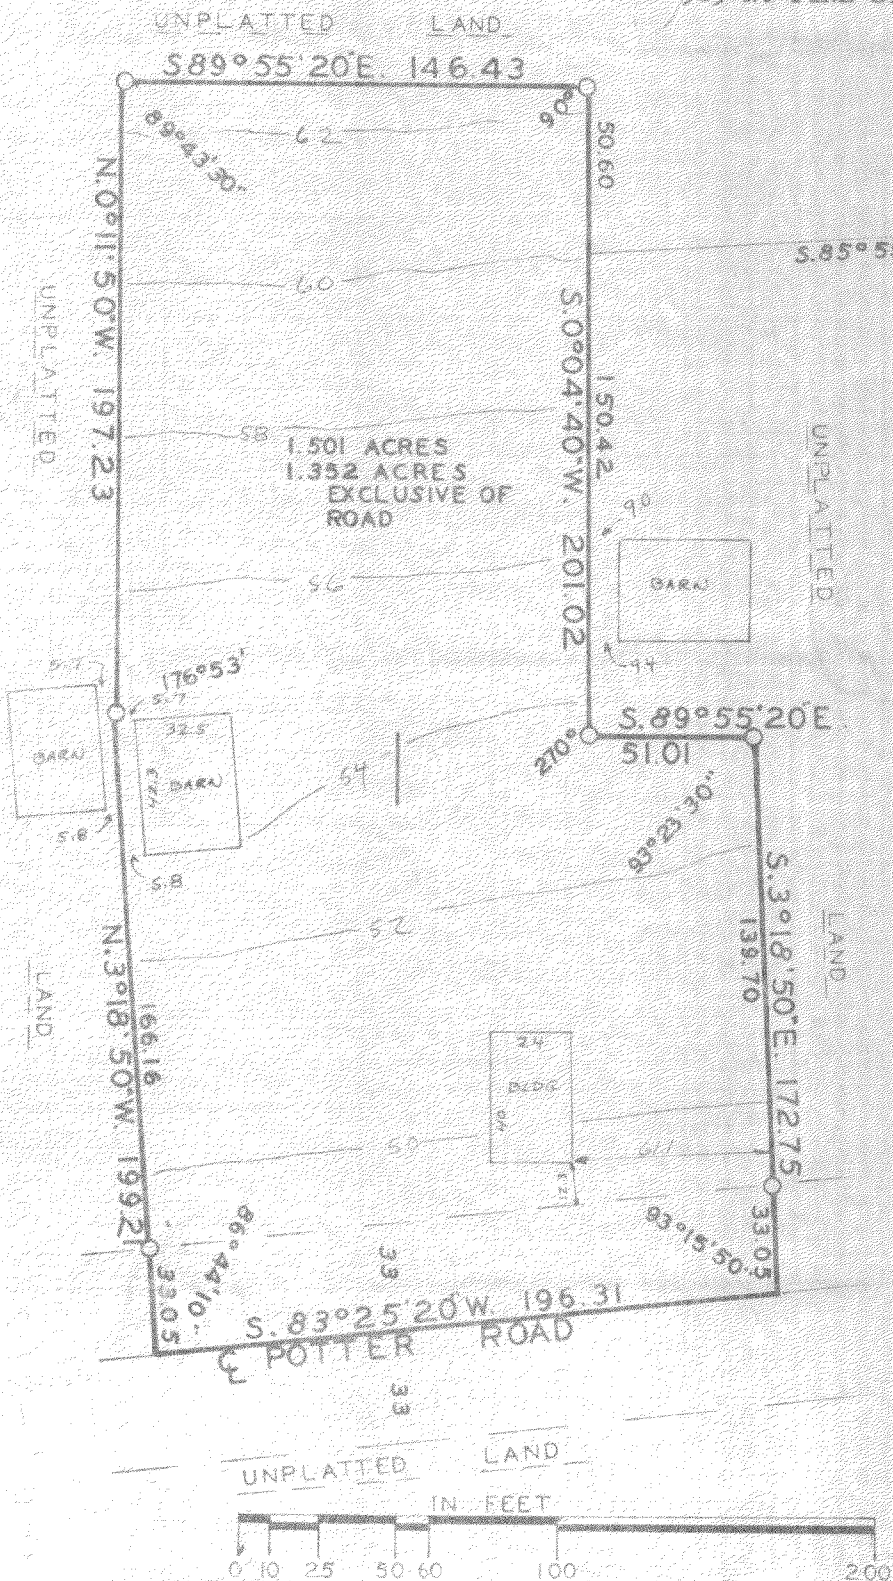

CONCRETE MONUMENT FOUND
SW CORNER LOT 1, BLOCK 22,
HONEY LAKE 1ST ADDITION.

SCALE 1" = 60'

1" X 24" IRON PIPE STAKE WEIGHING AT
LEAST 1.13 LBS/FT.

CONCRETE MONUMENT FOUND
BEARINGS ARE RELATIVE TO THE WEST LINE OF
THE PLAT OF THE FIRST ADDITION TO HONEY
LAKE SUBDIVISION WHICH WAS ASSUMED AS
S. 0° 11' 50" W.


OWNER: LARRY GOUGH
8845 MANSFIELD RD.
MORTON GROVE, ILLINOIS 60053

APPROVED BY THE WALWORTH COUNTY PARK AND
PLANNING COMMISSION ON THIS _____ DAY OF
_____, 1974.

CHAIRMAN

ELEVATIONS FOR CONTOURS ON
ASSUMED DATUM.

SOIL TYPE AS TAKEN FROM SWRPC MAP:
NO. 72 FOX LOAM.

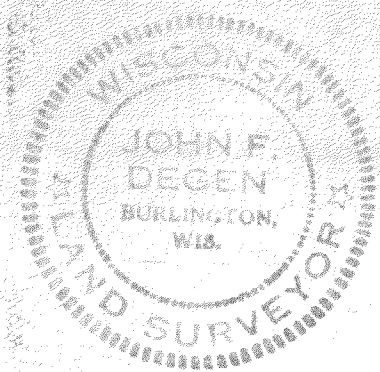

C. 2. 402

318-126