
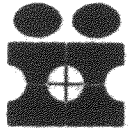


Plat of Survey

Survey For: Bielinski Brothers Builders
Location: Hwy. DD

D. Fleming

Description: Part of the East 1/2 of Section 23, T. 3N., R. 18E., Town of Spring Prairie, Walworth County, Wisconsin.

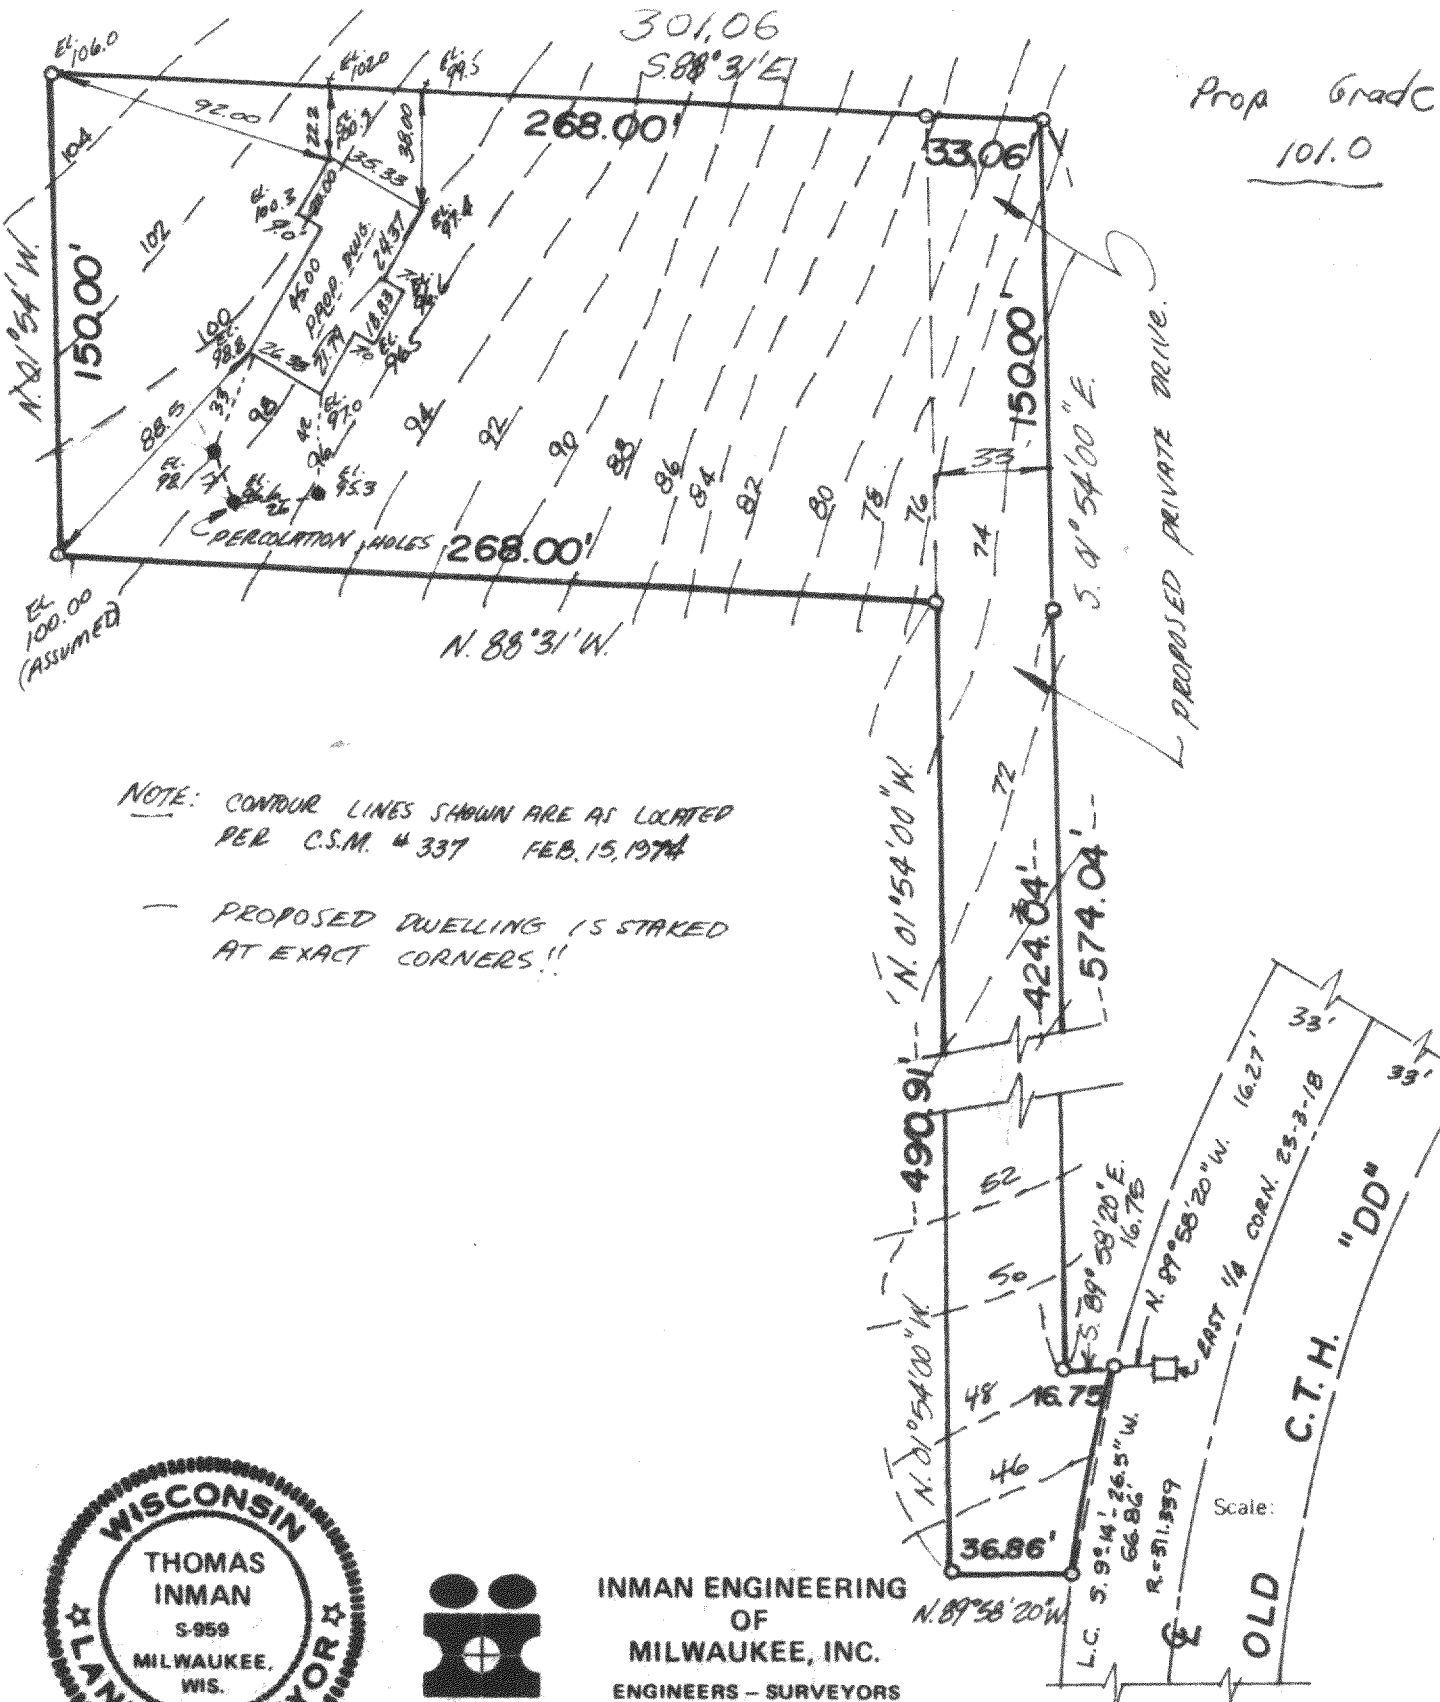

INMAN ENGINEERING
OF
MILWAUKEE, INC.
ENGINEERS - SURVEYORS

SURVEY CERTIFICATE

State of Wisconsin) ss
Milwaukee County I certify that I have surveyed the above described (property) and the above map is a true representation thereof and shows the size and location of the Property, its exterior boundaries, the location and dimensions of all visible structures thereon, fences, apparent easements and roadways and visible encroachments, if any.

This survey is made for the exclusive use of the present owners of the Property, and also those who purchase, mortgage, or guarantee the title thereto within one (1) year from date hereof.

C S 743

C 2 337

DATE: 6/20/75

JOB NO.: 103721

318-144