

PLAT OF SURVEY  
OF

LOT 3, PLEASANT HILLS SUBDIVISION, LOCATED IN THE NORTHEAST 1/4 OF SECTION 22, T. 3 N., R. 18 E. OF THE 4TH P.M.,  
TOWNSHIP OF SPRING PRAIRIE, COUNTY OF WALWORTH, STATE OF WISCONSIN


FOR: FRED DELLABIANCA

SCALE 1" = 50'

o - IRONPIPE STAKE FOUND OR SET AS NOTED ON PLAT  
BEARINGS ARE THOSE OF RECORDED PLAT.


I have surveyed the above-described property, and the map hereon is a true representation thereof and shows the size and location of the property, its exterior boundaries, the location and dimensions of all visible structures thereon, fences, apparent easements and roadways and visible encroachments, if any.

This survey is made for the exclusive use of the present owners of the property, and also those who purchase, mortgage, or guarantee the title thereto, within one year from date hereof.

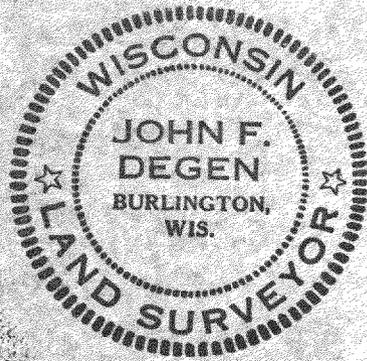

Dated at Burlington, this 20th day  
of AUG, 1976

*John F. Degen*  
John F. Degen, Land Surveyor S. 242

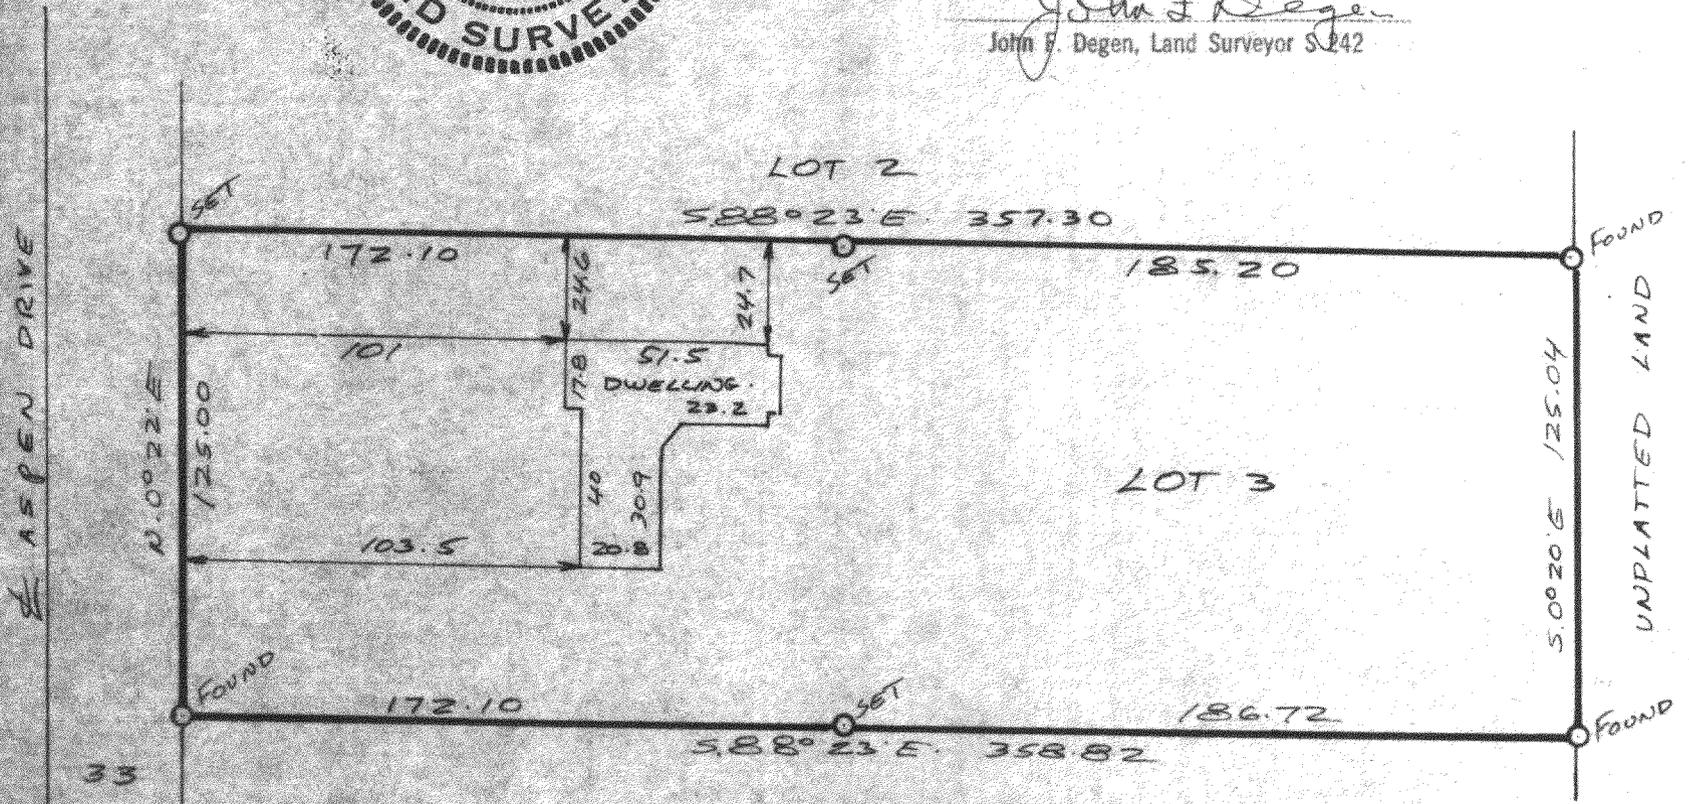

OPH-3  
DRAWER 6-D 8-20-76JFD

318-161