

116 E. CHESTNUT STREET
BURLINGTON, WISCONSIN 53105
PHONE: 414-763-2652

ROBERS & BOYD, INC.
CONSULTING ENGINEERS
LAND SURVEYORS

808 - 43RD STREET
KENOSHA, WISCONSIN 53140
PHONE: 414-838-4488

PLAT OF SURVEY AND HOUSE LOCATION


FOR
DONALD HUNT
OF

Lot 1 of Certified Survey No. 221, as recorded in the Walworth County Register of Deeds Office in Volume 1, page 221 as Document No. 662523.
Said land lying and being in the Town of Spring Prairie, Walworth County, Wisconsin.



-- LEGEND --

- Found 1 1/2" iron pipe
 - Set 1" x 24" iron pipe
- Scale 1" = 40'

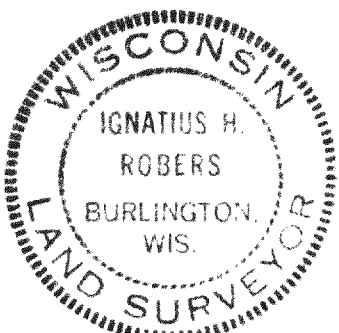

"I CERTIFY THAT I HAVE SURVEYED THE ABOVE DESCRIBED PROPERTY AND THAT THE ABOVE PLAT IS AN ACCURATE SURVEY AND A TRUE REPRESENTATION THEREOF AND CORRECTLY SHOWS THE EXTERIOR BOUNDARY LINES AND LOCATION OF BUILDINGS AND OTHER IMPROVEMENTS ON SAID PROPERTY AND THE CORRECT MEASUREMENTS THEREOF."

Ignatius H. Rober
WISCONSIN REGISTERED LAND SURVEYOR

8-20-76
DATE

76166

JOB NUMBER

