

PLAT OF SURVEY
OF

PART OF THE SOUTHWEST 1/4 OF SECTION 13, T. 3 N., R. 18 E. OF THE 4TH P.M., TOWNSHIP OF SPRING PRAIRIE, COUNTY OF WALWORTH, STATE OF WISCONSIN AND MORE PARTICULARLY DESCRIBED AS FOLLOWS:
COMMENCE AT A STONE MONUMENT AT THE SOUTHWEST CORNER OF SECTION 13, THENCE N. 0°08'30" E., ALONG THE WEST LINE OF SAID QUARTER SECTION, 963.92 FEET TO POTTER ROAD; THENCE N. 88°17' E., ALONG POTTER ROAD, 421.37 FEET; THENCE N. 86°08'18" E., ALONG POTTER ROAD, 256.79 FEET TO THE PLACE OF BEGINNING OF PARCEL OF LAND HEREINAFTER DESCRIBED: THENCE CONTINUE N. 86°08'18" E., ALONG POTTER ROAD, 76.23 FEET; THENCE N. 84°25'23" E., ALONG POTTER ROAD, 224.80 FEET; THENCE N. 5°27' W., 930.53 FEET TO AN IRON PIPE STAKE; THENCE N. 88°26'30" W., 113.84 FEET TO AN IRON PIPE STAKE; THENCE S. 1°47'30" W., 65.90 FEET TO AN IRON PIPE STAKE; THENCE S. 85°51' W., 179.96 FEET TO AN IRON PIPE STAKE; THENCE S. 5°27' E., 881.52 FEET TO THE PLACE OF BEGINNING. CONTAINING 6.246 ACRES OF LAND. SUBJECT TO THE RIGHTS OF THE PUBLIC OVER THE SOUTH SIDE FOR HIGHWAY PURPOSES. CONTAINING 6.018 ACRES OF LAND EXCLUSIVE OF HIGHWAY.

I HEREBY CERTIFY THAT I HAVE SURVEYED THE LAND DESCRIBED ABOVE AND THAT THE PLAT DRAWN HEREON IS A CORRECT REPRESENTATION OF SAID SURVEY.

John F. Degen 4-17-78
JOHN F. DEGEN, LAND SURVEYOR #242
589 N. PINE ST., BURLINGTON, WIS.

SCALE 1" = 50'

o = IRON PIPE STAKE FOUND OR SET AS NOTED




σ = MASONRY NAIL

■ = STONE MONUMENT FOUND.

BEARINGS ARE RELATIVE TO THE WEST LINE OF THE SOUTHWEST 1/4 OF SECTION 13-3-18 WHICH WAS ASSUMED AS N. 0°08'30" E. TO ORIENT WITH OTHER SURVEYS IN AREA.

FOR: FRANCIS LUTHERS.

PASTURE FENCES EXIST AT PLACES OTHER THAN THE LINE S OF THIS SURVEY. THEY EXISTED PRIOR TO THE LAND DEVISION AND ARE NOT INTENDED TO MARK THE LINE OF THIS SURVEY.

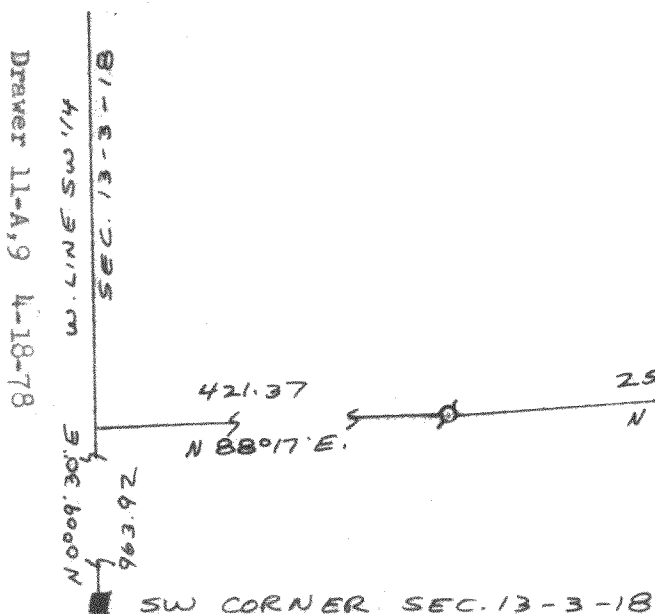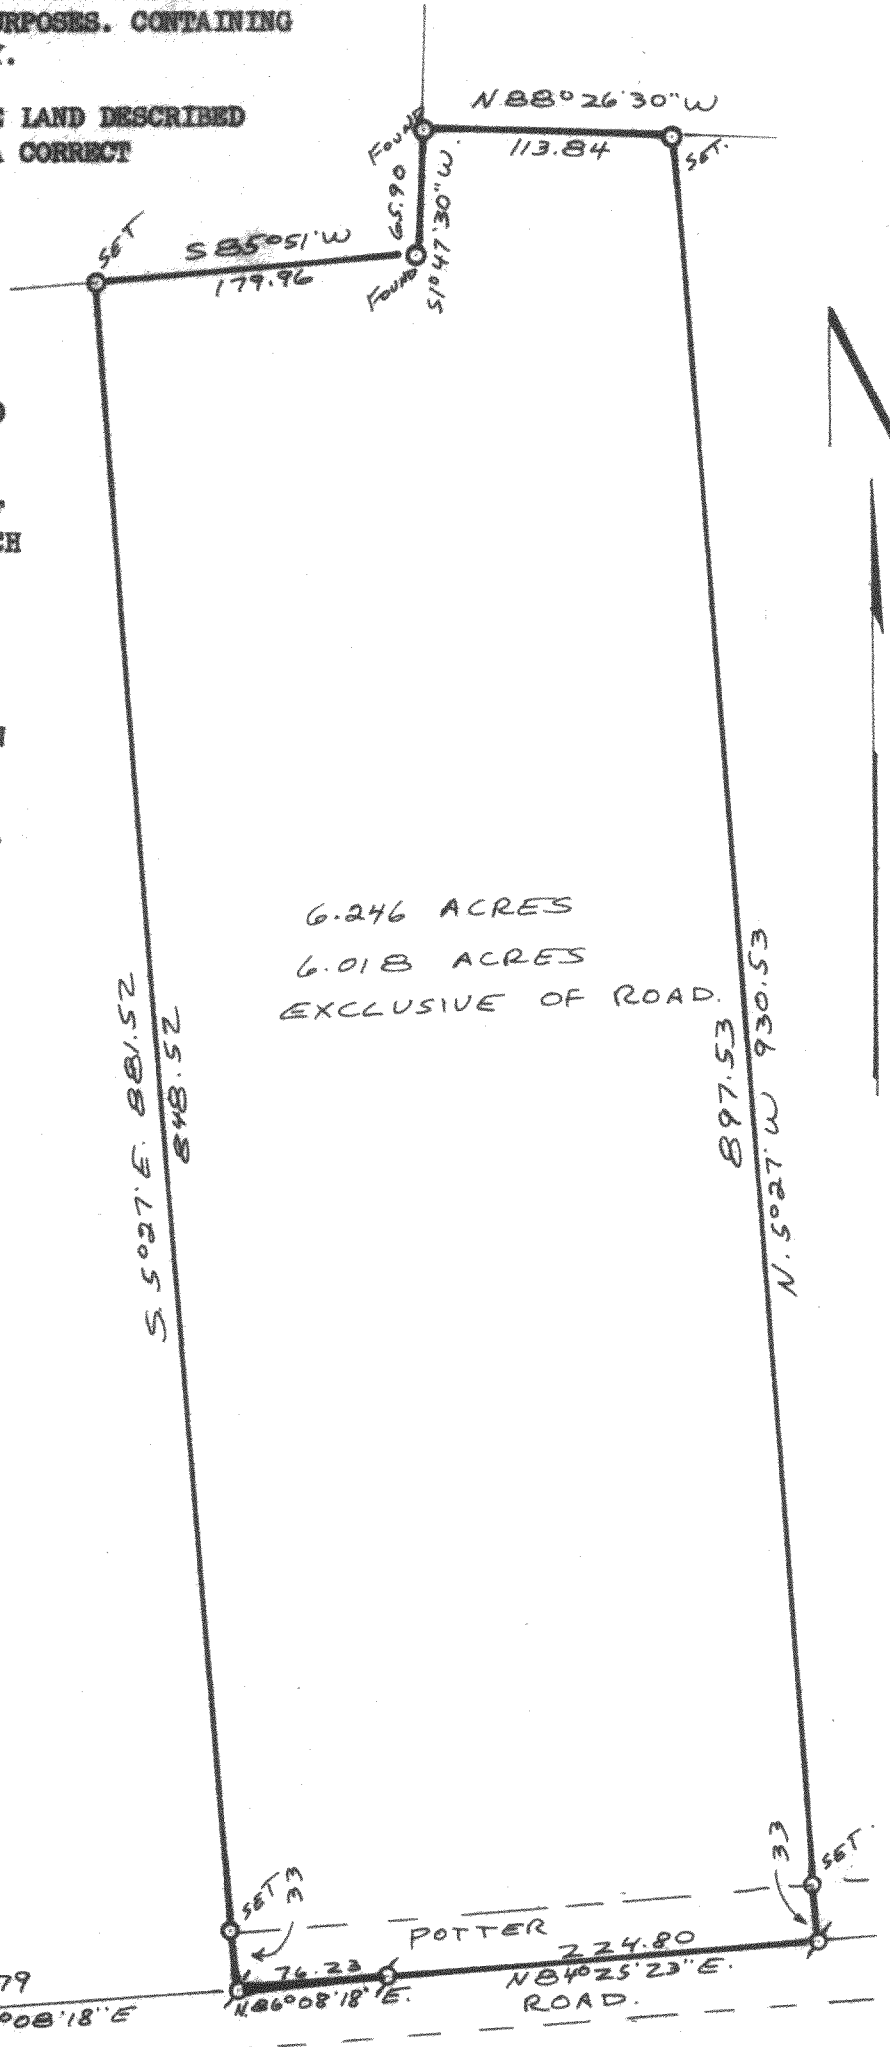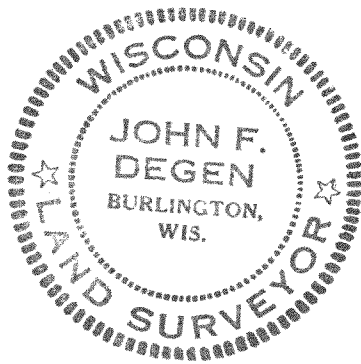

SP-13-5 (part) B18-196