


PLAT OF SURVEY OF A PARCEL
OF LAND LOCATED IN THE NORTHEAST 1/4
OF SECTION 17, T 3 N, R 18 E, TOWN OF SPRING
PRAIRIE, WALWORTH COUNTY, WISCONSIN

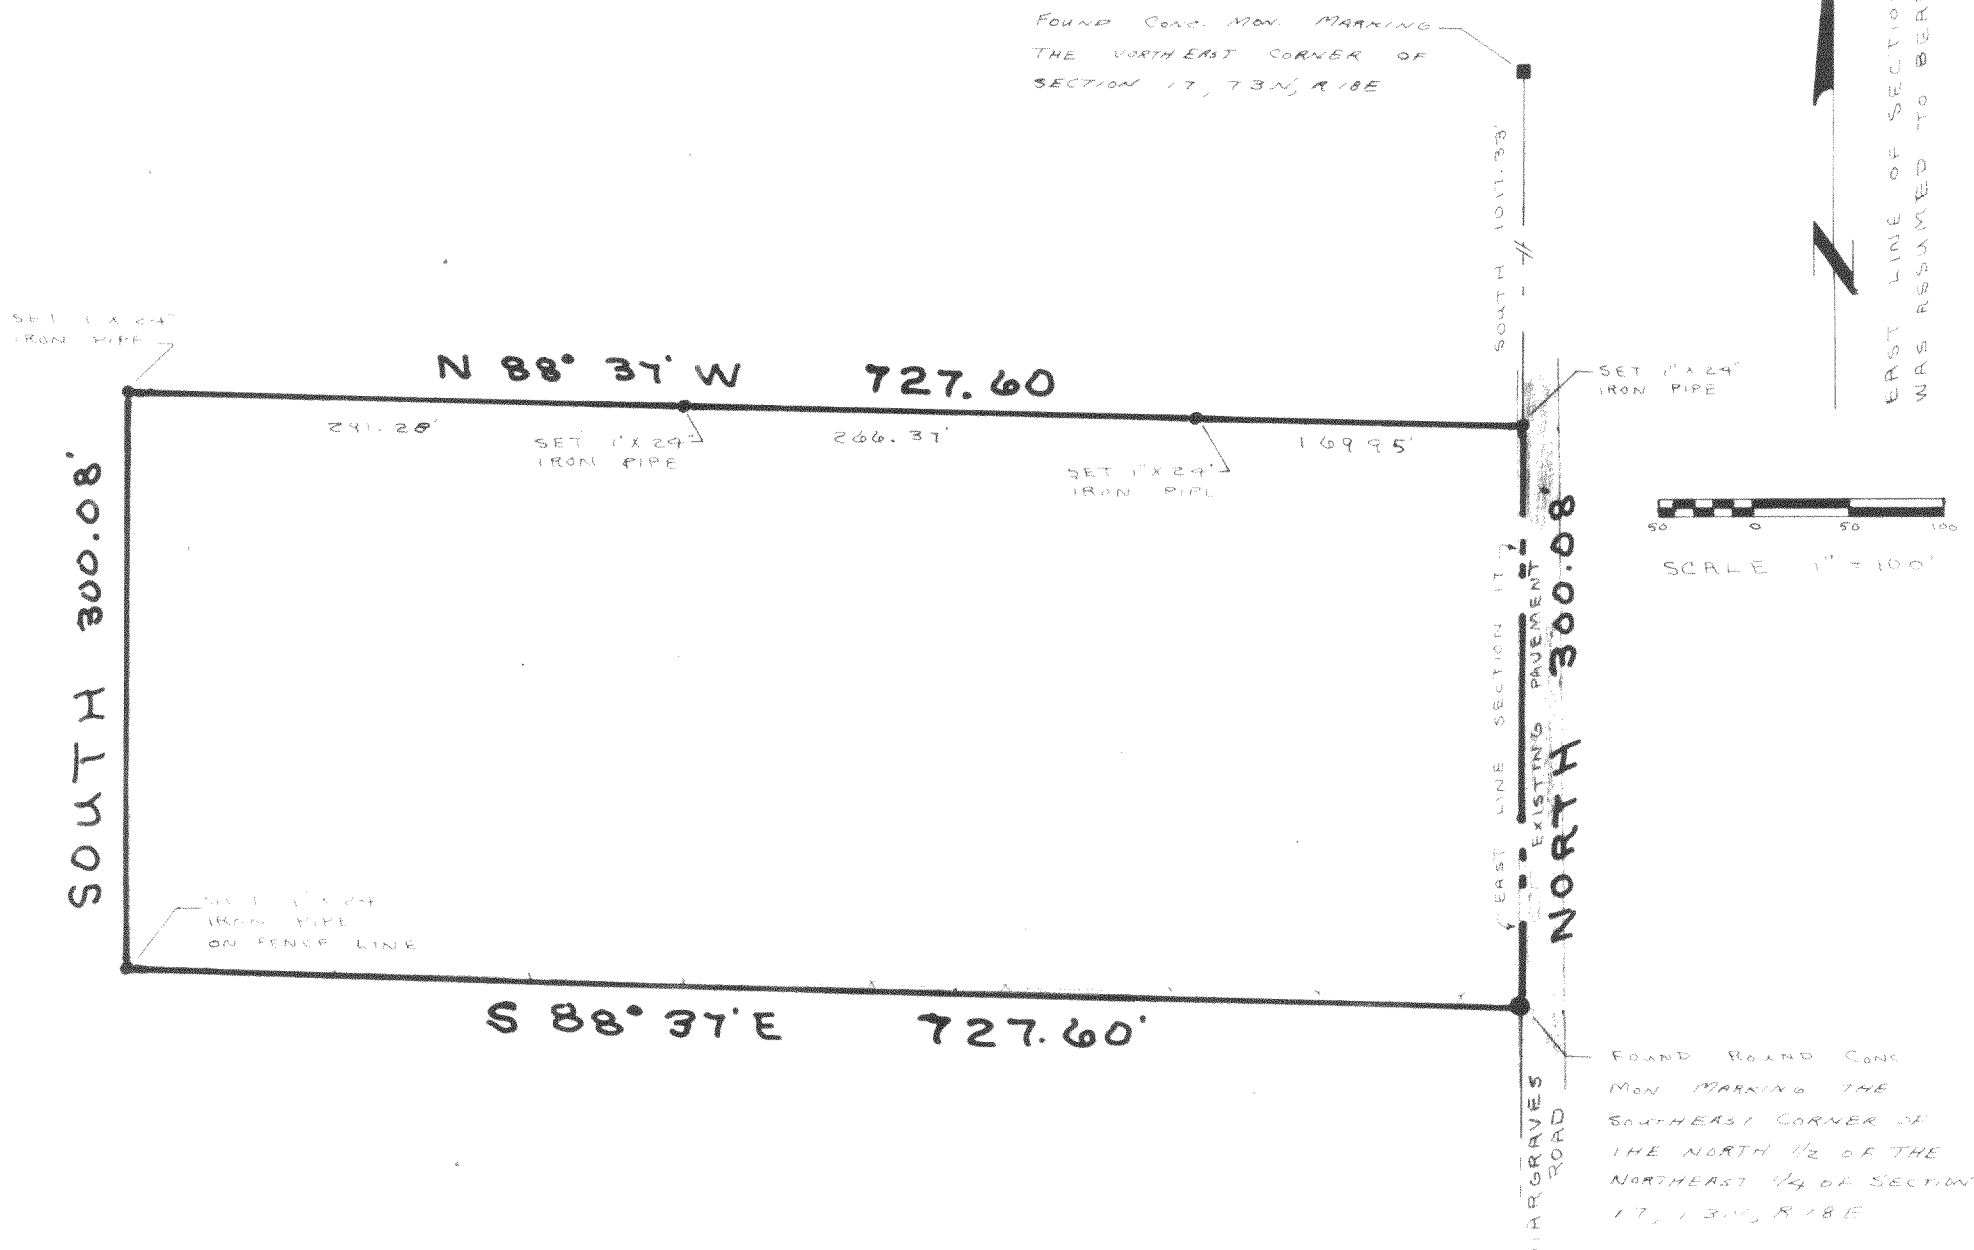

Parcel of land located in the Northeast 1/4 of Section 17, Town 3 North, Range 18 East, Town of Spring Prairie, Walworth County, Wisconsin, more particularly described as follows: Commencing at as concrete monument marking the Northeast Corner of said section 17; thence South 1017.33 feet along the East line of said section 17 to an iron pipe and the point of beginning; thence N 88° 37' W 727.60 feet to an iron pipe; thence South 300.08 feet more or less to the South line of the North 1/2 of the Northeast 1/4 of said section 17; thence Easterly 727.60 feet along the South line of the North 1/2 of the Northeast 1/4 of said section 17 to a concrete monument marking the Southeast corner of the North 1/2 of the North 1/4 of said section 17; thence North 300.08 feet along the East line of said section 17 to the point of beginning, containing 5.01 acres, more or less.


I hereby certify that the property hereon described has been surveyed under my direction and that this Plat of Survey is a true and accurate representation of the property to the best of my knowledge and belief.

Robert A. Farris
Robert A. Farris
Surveyor S-1293

Dated this 22th day of July, 1978.

Zoned: C-2 Ppland Resource Conservation District

Surveyed For: Bob Atkinson

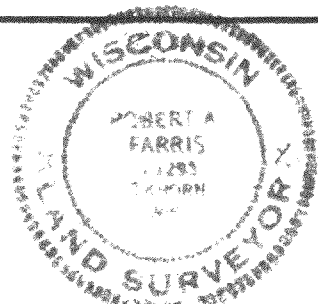

FARRIS, HANSEN & COOPER, INC.
ENGINEERING, SURVEYING AND LAND PLANNING
715 W. WALWORTH ST. - P.O. BOX 487 ELKHORN, WI 53121
PHONE 414-723-2008

DRAWING NO. 1351

05017-14

SP-17-1A

318-204