

PLAT OF SURVEY
OF



LOT 1 OF WALWORTH COUNTY CERTIFIED SURVEY MAP NO. 377, FOR LANDS LOCATED IN THE WEST HALF OF SECTION 14, T. 3 N., R. 18 E. OF THE 4TH P.M., TOWNSHIP OF SPRING PRAIRIE, COUNTY OF WALWORTH, STATE OF WISCONSIN.

FOR: CENTURY 21 - MUELLER REALTY

o = IRON PIPE STAKE FOUND.

SCALE 1" = 60'

BEARINGS ARE THOSE OF CSM PLAT.

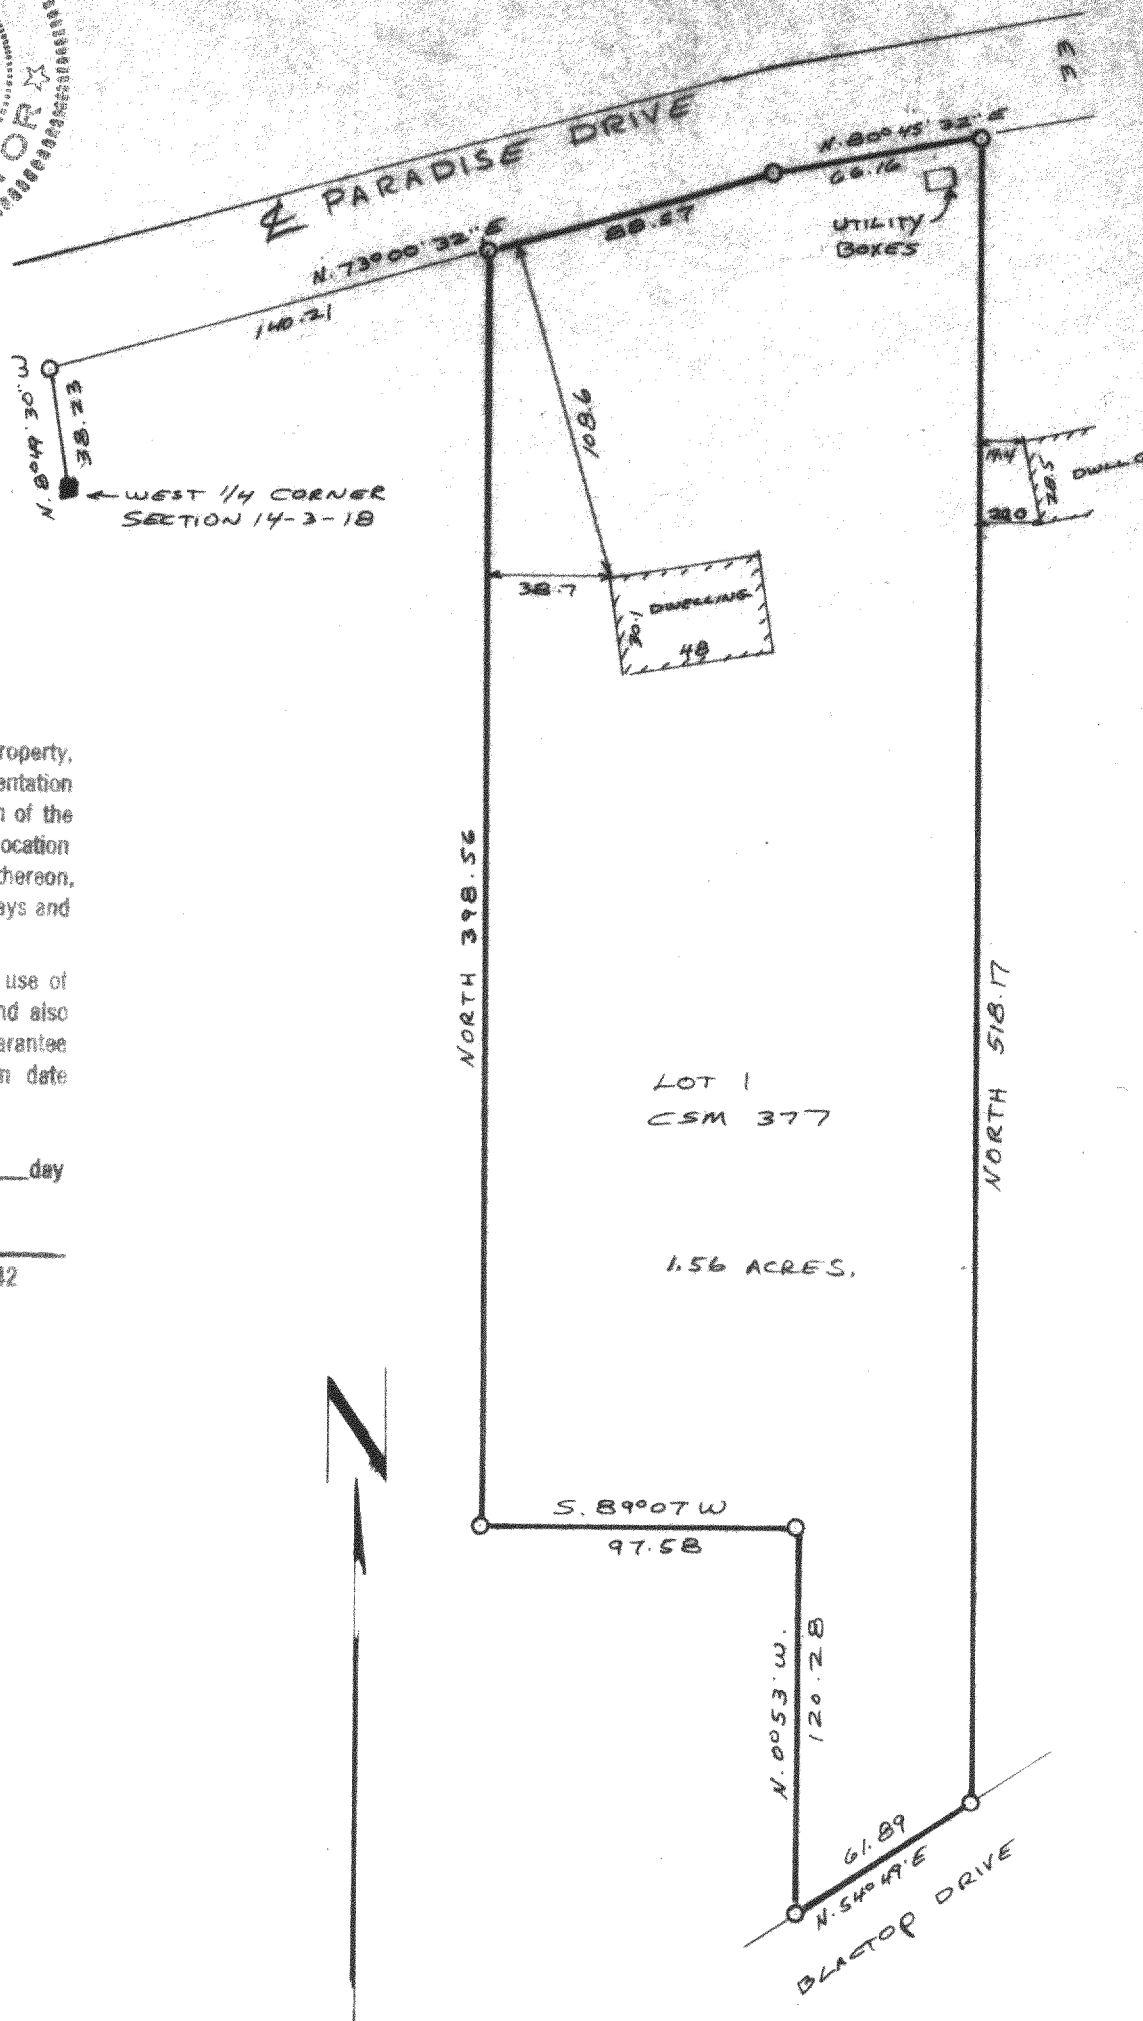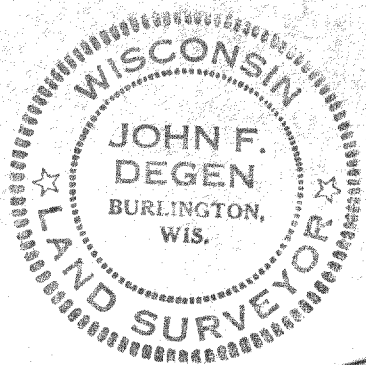

I have surveyed the above-described property, and the map hereon is a true representation thereof and shows the size and location of the property, its exterior boundaries, the location and dimensions of all visible structures thereon, fences, apparent easements and roadways and visible encroachments, if any.

This survey is made for the exclusive use of the present owners of the property, and also those who purchase, mortgage, or guarantee the title thereto, within one year from date hereof.

Dated at Burlington, this 5TH day

of OCTOBER, 1984

John F. Degen

John F. Degen, Land Surveyor S 242



318-248

OA 377-1