

PLAT OF SURVEY
OF


LOT 2 OF WALWORTH COUNTY CERTIFIED SURVEY MAP NO. 298, FOR LANDS LOCATED IN SECTION 14,
T. 3 N., R. 18 E. OF THE 4TH P.M., TOWNSHIP OF SPRING PRAIRIE, WALWORTH COUNTY, WISCONSIN.

FOR: RUTH FOLIEZ PAKO - SELLER
THOMAS LOF - BUYER

SCALE 1" = 50'

o = IRON PIPE STAKE FOUND

BEARING DATUM IS THAT OF
RECORDED CSM.


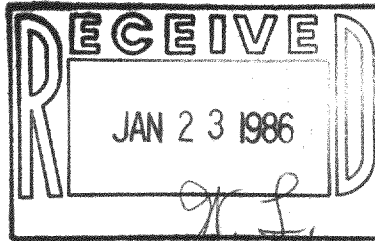


I have surveyed the above-described property,
and the map hereon is a true representation
thereof and shows the size and location of the
property, its exterior boundaries, the location
and dimensions of all visible structures thereon,
fences, apparent easements and roadways and
visible encroachments, if any.

This survey is made for the exclusive use of
the present owners of the property, and also
those who purchase, mortgage, or guarantee
the title thereto, within one year from date
hereof.

Dated at Burlington, this 10th day
of DECEMBER, 1985

John F. Degen
John F. Degen, Land Surveyor S 242

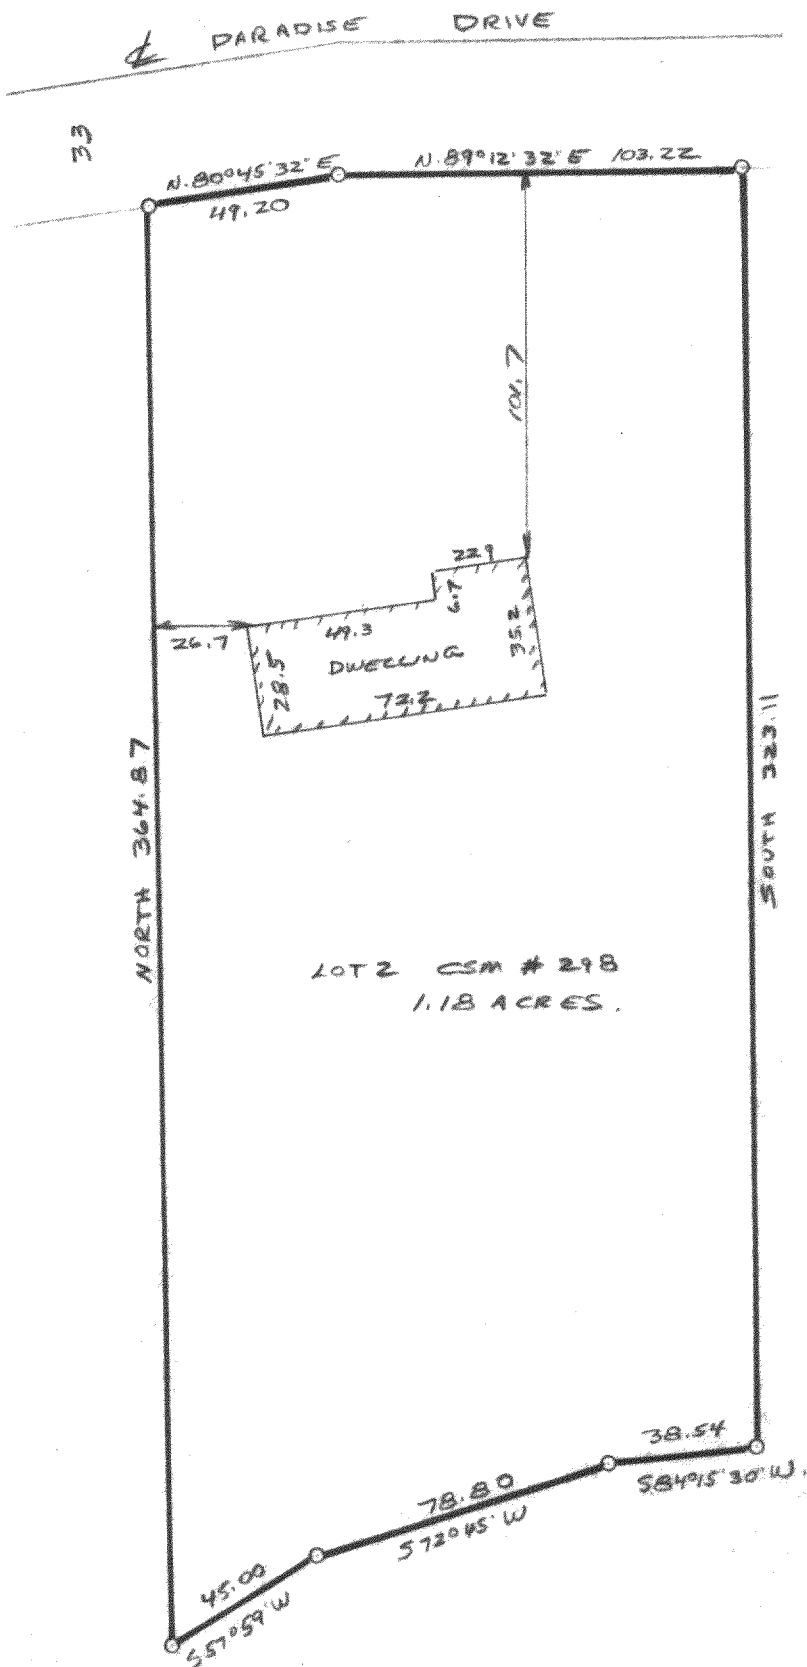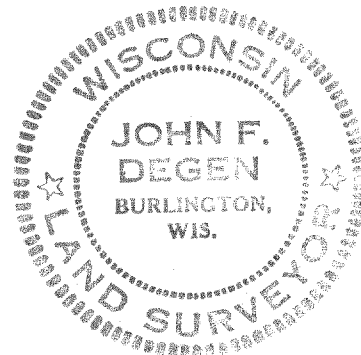

274 E-D-1A