

PLAT OF SURVEY
OF




LOT 1 OF WALWORTH COUNTY CERTIFIED SURVEY MAP NO. 298 FOR LANDS LOCATED IN THE SW 1/4 OF THE NW 1/4 AND IN THE NW 1/4 OF THE SW 1/4 ALL IN SECTION 14, T. 3 N., R. 18 E. TOWN OF SPRING PRAIRIE, WALWORTH COUNTY, WISCONSIN.

FOR: HARRY VAN-DER-STERREN

SCALE 1" = 60'

o = IRON PIPE STAKE FOUND

BEARING DATUM IS THAT OF CSM NO. 298

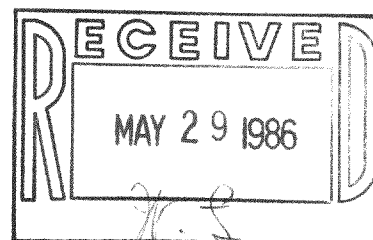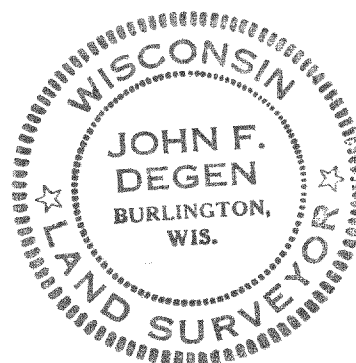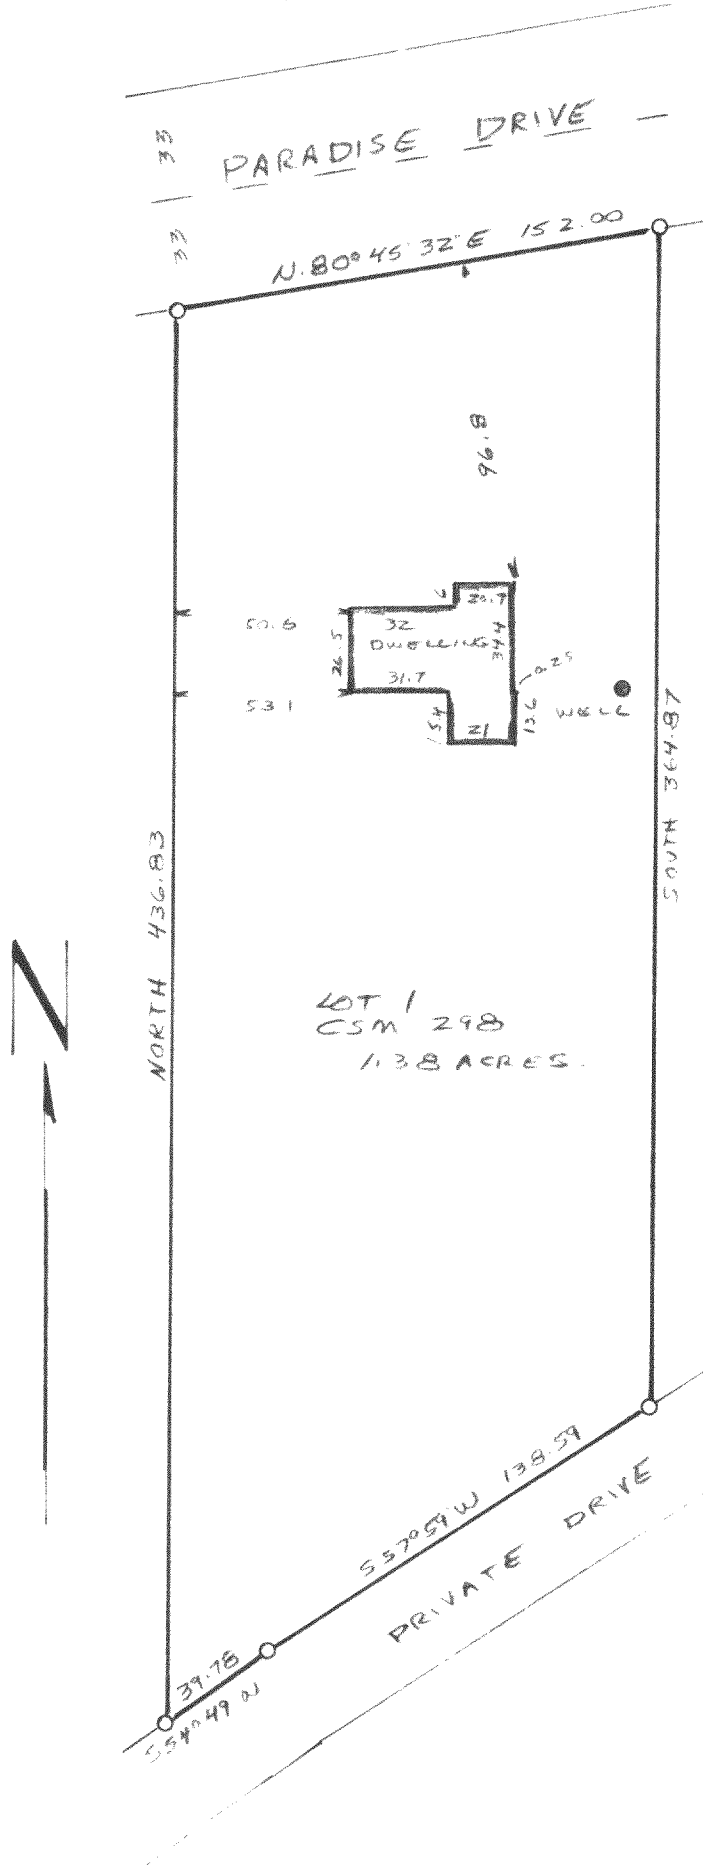

I have surveyed the above described property, and the map hereon is a true representation thereof and shows the size and location of the property, its extent, and the location and dimensions of all buildings thereon, fences, appurtenant roads, and all visible encumbrances.

This survey is made for the exclusive use of the present owner of the property, and also those who purchase the same, and I guarantee the title thereto within one year from date hereof.

Witness my hand at Burlington, this 29th day of APRIL 1986.
John F. Degen
John F. Degen, Land Surveyor S 242

318-268

11-C #15