

PLAT OF SURVEY

1835 OF

LOT 1 OF WALWORTH COUNTY CERTIFIED SURVEY MAP NO. 1255, RECORDED IN VOL. 5 OF CERTIFIED SURVEYS ON PAGE 330, AND LOCATED IN THE NORTHWEST 1/4 OF SECTION 29, T. 3 N., R. 18 E. OF THE 4TH P.M., TOWNSHIP OF SPRING PRAIRIE, COUNTY OF WALWORTH, STATE OF WISCONSIN.


FOR: ZESS - SELLER

PRZYBYLINSKI - BUYER.

SCALE 1" = 60'

o = IRON PIPE STAKE FOUND.

BEARING DATUM IS THAT OF RECORDED CSM.

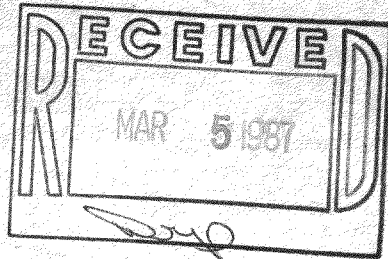

I have surveyed the above-described property, and the map hereon is a true representation thereof and shows the size and location of the property, its exterior boundaries, the location and dimensions of all visible structures thereon, fences, apparent easements and roadways and visible encroachments, if any.

This survey is made for the exclusive use of the present owners of the property, and also those who purchase, mortgage, or guarantee the title thereto, within one year from date hereof.

Dated at Burlington, this 20th day of JANUARY, 1987.

John F. Degan
John F. Degan, Land Surveyor 5-482

